

# **National Grid SA-COA**

## **PRODUCTION FILE**

**Contractor : ABB Contracting Co.**

**Project : SS 8709- 132/13.8kV in Alkharj City**

**Contract No : 11131113/00**

**Substation : 8709**

**Subject : 132/13.8Kv Transformer GT-1 (+R05.1)  
Relay panel-1**

**ABB**

# **National Grid SA-COA**

## **PRODUCTION FILE**

**Contractor : ABB Contracting Co.**





**Project : SS 8709- 132/13.8kV in Alkharj City**


**Contract No : 11131113/00**

**Substation : 8709**

**Subject : 132/13.8Kv Transformer GT-1 (+R05.2)  
Relay panel-2**



	1	2	3	4	5	6	7	8	9	10																																																																																										
A			POWER SYSTEMS NETWORK MANAGEMENT PROTECTION AND SUBSTATION AUTOMATION SYSTEMS WBS NO: S-13656					ABB AUTOMATION COMPANY LTD., 414, AL-KHARJ ROAD SECOND INDUSTRIAL CITY RIYADH-11383 K.S.A																																																																																												
B																																																																																																				
C	CONTRACTOR : ABB Contracting Company																																																																																																			
	CLIENT : National GridSA																																																																																																			
D	PROJECT : CONSTRUCTION OF NEW 132/13.8kV SS 8709 IN AL-KHARJ CITY																																																																																																			
	SUBSTATION : S/S 8709																																																																																																			
E	CONTRACT NO. : 11131113/00																																																																																																			
	TITLE : Assembly Drawing – +R05.1 [GT-1]																																																																																																			
F																																																																																																				
G	<table><tr><td colspan="3">AS-BUILT BY _____ DATE _____</td><td colspan="2">CONTRACT NO. 11131113/00</td><td colspan="2">JOB ORDER NO. S-13656</td><td colspan="3">COVER SHEET</td><td colspan="2"> <b>نقل الكهرباء</b> الشركة الوطنية لنقل الكهرباء National Grid SA</td></tr><tr><td>01</td><td>13 49</td><td>FACTORY ASBUILT</td><td colspan="3">DRAWN BY RIZ</td><td colspan="3">CHECKED BY JKR</td><td colspan="3">132/13.8kV GT-1 RELAY PANEL-1 +R05.1</td></tr><tr><td>00</td><td>13 04</td><td>FOR APPROVAL</td><td colspan="3">DATE STARTED 24.01.2013</td><td colspan="3">DATE COMPLETED</td><td colspan="3">S/S 8709-132/13.8KV IN AL-KHARJ CITY</td></tr><tr><td>REV. NO.</td><td>DATE</td><td>DESCRIPTION</td><td colspan="3">OPRG. DEPT. CTPD</td><td colspan="3">ENG. DEPT. AUT-PSAC</td><td colspan="3">RIYADH SAUDI ARABIA</td></tr><tr><td colspan="3"></td><td colspan="3"></td><td colspan="3"></td><td>INDEX</td><td>PLANT NO.</td><td>DRAWING NUMBER</td><td>SHEET NO.</td><td>REV. NO.</td></tr><tr><td colspan="3"></td><td colspan="3"></td><td colspan="3"></td><td>-</td><td>C421</td><td>CD-322926</td><td>G00</td><td>G01</td></tr><tr><td colspan="3"></td><td colspan="3"></td><td colspan="3"></td><td colspan="3"></td><td>01</td><td></td></tr></table>										AS-BUILT BY _____ DATE _____			CONTRACT NO. 11131113/00		JOB ORDER NO. S-13656		COVER SHEET			 <b>نقل الكهرباء</b> الشركة الوطنية لنقل الكهرباء National Grid SA		01	13 49	FACTORY ASBUILT	DRAWN BY RIZ			CHECKED BY JKR			132/13.8kV GT-1 RELAY PANEL-1 +R05.1			00	13 04	FOR APPROVAL	DATE STARTED 24.01.2013			DATE COMPLETED			S/S 8709-132/13.8KV IN AL-KHARJ CITY			REV. NO.	DATE	DESCRIPTION	OPRG. DEPT. CTPD			ENG. DEPT. AUT-PSAC			RIYADH SAUDI ARABIA												INDEX	PLANT NO.	DRAWING NUMBER	SHEET NO.	REV. NO.										-	C421	CD-322926	G00	G01													01	
AS-BUILT BY _____ DATE _____			CONTRACT NO. 11131113/00		JOB ORDER NO. S-13656		COVER SHEET			 <b>نقل الكهرباء</b> الشركة الوطنية لنقل الكهرباء National Grid SA																																																																																										
01	13 49	FACTORY ASBUILT	DRAWN BY RIZ			CHECKED BY JKR			132/13.8kV GT-1 RELAY PANEL-1 +R05.1																																																																																											
00	13 04	FOR APPROVAL	DATE STARTED 24.01.2013			DATE COMPLETED			S/S 8709-132/13.8KV IN AL-KHARJ CITY																																																																																											
REV. NO.	DATE	DESCRIPTION	OPRG. DEPT. CTPD			ENG. DEPT. AUT-PSAC			RIYADH SAUDI ARABIA																																																																																											
									INDEX	PLANT NO.	DRAWING NUMBER	SHEET NO.	REV. NO.																																																																																							
									-	C421	CD-322926	G00	G01																																																																																							
												01																																																																																								

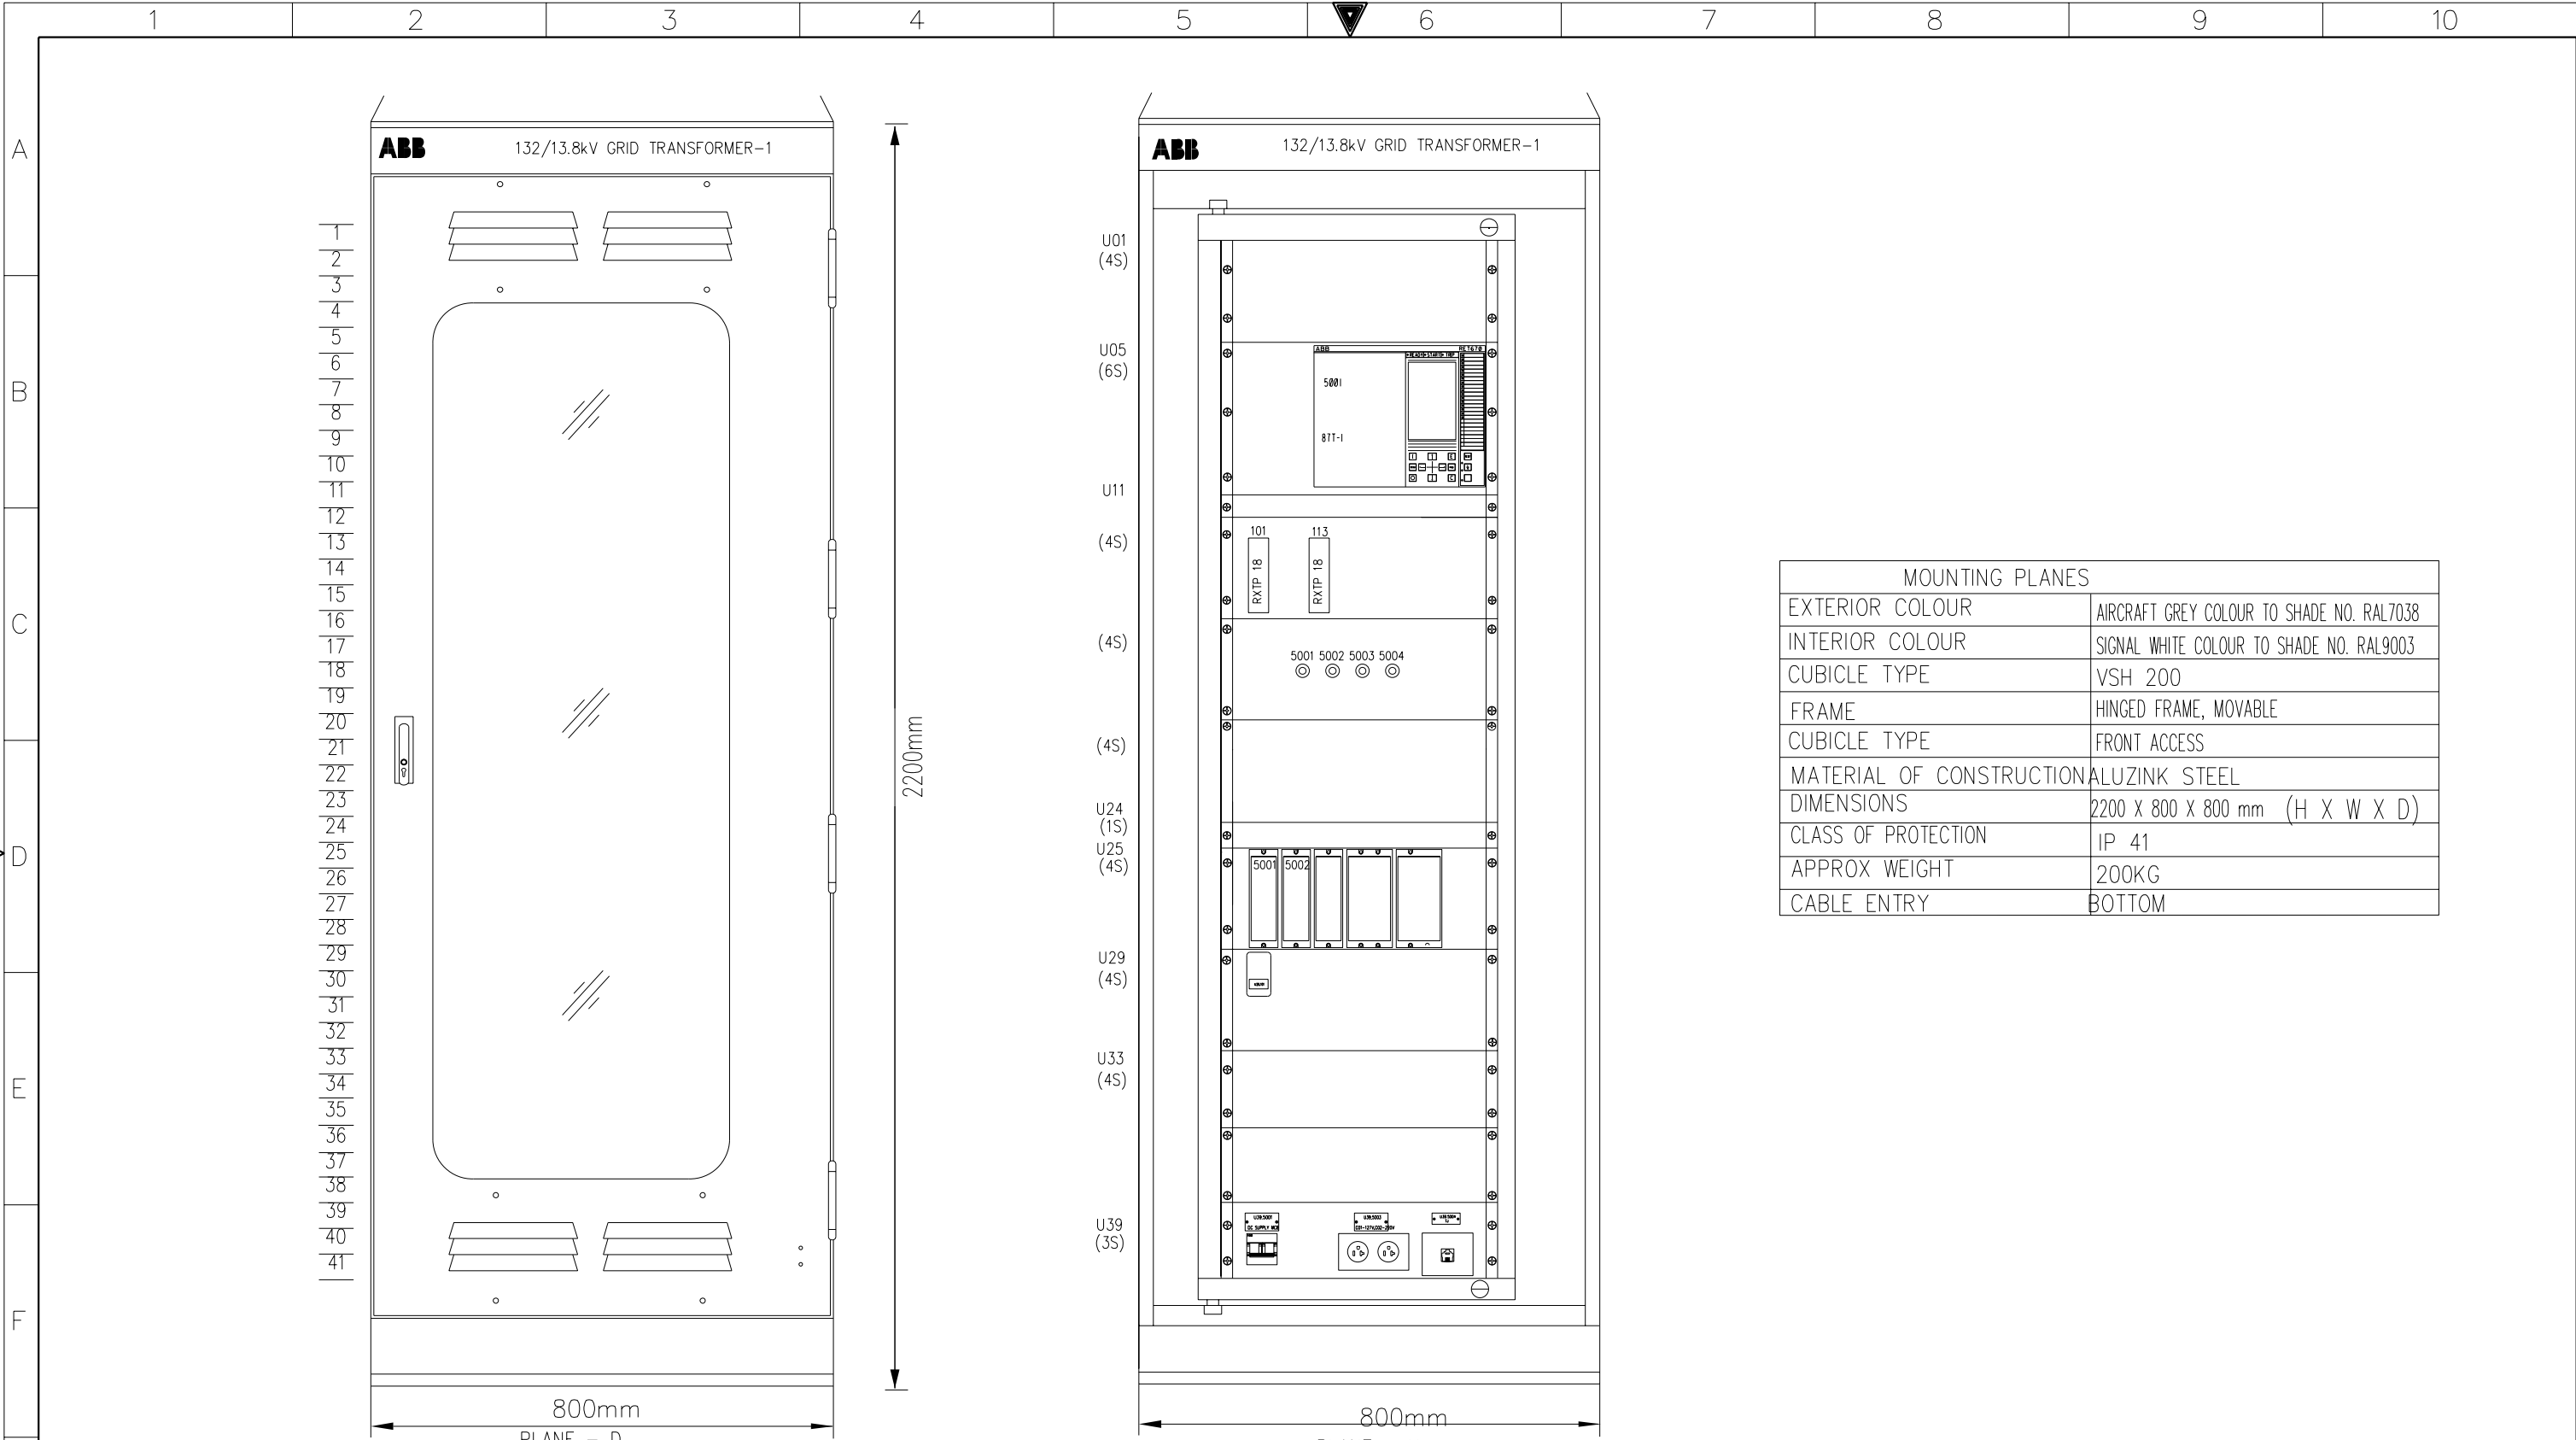


AS-BUILT BY \_\_\_\_\_ DATE \_\_\_\_\_ CONTRACT NO. 11131113/00 JOB ORDER NO. S-13656

01	13 49	FACTORY ASBUILT	DRAWN BY RIZ	CHECKED BY JKR
00	13 04	FOR APPROVAL	DATE STARTED 24.01.2013	DATE COMPLETED _____
REV. NO.	DATE	DESCRIPTION	OPRG. DEPT. CTPD	ENG. DEPT. AUT-PSAC

ASSEMBLY DRAWING  
132/13.8kV GT-1 RELAY PANEL-1 +R05.1  
S/S 8709-132/13.8KV IN AL-KHARJ CITY  
RIYADH SAUDI ARABIA

الشركة الوطنية لنقل الكهرباء			 نقل الكهرباء National Grid SA		
INDEX	PLANT NO.	DRAWING NUMBER	SHEET NO.		REV. NO.
-	C421	CD-322926	SHT	CONT.	01
			G01	G02	

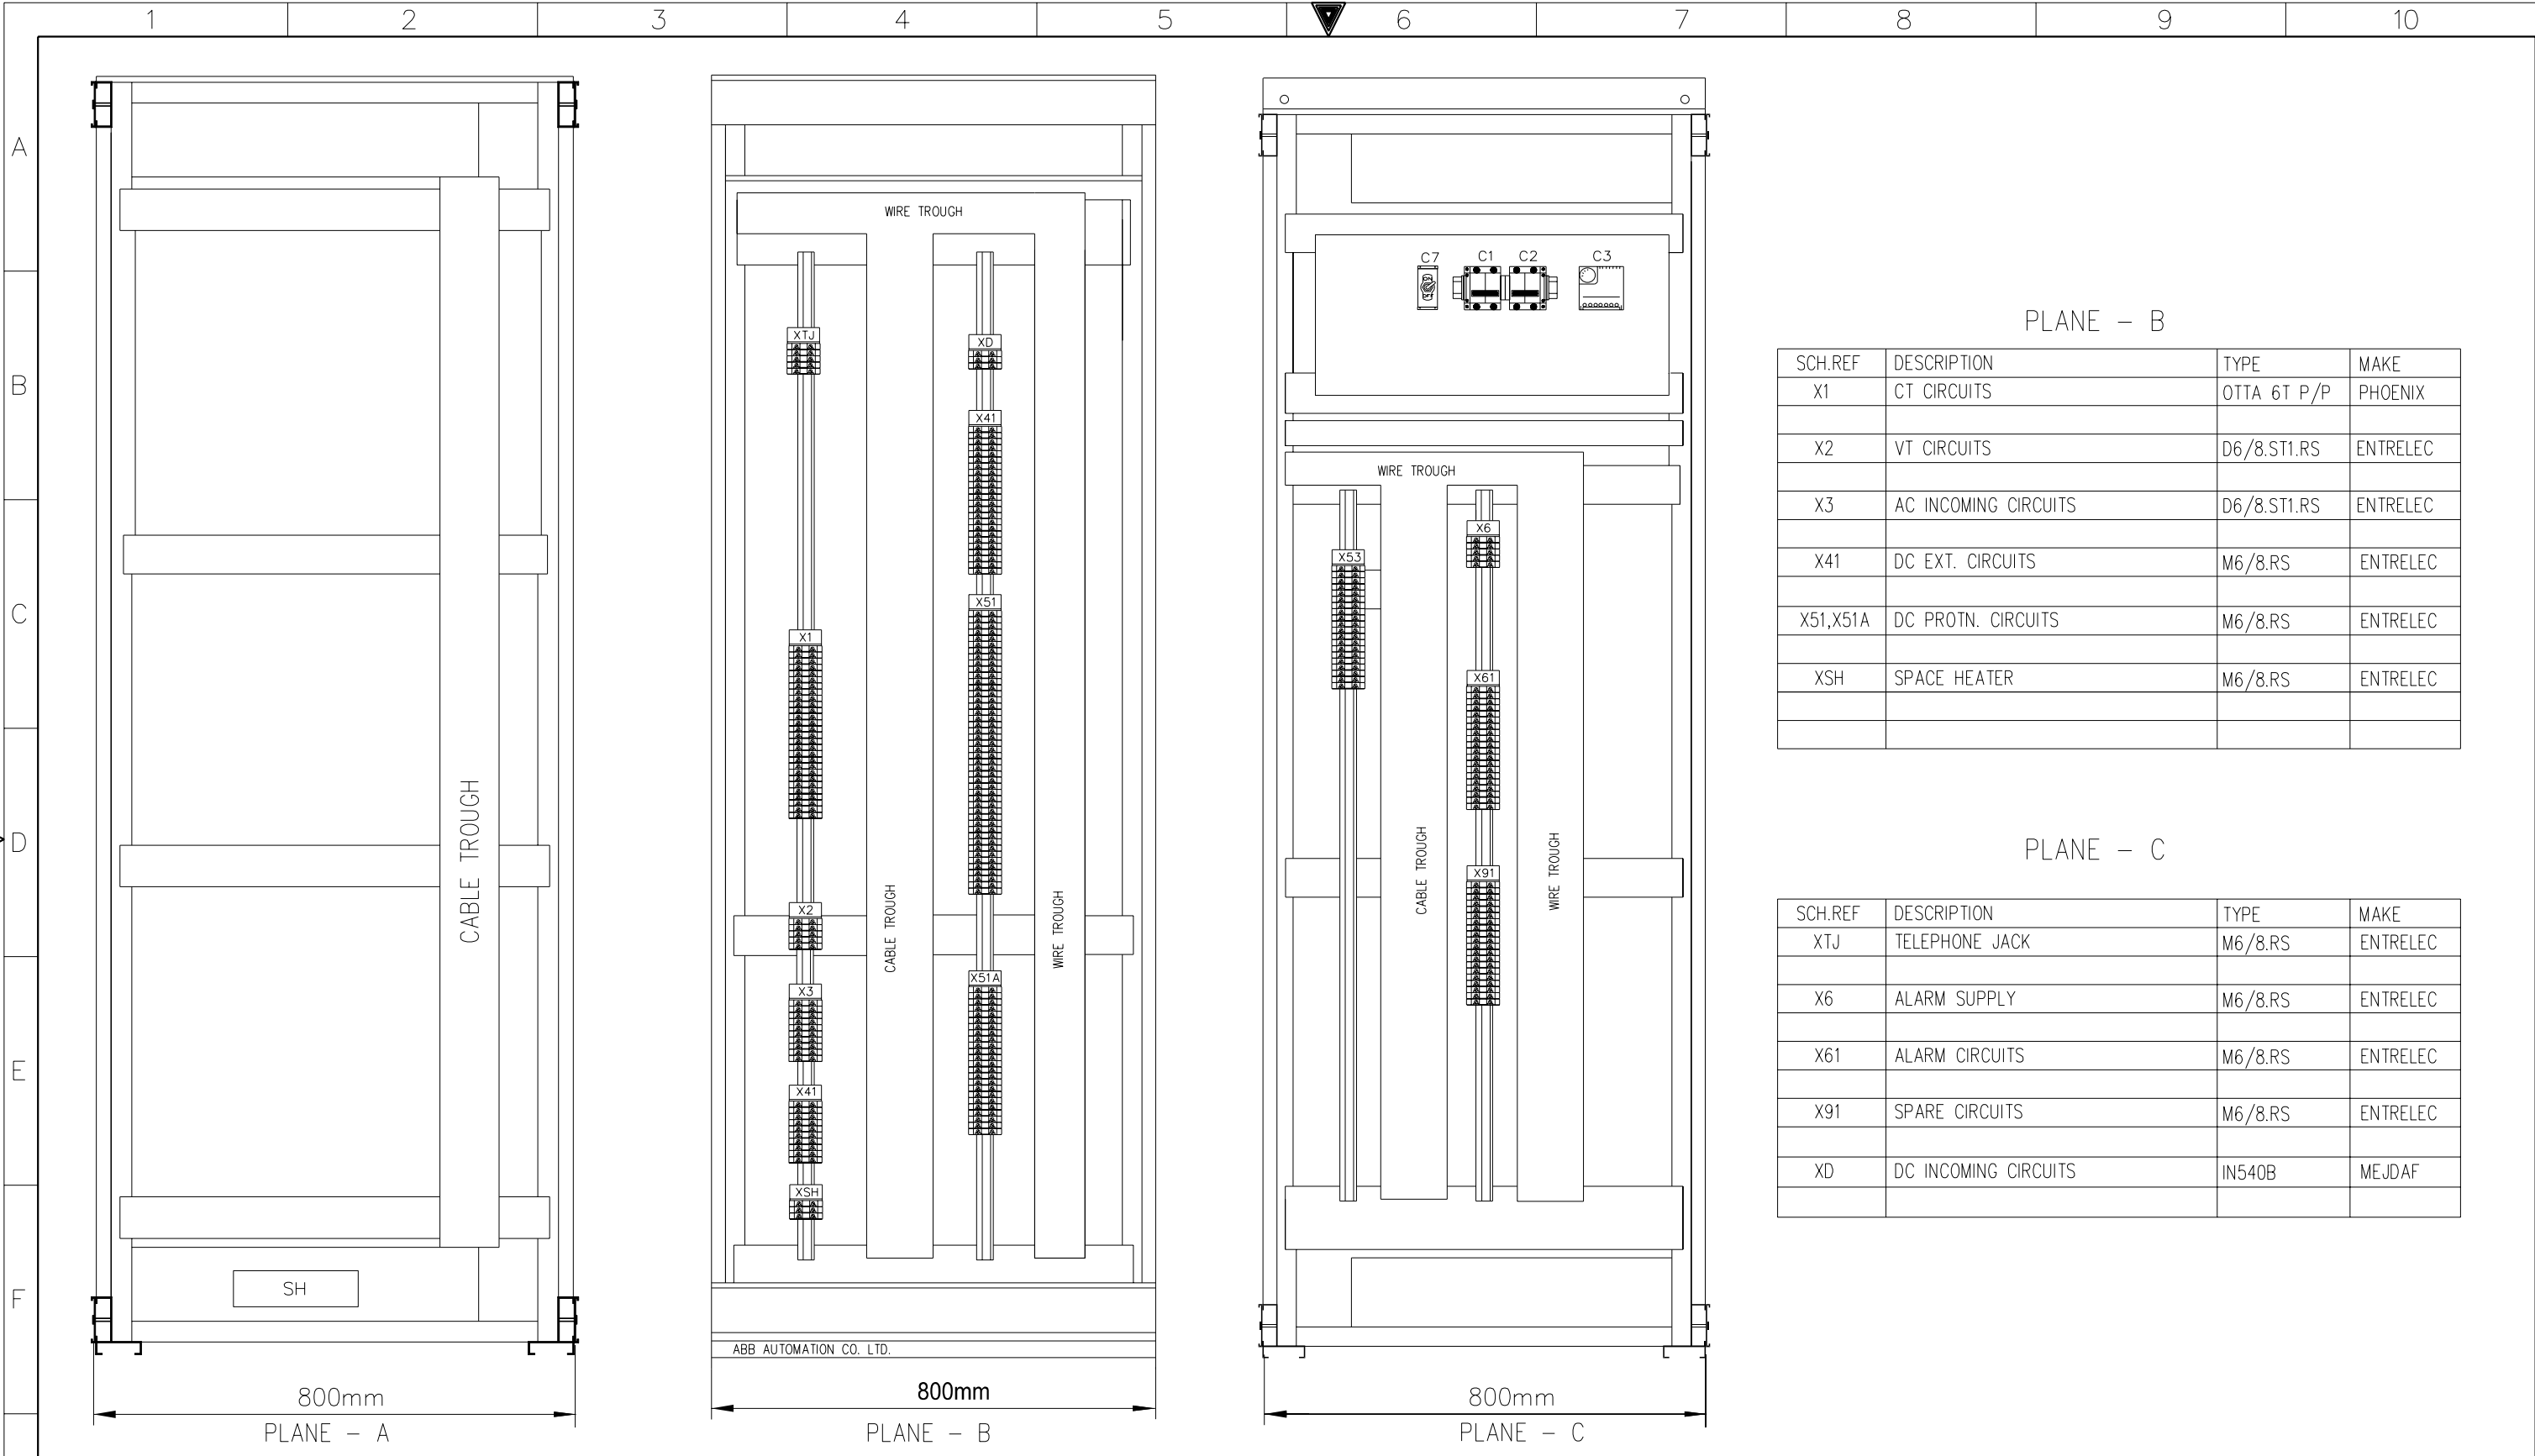


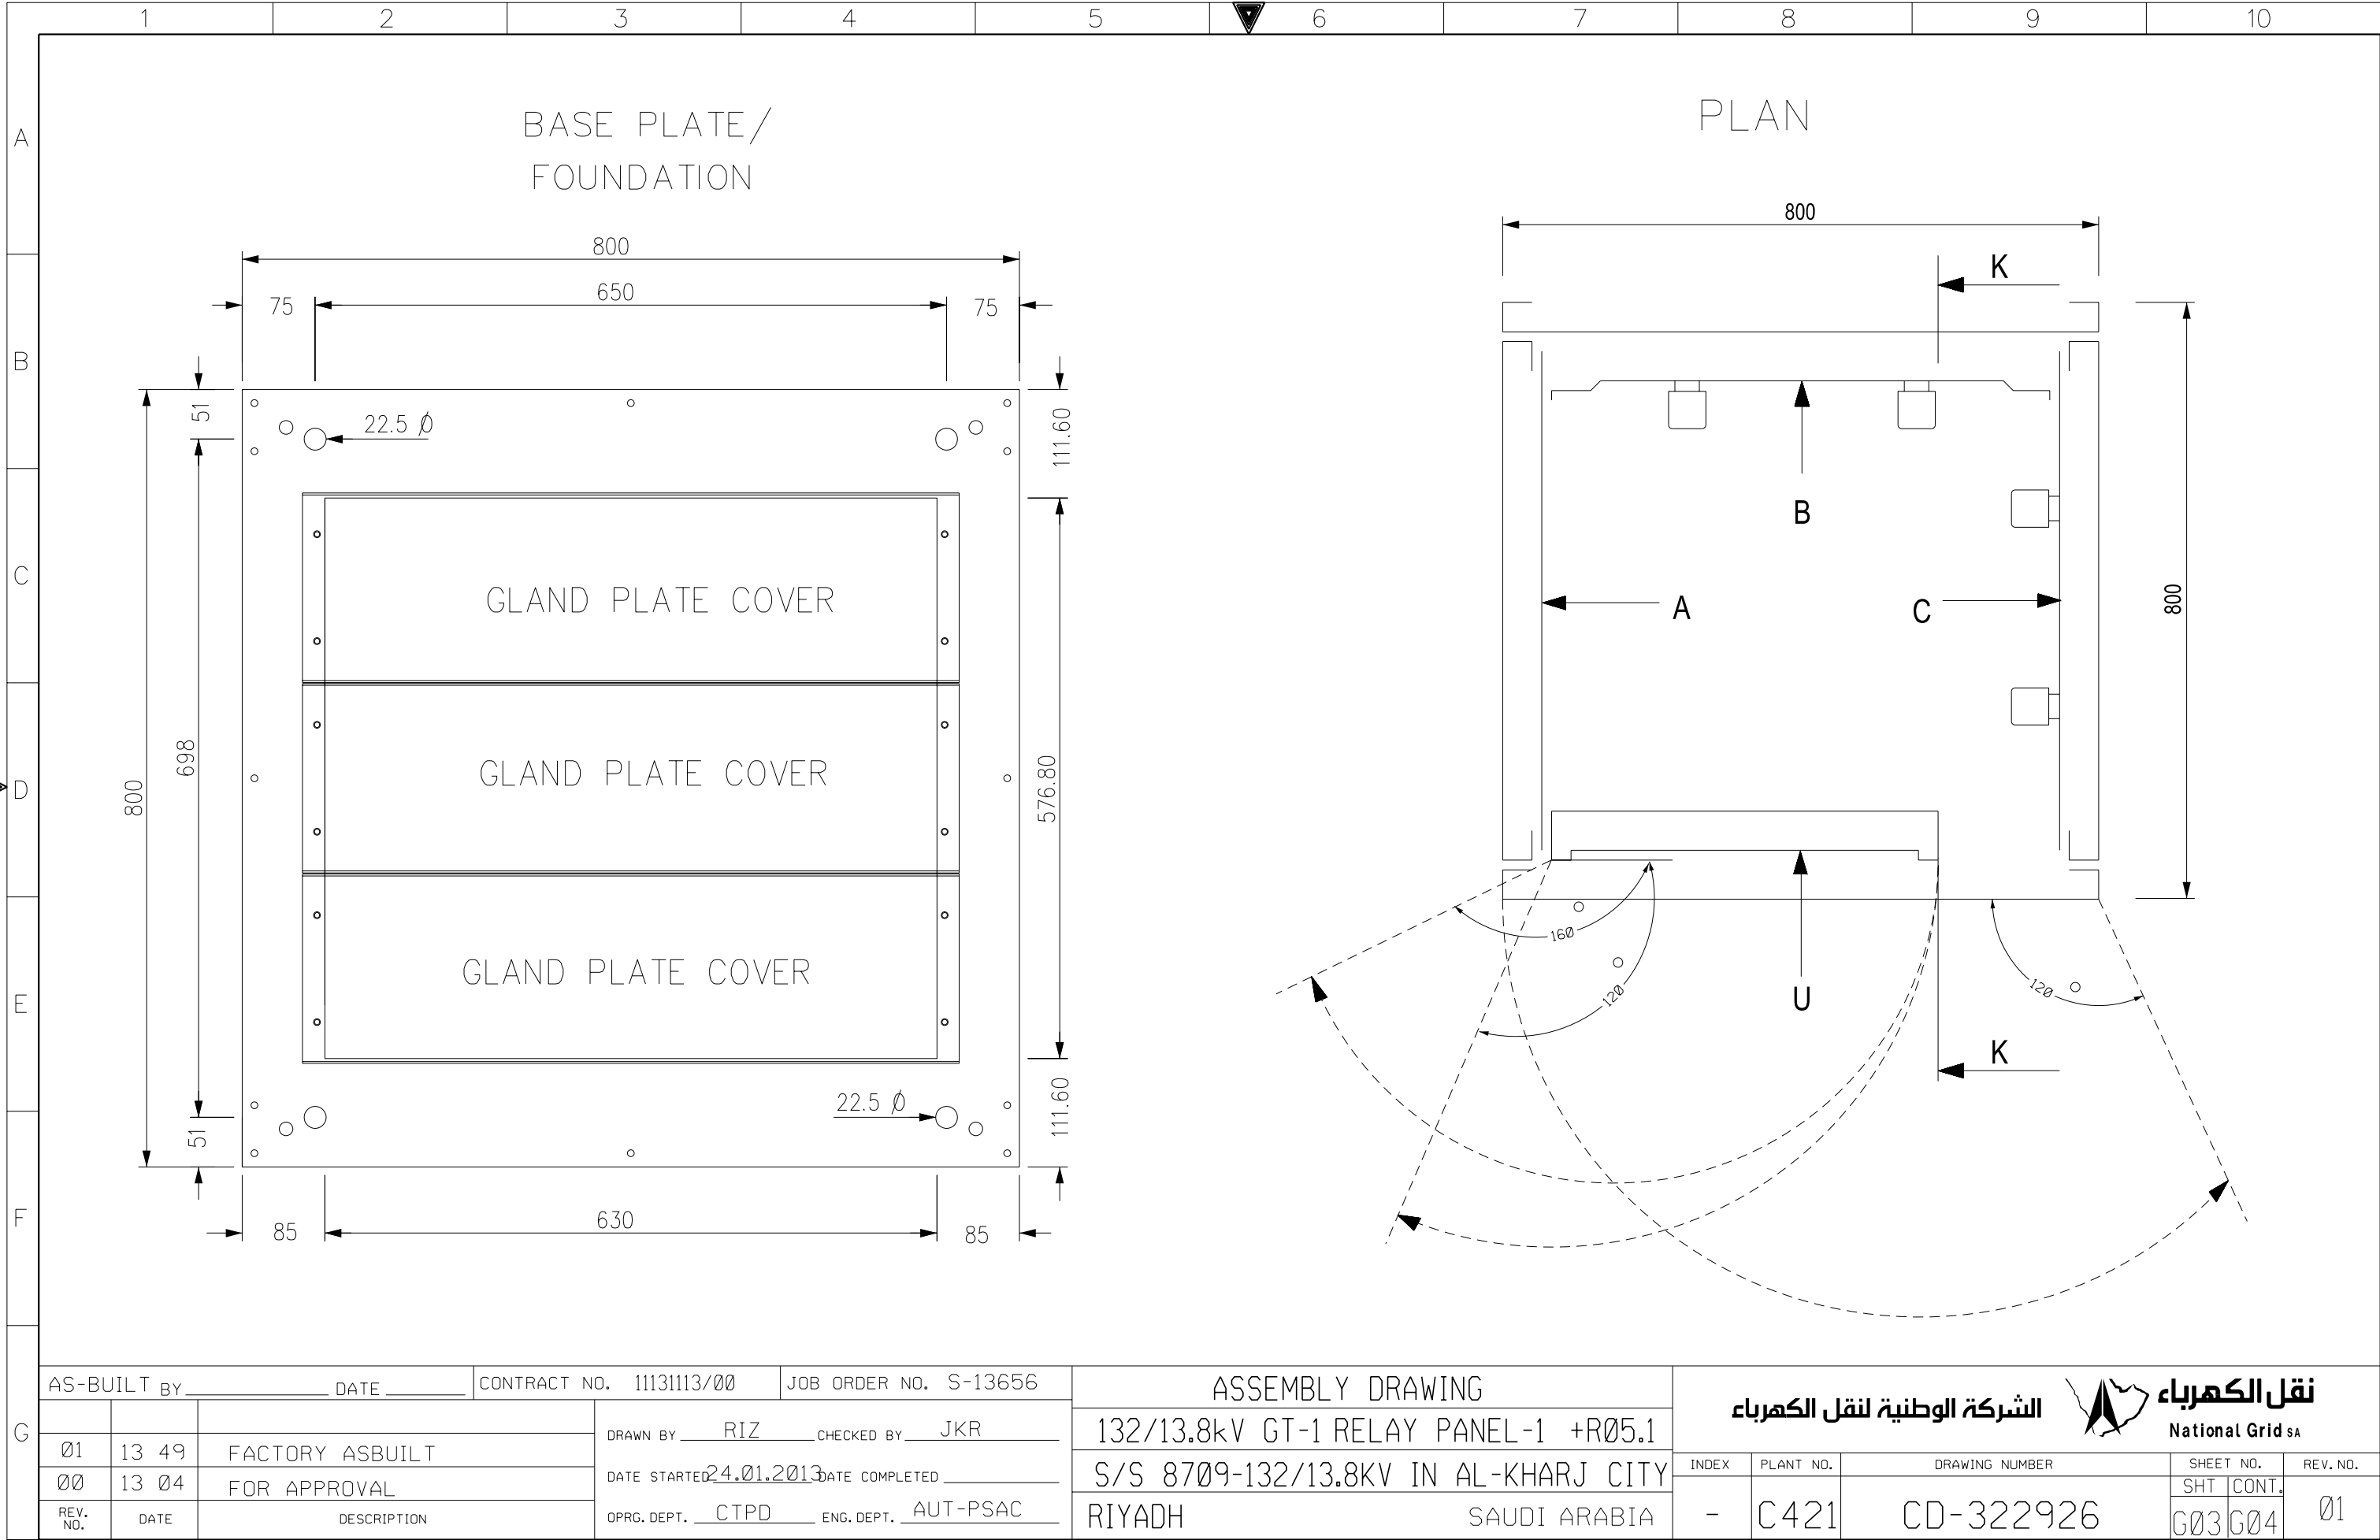
PLANE – B

SCH.REF	DESCRIPTION	TYPE	MAKE
X1	CT CIRCUITS	OTTA 6T P/P	PHOENIX
X2	VT CIRCUITS	D6/8.ST1.RS	ENTRELEC
X3	AC INCOMING CIRCUITS	D6/8.ST1.RS	ENTRELEC
X41	DC EXT. CIRCUITS	M6/8.RS	ENTRELEC
X51,X51A	DC PROTN. CIRCUITS	M6/8.RS	ENTRELEC
XSH	SPACE HEATER	M6/8.RS	ENTRELEC


PLANE – C

SCH.REF	DESCRIPTION	TYPE	MAKE
XTJ	TELEPHONE JACK	M6/8.RS	ENTRELEC
X6	ALARM SUPPLY	M6/8.RS	ENTRELEC
X61	ALARM CIRCUITS	M6/8.RS	ENTRELEC
X91	SPARE CIRCUITS	M6/8.RS	ENTRELEC
XD	DC INCOMING CIRCUITS	IN540B	MEJDAF

G	AS-BUILT BY _____ DATE _____		CONTRACT NO. 11131113/00		JOB ORDER NO. S-13656		ASSEMBLY DRAWING		<div>الشركة الوطنية لنقل الكهرباء</div> <div>نقل الكهرباء</div> <div>National Grid sa</div>						
	01	13 49	FACTORY ASBUILT		DRAWN BY RIZ CHECKED BY JKR		132/13.8kV GT-1 RELAY PANEL-1 +R05.1		INDEX	PLANT NO.	DRAWING NUMBER		SHEET NO.		REV. NO.
	00	13 04	FOR APPROVAL		DATE STARTED 24.01.2013 DATE COMPLETED _____		S/S 8709-132/13.8KV IN AL-KHARJ CITY				SHT	CONT.			
	REV. NO.	DATE	DESCRIPTION		OPRG. DEPT. CTPD ENG. DEPT. AUT-PSAC		RIYADH SAUDI ARABIA				G02	G03			





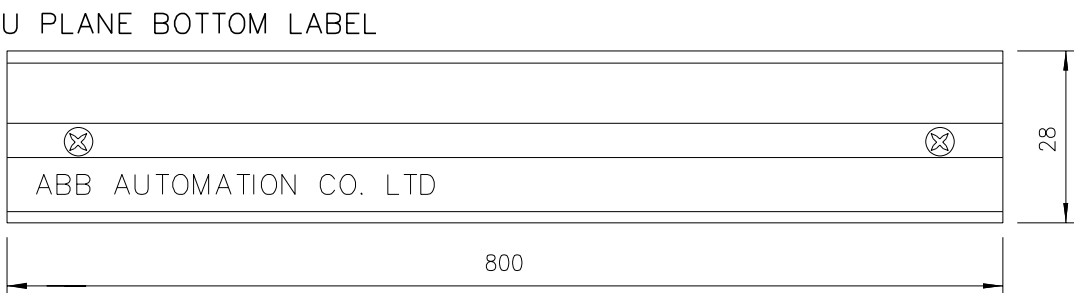

THIS DRAWING AND THE INFORMATION CONTAINED HEREIN ARE THE SOLE PROPERTY OF National Grid SA NO REPRODUCTION IN FULL OR IN PART SHALL BE OBTAINED FROM THIS DOCUMENT WITHOUT THE WRITTEN CONSENT OF ITS OWNER.



MANUFACTURING LABEL	
<b>ABB</b> ABB Automation Co.Ltd.	
PROJECT :	National Grid SA S/S 8709
ORDER REFERENCE :	2875 RF S13656
YEAR OF MANUFACTURE:	2013
PANEL NO. :	+R05.1
DRAWING NO. :	S13656-CD-323928
MADE IN THE KINGDOM OF SAUDI ARABIA	

AS-BUILT BY _____ DATE _____			CONTRACT NO. 11131113/00		JOB ORDER NO. S-13656		ASSEMBLY DRAWING			<div><div><div><div>نقل الكهرباء</div><div>National Grid sa</div></div><div><div>الشركة الوطنية لنقل الكهرباء</div></div></div></div>				
			DRAWN BY _____ RIZ _____ CHECKED BY _____ JKR		132/13.8kV GT-1 RELAY PANEL-1 +R05.1									
01	13 49	FACTORY ASBUILT		DATE STARTED <u>24.01.2013</u> DATE COMPLETED _____		S/S 8709-132/13.8KV IN AL-KHARJ CITY		INDEX	PLANT NO.	DRAWING NUMBER		SHEET NO.		REV. NO.
00	13 04	FOR APPROVAL		OPRG. DEPT. _____ CTPD _____ ENG. DEPT. _____ AUT-PSAC		RIYADH SAUDI ARABIA		-	C421	CD-322926		SHT G04 CONT L00		01

	1	2	3	4	5	6	7	8	9	10																																																																		
A			POWER SYSTEMS NETWORK MANAGEMENT PROTECTION AND SUBSTATION AUTOMATION SYSTEMS WBS NO: S-13656					ABB AUTOMATION COMPANY LTD., 414, AL-KHARJ ROAD SECOND INDUSTRIAL CITY RIYADH-11383 K.S.A																																																																				
B																																																																												
C	CONTRACTOR : ABB Contracting Company																																																																											
	CLIENT : National Gridsa																																																																											
D	PROJECT : CONSTRUCTION OF NEW 132/13.8kV SS 8709 IN AL-KHARJ CITY																																																																											
	SUBSTATION : S/S 8709																																																																											
E	CONTRACT NO. : 11131113/00																																																																											
	TITLE : LIST OF APPARATUS +R05.1 [GT-1]																																																																											
F																																																																												
G	<table><tr><td colspan="3">AS-BUILT BY _____ DATE _____</td><td colspan="2">CONTRACT NO. 11131113/00</td><td colspan="2">JOB ORDER NO. S-13656</td><td colspan="2">COVER SHEET</td><td colspan="2"> <b>نقل الكهرباء</b> الشركة الوطنية لنقل الكهرباء National Grid sa</td></tr><tr><td>01</td><td>13 49</td><td>FACTORY ASBUILT</td><td colspan="3">DRAWN BY RIZ CHECKED BY JKR</td><td colspan="3">132/13.8kV GT-1 RELAY PANEL-1 +R05.1</td><td colspan="2">SHEET NO.</td></tr><tr><td>00</td><td>13 04</td><td>FOR APPROVAL</td><td colspan="3">DATE STARTED 24.01.2013 DATE COMPLETED _____</td><td colspan="3">S/S 8709-132/13.8KV IN AL-KHARJ CITY</td><td colspan="2">REV. NO.</td></tr><tr><td>REV. NO.</td><td>DATE</td><td>DESCRIPTION</td><td colspan="3">OPRG. DEPT. CTPD ENG. DEPT. AUT-PSAC</td><td colspan="3">RIYADH SAUDI ARABIA</td><td colspan="2">01</td></tr><tr><td colspan="3"></td><td colspan="3"></td><td colspan="3">INDEX PLANT NO. DRAWING NUMBER</td><td colspan="2">SHT CONT.</td></tr><tr><td colspan="3"></td><td colspan="3"></td><td colspan="3">- C421 CD-322926</td><td colspan="2">L00 L01</td></tr></table>										AS-BUILT BY _____ DATE _____			CONTRACT NO. 11131113/00		JOB ORDER NO. S-13656		COVER SHEET		 <b>نقل الكهرباء</b> الشركة الوطنية لنقل الكهرباء National Grid sa		01	13 49	FACTORY ASBUILT	DRAWN BY RIZ CHECKED BY JKR			132/13.8kV GT-1 RELAY PANEL-1 +R05.1			SHEET NO.		00	13 04	FOR APPROVAL	DATE STARTED 24.01.2013 DATE COMPLETED _____			S/S 8709-132/13.8KV IN AL-KHARJ CITY			REV. NO.		REV. NO.	DATE	DESCRIPTION	OPRG. DEPT. CTPD ENG. DEPT. AUT-PSAC			RIYADH SAUDI ARABIA			01								INDEX PLANT NO. DRAWING NUMBER			SHT CONT.								- C421 CD-322926			L00 L01	
AS-BUILT BY _____ DATE _____			CONTRACT NO. 11131113/00		JOB ORDER NO. S-13656		COVER SHEET		 <b>نقل الكهرباء</b> الشركة الوطنية لنقل الكهرباء National Grid sa																																																																			
01	13 49	FACTORY ASBUILT	DRAWN BY RIZ CHECKED BY JKR			132/13.8kV GT-1 RELAY PANEL-1 +R05.1			SHEET NO.																																																																			
00	13 04	FOR APPROVAL	DATE STARTED 24.01.2013 DATE COMPLETED _____			S/S 8709-132/13.8KV IN AL-KHARJ CITY			REV. NO.																																																																			
REV. NO.	DATE	DESCRIPTION	OPRG. DEPT. CTPD ENG. DEPT. AUT-PSAC			RIYADH SAUDI ARABIA			01																																																																			
						INDEX PLANT NO. DRAWING NUMBER			SHT CONT.																																																																			
						- C421 CD-322926			L00 L01																																																																			

NG/D2-D (2012/01)

DMS VECTOR NGD200



	1	2	3	4	5	6	7	8	9	10	
A											
B				RELAY CUBICLE- +R05.1 ACCOMODATING THE FOLLOWING							
	1	U05.5001	87T-1	NUMERICAL TRANSFORMER PROTECTION IED WITH FOLLOWING DETAILS		301	1	RET 670*1	ABB	1MRK 004 816-DC	
				FUNCTIONS			1			1MRK 004 005-DC	
				-CONFIGURATION ALTERNATIVE							
				DOUBLE BREAKER, 3WINDING (B40) BASIC							
				-CONTROL							
				HARDWARE							
				-ANALOG SYSTEM							
				TRANSFORMER INPUT MODULE,RING LUG TERMINALS 91+3U,1A							
				110/220/V,50/60HZ/(TRM)(BASIC SELECTED ALTERNATIVE)LOCATION/P40/							
C				TRANSFORMER INPUT MODULE,RING LUG TERMINALS 91+3U,1A							
				110/220/V,50/60HZ/(TRM)(BASIC SELECTED ALTERNATIVE)LOCATION/P41/							
				-CASING							
				POWER SUPPLY MODULE 90-250 VDC (PSM)							
				LOCATION P1/							
				NUMERIC PROCESSING MODULE 600MHZ, 256MB (NUM) BASIC							
				LOCATION/P30/							
				3/4\SX 19" RACK CASING MAX 5 I/O MOD,							
				2TRM (RACK)							
				COMBINED BACKPLANE MODULE MAX 5 I/O MOD.							
D				(BASIC SELECTED ALTERNATIVE) 2TRM (RACK)							
				UNIVERSAL BACKPLANE MODULE 2 ADM,2TRM (UBM) BASIC							
				-CONNECTION TYPE							
				STANDARD COMPRESSION CONNECTION TERMINALS )							
				LOCATION/P1-P16							
				-HUMAN MACHINE INTERFACE							
				MEDIUM GRAPHIC HMI,15 CONTROLLABLE OBJECTS							
				3/4 X 19"IEC (MHMI)							
				-IN/OUT MODULES							
				BINARY INPUT MODULE LOCATION P3,P5			2			1MRK 000 508-BB	
E				BINARY OUTPUT MODULE,24 OUTPUT RELAYS (BOM)			2			1MRK 000 614-AB	
				LOCATION P4							
				OPTICAL ETHERNET MODULE 2 GLASS INTERFACE IEC61850-8-1/IEC61850-9-2						1MRK 002 266-AA	
				(OEM)( SELECTED OPTION) LOCATION P31:1							
F	2	U12.101	TS-1	TEST SWITCH FOR RET670 RELAY		222	1	RTXP18	ABB	RK 926 115-BH	
		U12.113	TS-2	TEST SWITCH FOR RET670 RELAY		222	1	RTXP18	ABB	RK 926 115-BB	
G	AS-BUILT BY _____ DATE _____			CONTRACT NO. 11131113/00		JOB ORDER NO. S-13656		LIST OF APPARATUS			<div>نقل الكهرباء</div> <div>الشركة الوطنية لنقل الكهرباء</div> <div>National Grid sa</div>
				DRAWN BY RIZ CHECKED BY JKR		132/13.8kV GT-1 RELAY PANEL-1 +R05.1					
	01	13 49	FACTORY ASBUILT	DATE STARTED 24.01.2013 DATE COMPLETED _____		S/S 8709-132/13.8KV IN AL-KHARJ CITY					
	00	13 04	FOR APPROVAL	OPRG. DEPT. CTPD ENG. DEPT. AUT-PSAC		RIYADH SAUDI ARABIA					
	REV. NO.	DATE	DESCRIPTION		INDEX	PLANT NO.	DRAWING NUMBER		SHEET NO.	REV. NO.	
					-	C421	CD-322926		SHT L01	CONT. L02 01	

1

2

3

4

5

6

7

8

9

10

A

SR. NO.	GA REF.	SCH. REF.	D E S C R I P T I O N	SHEET NO.	QTY.	TYPE	MAKE	ORDERING INFORMATION
3	U16.5001	S86T1	PUSH BUTTON BLACK COLOUR, WITH 1NO+1NC CONTACTS FOR RESET OF LOCKOUT RELAY (86T1)	232	1	MP1-10B MCBH-20	ABB	1SFA 611 100 R1006 1SFA 611 605 R1102
4	U16.5002	S86CBF	PUSH BUTTON BLACK COLOUR, WITH 1NO+1NC CONTACTS FOR RESET OF LOCKOUT RELAY (86CBF)	276	1	MP1-10B MCBH-20	ABB	1SFA 611 100 R1006 1SFA 611 605 R1102
5	U16.5003	S86B-1	PUSH BUTTON BLACK COLOUR, WITH 1NO+1NC CONTACTS FOR RESET OF LOCKOUT RELAY (86B-1)	276	1	MP1-10B MCBH-20	ABB	1SFA 611 100 R1006 1SFA 611 605 R1102
6	U16.5004	S86B-2	PUSH BUTTON BLACK COLOUR, WITH 1NO+1NC CONTACTS FOR RESET OF LOCKOUT RELAY (86B-2)	277	1	MP1-10B MCBH-20	ABB	1SFA 611 100 R1006 1SFA 611 605 R1102

	1	2	3	4	5	6	7	8	9	10				
A														
B														
C														
D														
E														
F														
G														
	AS-BUILT BY _____ DATE _____			CONTRACT NO. 11131113/00		JOB ORDER NO. S-13656		LIST OF APPARATUS			<div>الشركة الوطنية لنقل الكهرباء</div> <div> نقل الكهرباء National Grid sa</div>			
	01 13 49 FACTORY ASBUILT			DRAWN BY RIZ CHECKED BY JKR		132/13.8kV GT-1 RELAY PANEL-1 +R05.1			INDEX	PLANT NO.		DRAWING NUMBER	SHEET NO.	REV. NO.
	00 13 04 FOR APPROVAL			DATE STARTED 24.01.2013 DATE COMPLETED _____		S/S 8709-132/13.8KV IN AL-KHARJ CITY							SHT	CONT.
REV. NO. DATE DESCRIPTION			OPRG. DEPT. CTPD ENG. DEPT. AUT-PSAC		RIYADH SAUDI ARABIA			-	C421	CD-322926		L03	L04	01

NG/D2-D (2012/01)

DMS VECTOR

NGD200

	1	2	3	4	5	6	7	8	9	10					
A															
B															
C															
D															
E															
F															
G	AS-BUILT BY _____ DATE _____			CONTRACT NO. 11131113/00		JOB ORDER NO. S-13656		LIST OF APPARATUS			الشركة الوطنية لنقل الكهرباء		نقل الكهرباء National Grid sa		
				DRAWN BY RIZ CHECKED BY JKR		132/13.8kv GT-1 RELAY PANEL-1 +R05.1		INDEX		PLANT NO.	DRAWING NUMBER		SHEET NO.		REV. NO.
	01	13 49	FACTORY ASBUILT		DATE STARTED 24.01.2013 DATE COMPLETED _____		S/S 8709-132/13.8KV IN AL-KHARJ CITY						SHT		CONT.
	00	13 04	FOR APPROVAL		OPRG. DEPT. CTPD ENG. DEPT. AUT-PSAC		RIYADH SAUDI ARABIA						L04		L05
	REV. NO.	DATE	DESCRIPTION												01




	1	2	3	4	5	6	7	8	9	10
A										
	SR. NO.	GA REF.	SCH. REF.	D E S C R I P T I O N		SHEET. NO.	QTY.	TYPE	MAKE	ORDERING INFORMATION
	22		X1	BLOT CONNECTING TERMINAL BLOCKS DISCONNECTIBLE FOR CT CIRCUITS		304	60	OTTA 6T P/P	PHOENIX	0790462
B			X2	SPRING LOADED TERMINAL BLOCKS DISCONNECTIBLE FOR VT CIRCUITS		304	5	D6/8.ST1.RS	ENTRELEC	1SNA 115 831 R0400
			X3	SPRING LOADED TERMINAL BLOCKS DISCONNECTIBLE FOR AC CIRCUITS		304	10	D6/8.ST1.RS	ENTRELEC	1SNA 115 831 R0400
			X41	SPRING LOADED TERMINAL BLOCK FOR DC EXT. CIRCUITS		304	40	D6/8.ST1.RS	ENTRELEC	1SNA 115 831 R0400
C			X51	SPRING LOADED TERMINAL BLOCK FOR DC PROTN. CIRCUITS		304	97	M6/8.RS	ENTRELEC	1SNA 115 685 R1200
			X6	SPRING LOADED TERMINAL BLOCK FOR STN COM		304	10	M6/8.RS	ENTRELEC	1SNA 115 685 R1200
			X61	KNIFE TYPE TERMINAL BLOCKS DISCONNECTIBLE FOR STN.-COM ALARM CIRCUITS		304	20	M6/8.SNB	ENTRELEC	1SNA 115 688 R2500
D			XTJ	SPRING LOADED TERMINAL BLOCK KNIFE TYPE FOR TELEPHONE JACK		305	5	M6/8.RS	ENTRELEC	1SNA 115 685 R1200
			XSH	SPRING LOADED TERMINAL BLOCKS FOR SPACE HEATER		305	3	M6/8.RS	ENTRELEC	1SNA 115 685 R1200
			XD	TERMINAL BLOCKS WITH BLOCKING DIODE, Vrrm=1kV, If=3A AND SURGE TRAP, ENERGY ABSORPTION RATING 8J (10/1000mS)		236,276	3	N4/6.S IN5408 V150ZA1	ENTRELEC MEJDAF RS	11521310 02-049 239-270
E			X9	SPRING LOADED TERMINAL BLOCK KNIFE TYPE FOR SPARE CONTACTS		295	20	M6/8.RS	ENTRELEC	1SNA 115 685 R1200
			X51A	SPRING LOADED TERMINAL BLOCK FOR DC PROTN. CIRCUITS		304	15	M6/8.RS	ENTRELEC	1SNA 115 685 R1200
			X53	SPRING LOADED TERMINAL BLOCK FOR DC PROTN. CIRCUITS		304	32	M6/8.RS	ENTRELEC	1SNA 115 685 R1200
F										
G	AS-BUILT BY _____ DATE _____		CONTRACT NO. 11131113/00		JOB ORDER NO. S-13656		LIST OF APPARATUS		الشركة الوطنية لنقل الكهرباء National Grid sa	
	01	13 49	FACTORY ASBUILT		DRAWN BY RIZ CHECKED BY JKR		132/13.8kV GT-1 RELAY PANEL-1 +R05.1		INDEX PLANT NO. DRAWING NUMBER SHEET NO. REV. NO.	
	00	13 04	FOR APPROVAL		DATE STARTED 24.01.2013 DATE COMPLETED _____		S/S 8709-132/13.8KV IN AL-KHARJ CITY		SHT CONT. 01	
	REV. NO.	DATE	DESCRIPTION		OPRG. DEPT. CTPD ENG. DEPT. AUT-PSAC		RIYADH SAUDI ARABIA		- C421 CD-322926 L05L06	

NG/D2-D (2012/01)

DMS VECTOR

NGD200





THIS DRAWING AND THE INFORMATION CONTAINED HEREIN ARE THE SOLE PROPERTY OF National Grid SA NO REPRODUCTION IN FULL OR IN PART SHALL BE OBTAINED FROM THIS DOCUMENT WITHOUT THE WRITTEN CONSENT OF ITS OWNER.

	1	2	3	4	5	6	7	8	9	10																																																																
A																																																																										
B																																																																										
C																																																																										
D																																																																										
E																																																																										
F																																																																										
G	<table><tr><td colspan="3">AS-BUILT BY _____ DATE _____</td><td colspan="2">CONTRACT NO. 11131113/00</td><td colspan="2">JOB ORDER NO. S-13656</td><td colspan="3">LIST OF APPARATUS</td><td colspan="2"><div>الشركة الوطنية لنقل الكهرباء</div><div> <b>نقل الكهرباء</b> National Grid sa</div></td></tr><tr><td></td><td></td><td></td><td colspan="2">DRAWN BY <u>RIZ</u> CHECKED BY <u>JKR</u></td><td colspan="3">132/13.8kV GT-1 RELAY PANEL-1 +R05.1</td><td>INDEX</td><td>PLANT NO.</td><td>DRAWING NUMBER</td><td>SHEET NO.</td><td>REV. NO.</td></tr><tr><td></td><td>01</td><td>13 49</td><td colspan="2">FACTORY ASBUILT</td><td colspan="3">S/S 8709-132/13.8KV IN AL-KHARJ CITY</td><td></td><td></td><td></td><td>SHT</td><td>CONT.</td></tr><tr><td></td><td>00</td><td>13 04</td><td colspan="2">FOR APPROVAL</td><td colspan="3">RIYADH SAUDI ARABIA</td><td>-</td><td>C421</td><td>CD-322926</td><td>L06</td><td>L07</td></tr><tr><td></td><td>REV. NO.</td><td>DATE</td><td colspan="2">DESCRIPTION</td><td colspan="2">OPRG. DEPT. <u>CTPD</u> ENG. DEPT. <u>AUT-PSAC</u></td><td colspan="3"></td><td colspan="3">01</td></tr></table>										AS-BUILT BY _____ DATE _____			CONTRACT NO. 11131113/00		JOB ORDER NO. S-13656		LIST OF APPARATUS			<div>الشركة الوطنية لنقل الكهرباء</div> <div> <b>نقل الكهرباء</b> National Grid sa</div>					DRAWN BY <u>RIZ</u> CHECKED BY <u>JKR</u>		132/13.8kV GT-1 RELAY PANEL-1 +R05.1			INDEX	PLANT NO.	DRAWING NUMBER	SHEET NO.	REV. NO.		01	13 49	FACTORY ASBUILT		S/S 8709-132/13.8KV IN AL-KHARJ CITY						SHT	CONT.		00	13 04	FOR APPROVAL		RIYADH SAUDI ARABIA			-	C421	CD-322926	L06	L07		REV. NO.	DATE	DESCRIPTION		OPRG. DEPT. <u>CTPD</u> ENG. DEPT. <u>AUT-PSAC</u>					01		
AS-BUILT BY _____ DATE _____			CONTRACT NO. 11131113/00		JOB ORDER NO. S-13656		LIST OF APPARATUS			<div>الشركة الوطنية لنقل الكهرباء</div> <div> <b>نقل الكهرباء</b> National Grid sa</div>																																																																
			DRAWN BY <u>RIZ</u> CHECKED BY <u>JKR</u>		132/13.8kV GT-1 RELAY PANEL-1 +R05.1			INDEX	PLANT NO.	DRAWING NUMBER	SHEET NO.	REV. NO.																																																														
	01	13 49	FACTORY ASBUILT		S/S 8709-132/13.8KV IN AL-KHARJ CITY						SHT	CONT.																																																														
	00	13 04	FOR APPROVAL		RIYADH SAUDI ARABIA			-	C421	CD-322926	L06	L07																																																														
	REV. NO.	DATE	DESCRIPTION		OPRG. DEPT. <u>CTPD</u> ENG. DEPT. <u>AUT-PSAC</u>					01																																																																

	1	2	3	4	5	6	7	8	9	10	
A											
B											
C											
D											
E											
F											
G	AS-BUILT BY _____ DATE _____		CONTRACT NO. 11131113/00		JOB ORDER NO. S-13656		LIST OF APPARATUS				
	01	13 49	FACTORY ASBUILT		DRAWN BY RIZ CHECKED BY JKR		132/13.8kV GT-1 RELAY PANEL-1 +R05.1				
	00	13 04	FOR APPROVAL		DATE STARTED 24.01.2013 DATE COMPLETED _____		S/S 8709-132/13.8KV IN AL-KHARJ CITY				
	REV. NO.	DATE	DESCRIPTION		OPRG. DEPT. CTPD ENG. DEPT. AUT-PSAC		RIYADH SAUDI ARABIA				

LABEL REF.	LABEL ENGRAVING	MATERIALS	ENGRAVING	LABEL SIZE	LETTER SIZE
C1	C1 127V AC SUPPLY MCB	TRAFOLITE	BLACK LETTERS ON WHITE BACKGROUND	50X15mm	4mm
C2	C2 220V AC SUPPLY MCB	TRAFOLITE	BLACK LETTERS ON WHITE BACKGROUND	50X15mm	4mm
C3	C3 THERMOSTAT	TRAFOLITE	BLACK LETTERS ON WHITE BACKGROUND	50X15mm	4mm
C7	C7 ON/OFF SWITCH	TRAFOLITE	BLACK LETTERS ON WHITE BACKGROUND	50X15mm	4mm
DS	DS DOOR SWITCH	TRAFOLITE	BLACK LETTERS ON WHITE BACKGROUND	50X15mm	4mm
IL	IL ILLUMINATION LAMP	TRAFOLITE	BLACK LETTERS ON WHITE BACKGROUND	50X15mm	4mm
SH	SH SPACE HEATER	TRAFOLITE	BLACK LETTERS ON WHITE BACKGROUND	50X15mm	4mm

الشركة الوطنية لنقل الكهرباء		National Grid sa		
INDEX	PLANT NO.	DRAWING NUMBER	SHEET NO.	REV. NO.
-	C421	CD-322926	SHT L07	CONT. G00
			01	

	1	2	3	4	5	6	7	8	9	10																																																																																																														
A			POWER SYSTEMS NETWORK MANAGEMENT PROTECTION AND SUBSTATION AUTOMATION SYSTEMS WBS NO: S-13656					ABB AUTOMATION COMPANY LTD., 414, AL-KHARJ ROAD SECOND INDUSTRIAL CITY RIYADH-11383 K.S.A																																																																																																																
B																																																																																																																								
C	CONTRACTOR : ABB Contracting Company																																																																																																																							
	CLIENT : National Gridsa																																																																																																																							
D	PROJECT : CONSTRUCTION OF NEW 132/13.8kV SS 8709 IN AL-KHARJ CITY																																																																																																																							
	SUBSTATION : S/S 8709																																																																																																																							
E	CONTRACT NO. : 11131113/00																																																																																																																							
	TITLE : Assembly Drawing +R05.2 [GT-1]																																																																																																																							
F																																																																																																																								
G	<table><tr><td colspan="3">AS-BUILT BY _____ DATE _____</td><td colspan="2">CONTRACT NO. 11131113/00</td><td colspan="2">JOB ORDER NO. S-13656</td><td colspan="2">COVER SHEET</td><td colspan="2"><div>الشركة الوطنية لنقل الكهرباء</div><div> نقل الكهرباء</div><div>National Grid sa</div></td></tr><tr><td></td><td></td><td></td><td colspan="2">DRAWN BY RIZ</td><td colspan="2">CHECKED BY JKR</td><td colspan="2">132/13.8kV GT-1 RELAY PANEL-2 +R05.2</td><td colspan="2">INDEX</td></tr><tr><td></td><td>01</td><td>13 49</td><td colspan="2">FACTORY ASBUILT</td><td colspan="2">DATE STARTED 24.01.2013</td><td colspan="2">S/S 8709-132/13.8KV IN AL-KHARJ CITY</td><td colspan="2">PLANT NO.</td></tr><tr><td></td><td>00</td><td>13 04</td><td colspan="2">FOR APPROVAL</td><td colspan="2">DATE COMPLETED _____</td><td colspan="2">RIYADH SAUDI ARABIA</td><td colspan="2">DRAWING NUMBER</td></tr><tr><td></td><td>REV. NO.</td><td>DATE</td><td colspan="2">DESCRIPTION</td><td colspan="2">OPRG. DEPT. CTPD</td><td colspan="2"></td><td colspan="2">SHEET NO.</td></tr><tr><td></td><td></td><td></td><td colspan="2"></td><td colspan="2">ENG. DEPT. AUT-PSAC</td><td colspan="2"></td><td colspan="2">SHT</td></tr><tr><td></td><td></td><td></td><td colspan="2"></td><td colspan="2"></td><td colspan="2"></td><td colspan="2">CONT.</td></tr><tr><td></td><td></td><td></td><td colspan="2"></td><td colspan="2"></td><td colspan="2"></td><td colspan="2">REV. NO.</td></tr><tr><td></td><td></td><td></td><td colspan="2"></td><td colspan="2"></td><td colspan="2"></td><td colspan="2">01</td></tr><tr><td></td><td></td><td></td><td colspan="2"></td><td colspan="2"></td><td colspan="2"></td><td colspan="2">G00G01</td></tr></table>										AS-BUILT BY _____ DATE _____			CONTRACT NO. 11131113/00		JOB ORDER NO. S-13656		COVER SHEET		<div>الشركة الوطنية لنقل الكهرباء</div> <div> نقل الكهرباء</div> <div>National Grid sa</div>					DRAWN BY RIZ		CHECKED BY JKR		132/13.8kV GT-1 RELAY PANEL-2 +R05.2		INDEX			01	13 49	FACTORY ASBUILT		DATE STARTED 24.01.2013		S/S 8709-132/13.8KV IN AL-KHARJ CITY		PLANT NO.			00	13 04	FOR APPROVAL		DATE COMPLETED _____		RIYADH SAUDI ARABIA		DRAWING NUMBER			REV. NO.	DATE	DESCRIPTION		OPRG. DEPT. CTPD				SHEET NO.							ENG. DEPT. AUT-PSAC				SHT											CONT.											REV. NO.											01											G00G01	
AS-BUILT BY _____ DATE _____			CONTRACT NO. 11131113/00		JOB ORDER NO. S-13656		COVER SHEET		<div>الشركة الوطنية لنقل الكهرباء</div> <div> نقل الكهرباء</div> <div>National Grid sa</div>																																																																																																															
			DRAWN BY RIZ		CHECKED BY JKR		132/13.8kV GT-1 RELAY PANEL-2 +R05.2		INDEX																																																																																																															
	01	13 49	FACTORY ASBUILT		DATE STARTED 24.01.2013		S/S 8709-132/13.8KV IN AL-KHARJ CITY		PLANT NO.																																																																																																															
	00	13 04	FOR APPROVAL		DATE COMPLETED _____		RIYADH SAUDI ARABIA		DRAWING NUMBER																																																																																																															
	REV. NO.	DATE	DESCRIPTION		OPRG. DEPT. CTPD				SHEET NO.																																																																																																															
					ENG. DEPT. AUT-PSAC				SHT																																																																																																															
									CONT.																																																																																																															
									REV. NO.																																																																																																															
									01																																																																																																															
									G00G01																																																																																																															


DMS

VECTOR

NG/D2-D (2012/01)  
NGD200





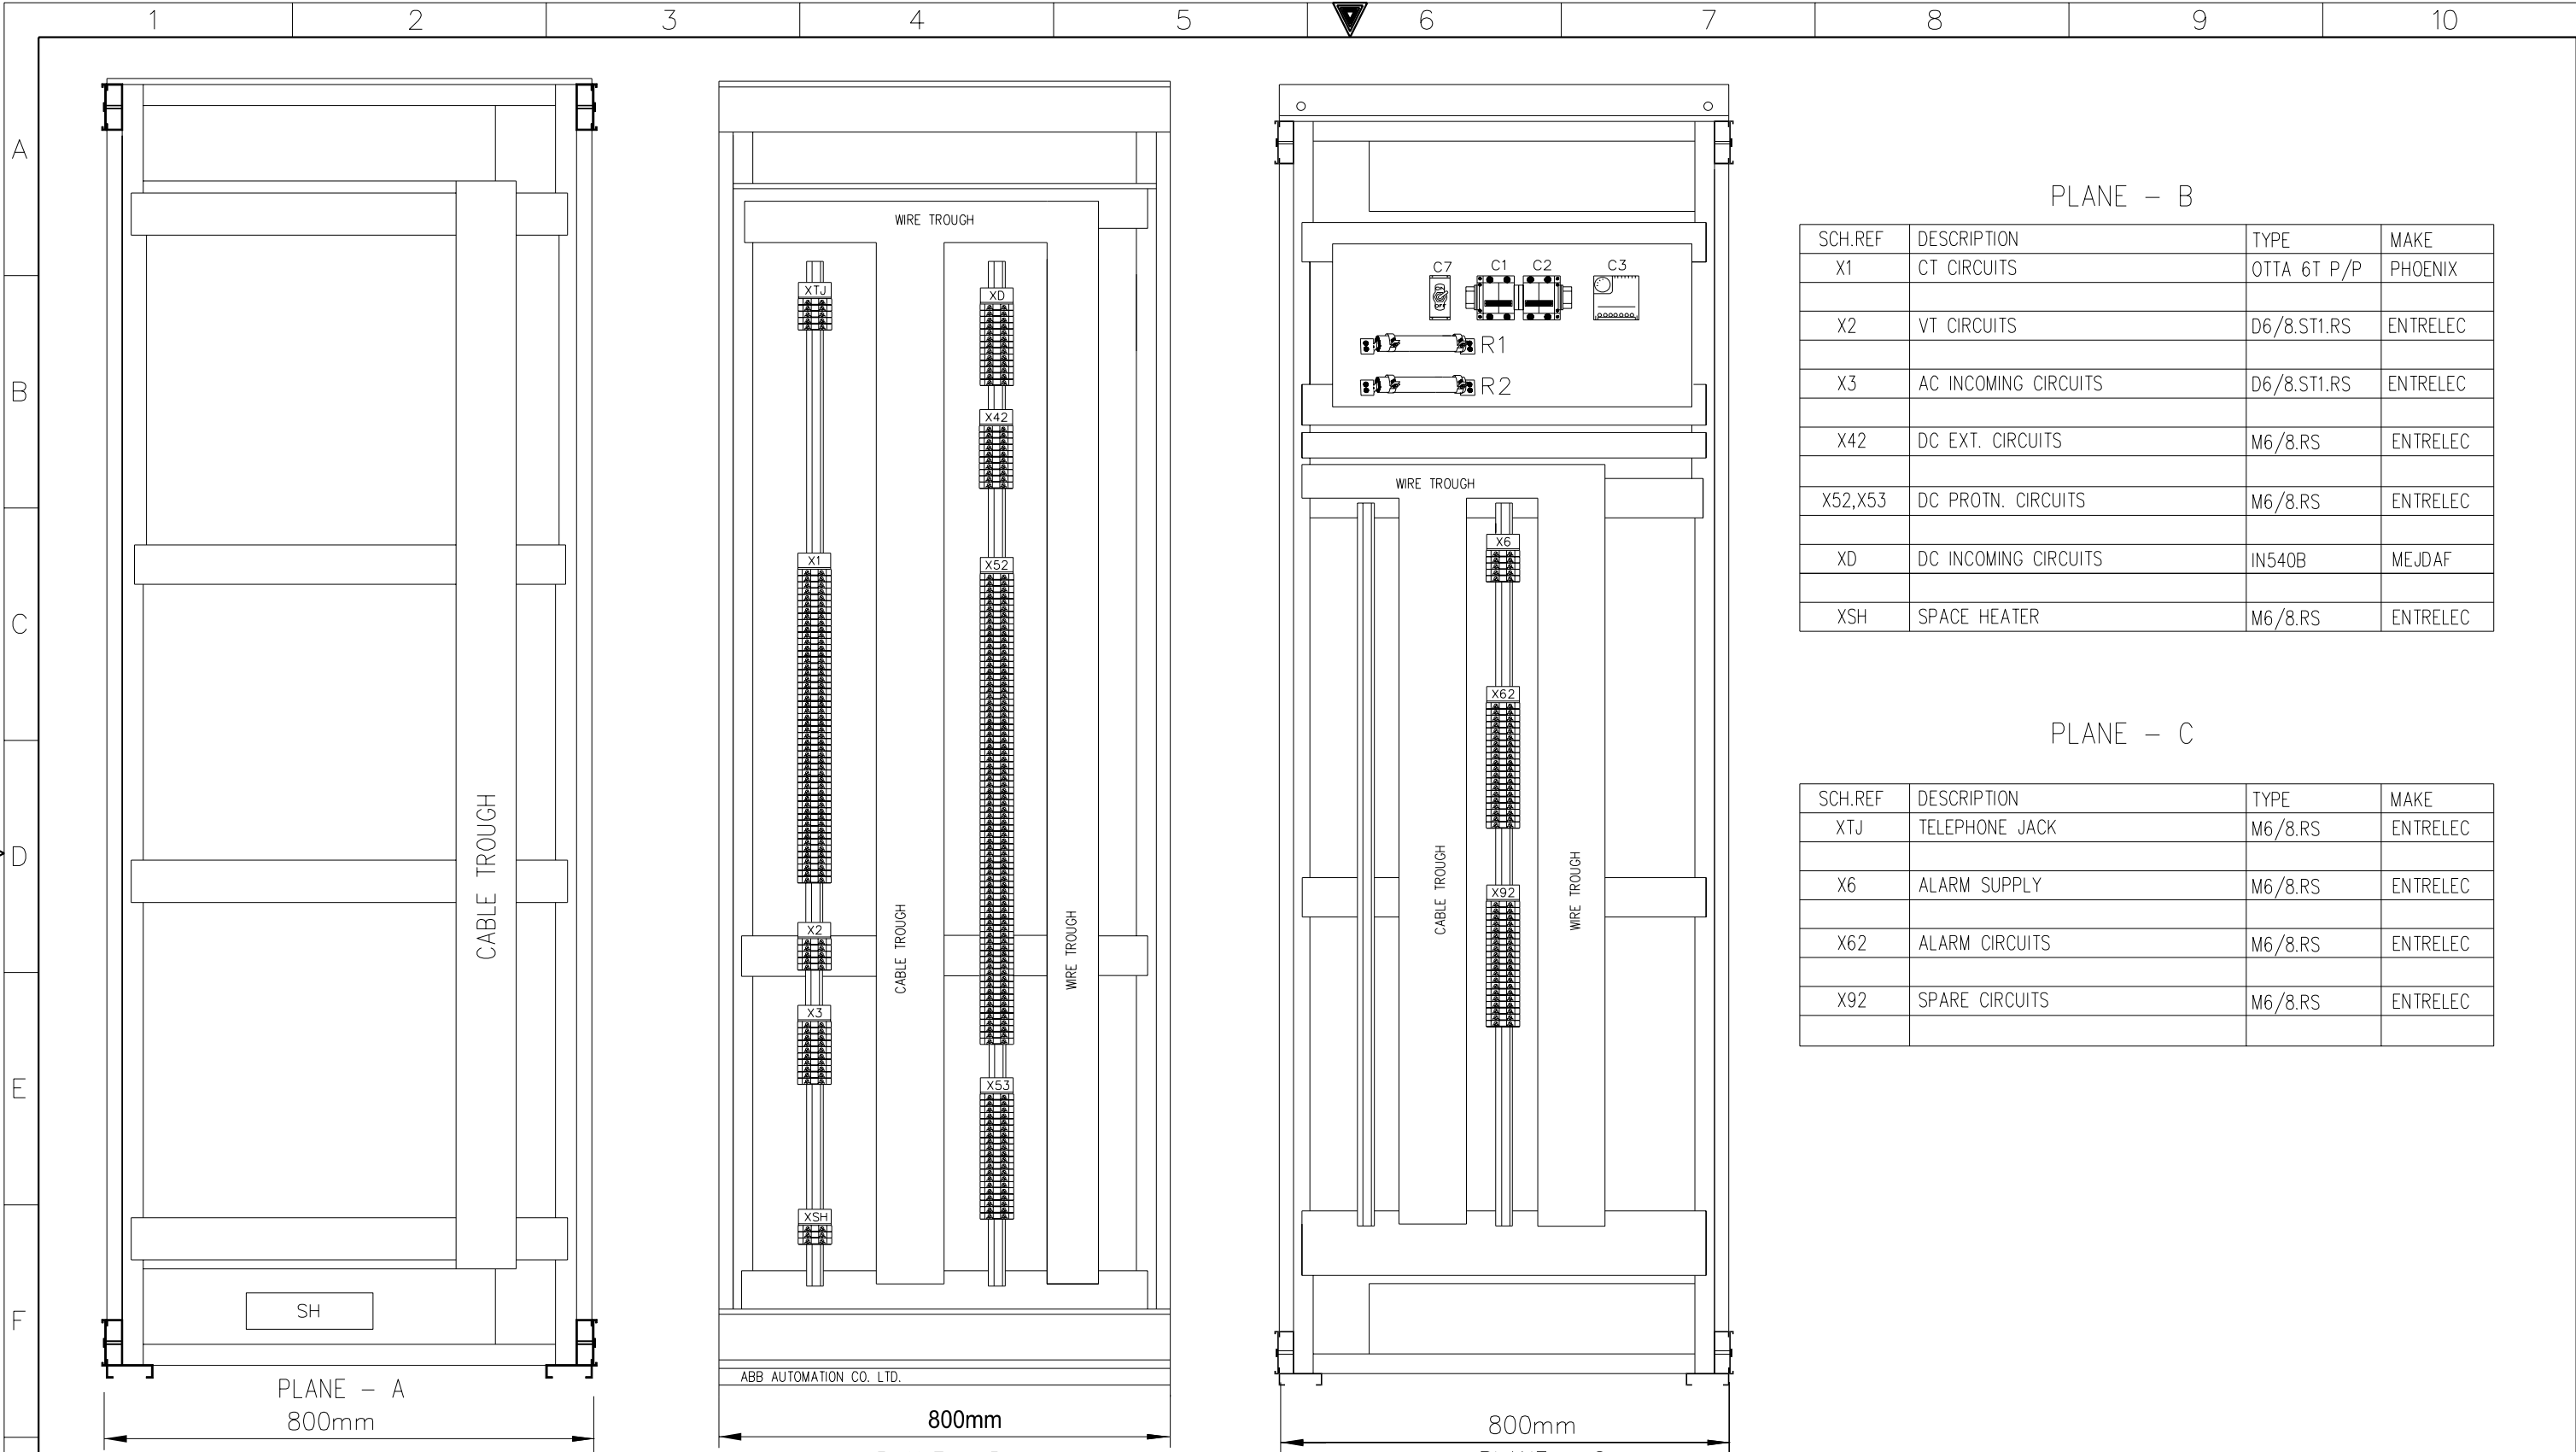


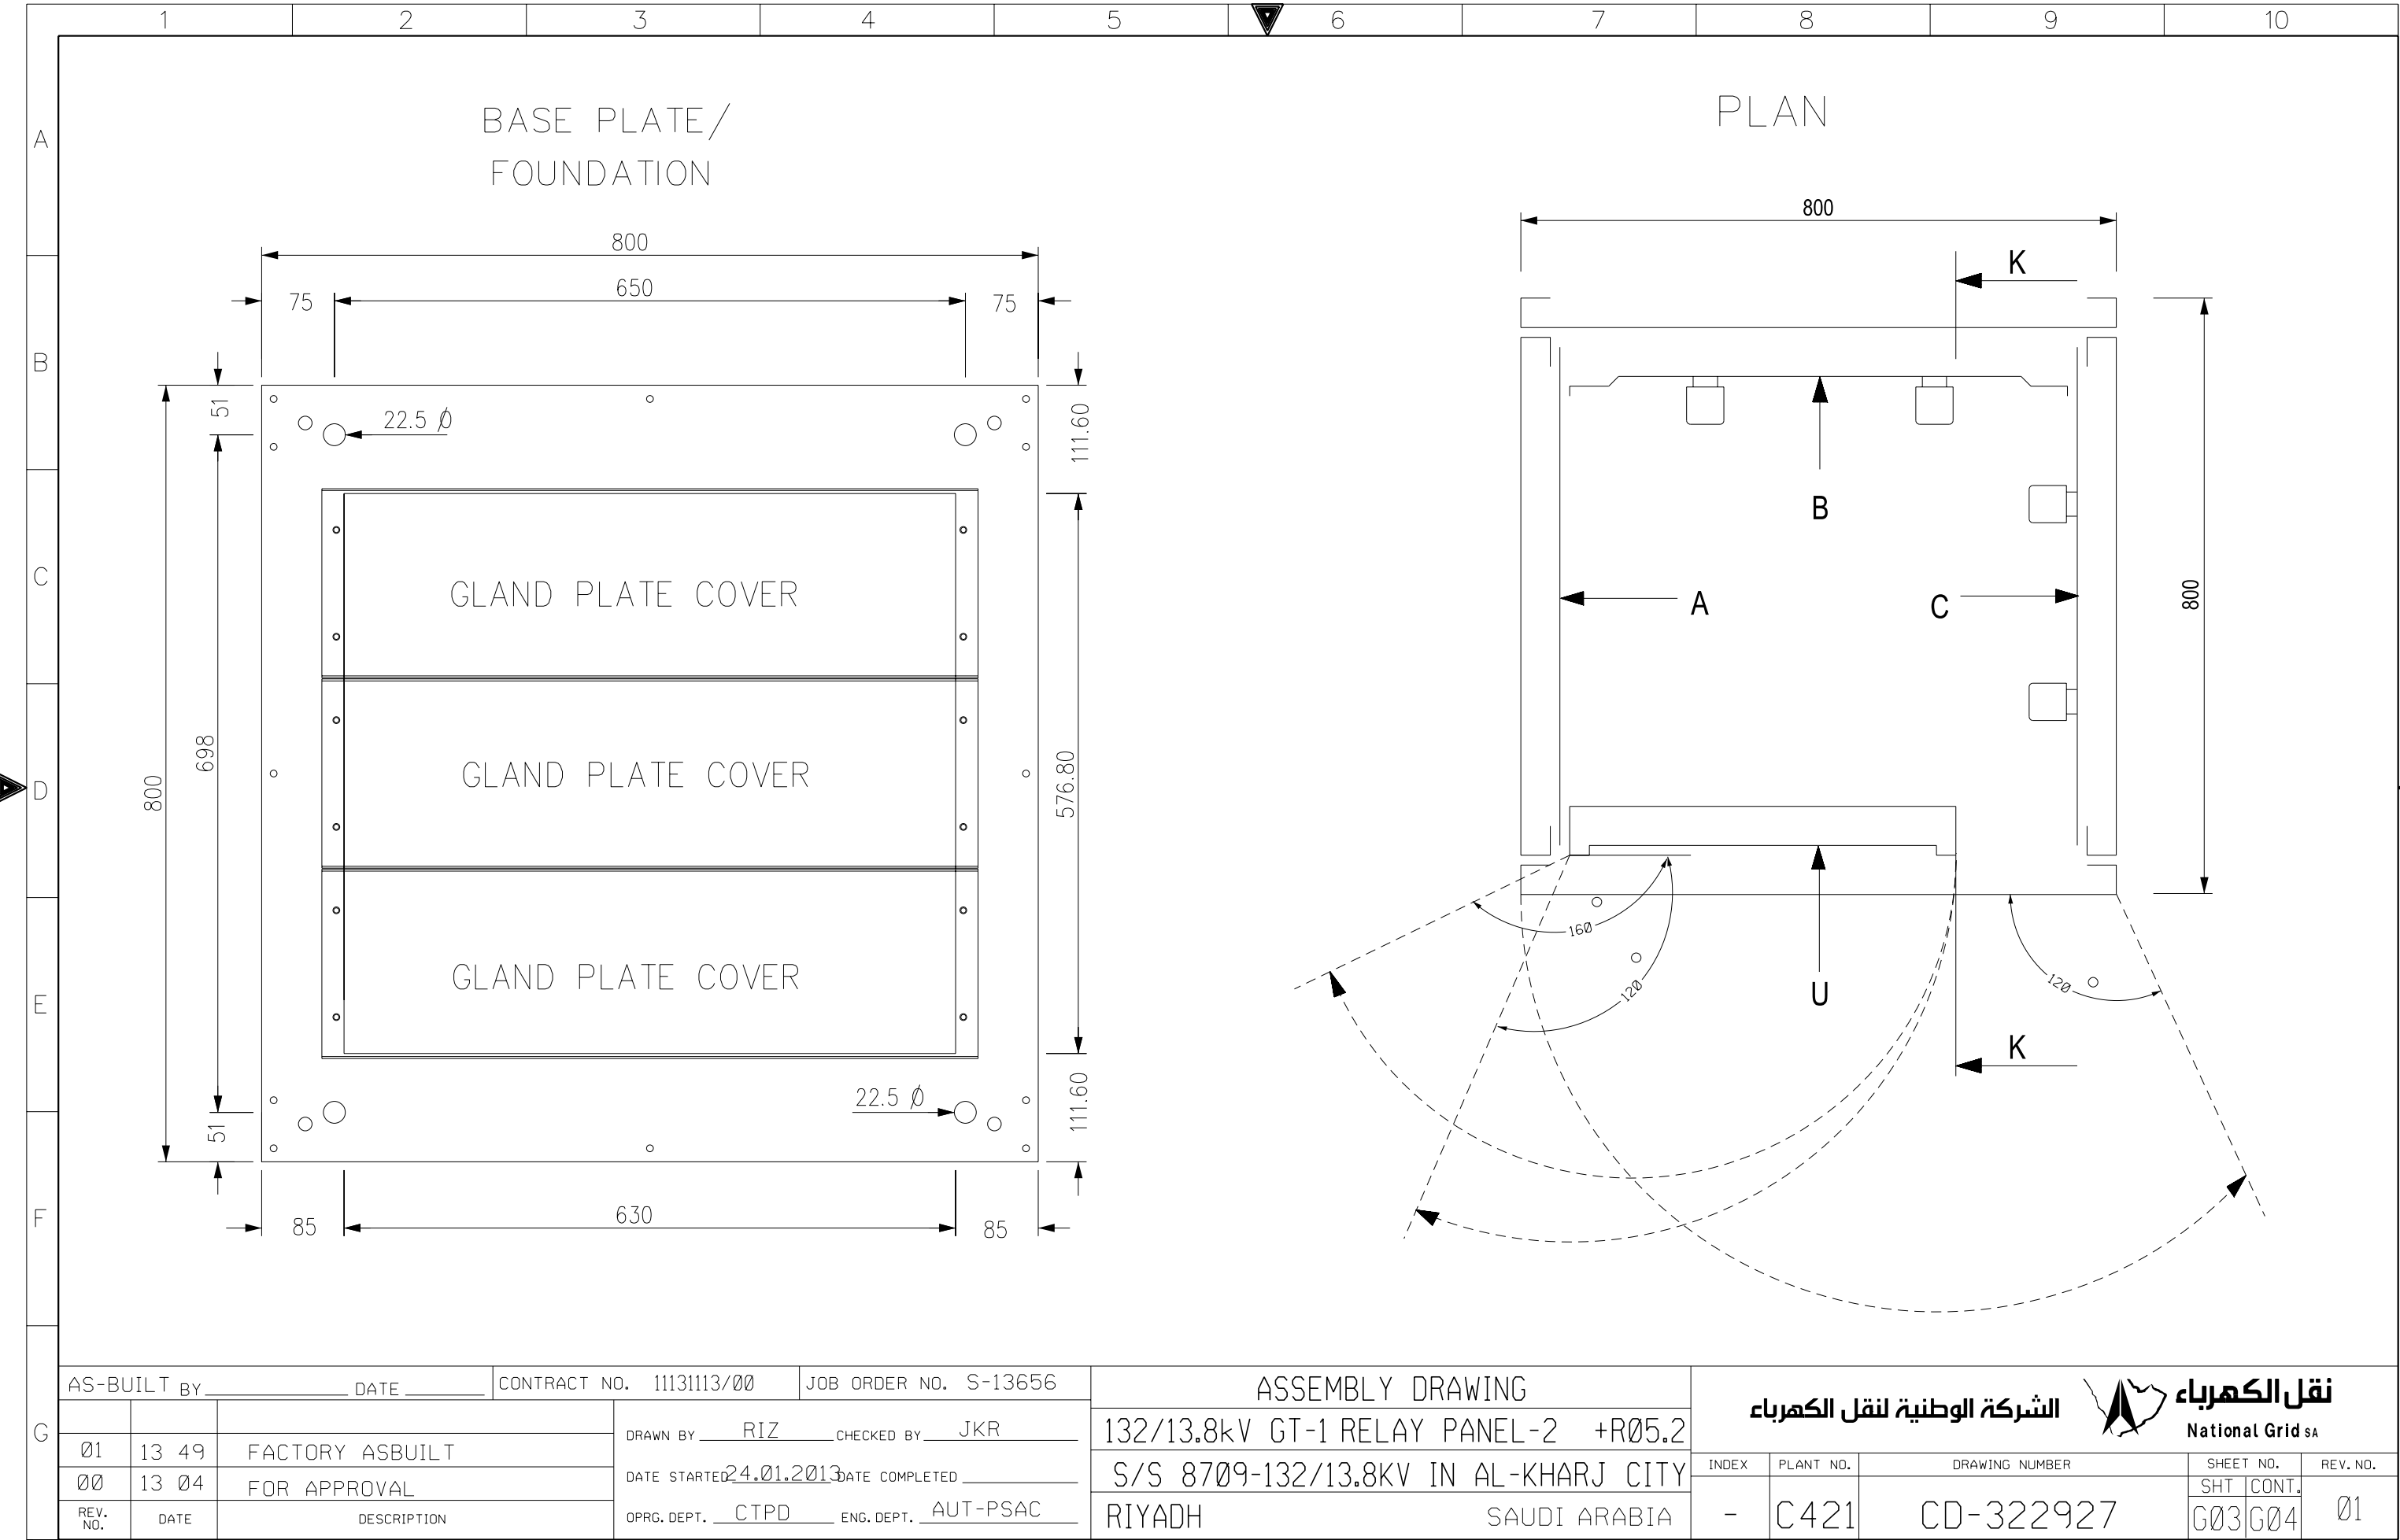
PLANE – B


SCH.REF	DESCRIPTION	TYPE	MAKE
X1	CT CIRCUITS	OTTA 6T P/P	PHOENIX
X2	VT CIRCUITS	D6/8.ST1.RS	ENTRELEC
X3	AC INCOMING CIRCUITS	D6/8.ST1.RS	ENTRELEC
X42	DC EXT. CIRCUITS	M6/8.RS	ENTRELEC
X52,X53	DC PROTN. CIRCUITS	M6/8.RS	ENTRELEC
XD	DC INCOMING CIRCUITS	IN540B	MEJDAF
XSH	SPACE HEATER	M6/8.RS	ENTRELEC

PLANE – C

SCH.REF	DESCRIPTION	TYPE	MAKE
XTJ	TELEPHONE JACK	M6/8.RS	ENTRELEC
X6	ALARM SUPPLY	M6/8.RS	ENTRELEC
X62	ALARM CIRCUITS	M6/8.RS	ENTRELEC
X92	SPARE CIRCUITS	M6/8.RS	ENTRELEC

G	AS-BUILT BY _____ DATE _____		CONTRACT NO. 11131113/00		JOB ORDER NO. S-13656		ASSEMBLY DRAWING		الشركة الوطنية لنقل الكهرباء		 نقل الكهرباء National Grid sa				
	01	13 49	FACTORY ASBUILT		DRAWN BY RIZ CHECKED BY JKR		132/13.8kV GT-1 RELAY PANEL-2 +R05.2		INDEX	PLANT NO.	DRAWING NUMBER		SHEET NO.		REV. NO.
	00	13 04	FOR APPROVAL		DATE STARTED 24.01.2013 DATE COMPLETED _____		S/S 8709-132/13.8KV IN AL-KHARJ CITY		-	C421	CD-322927		SHT	CONT.	01
	REV. NO.	DATE	DESCRIPTION		OPRG. DEPT. CTPD ENG. DEPT. AUT-PSAC		RIYADH SAUDI ARABIA						G02	G03	



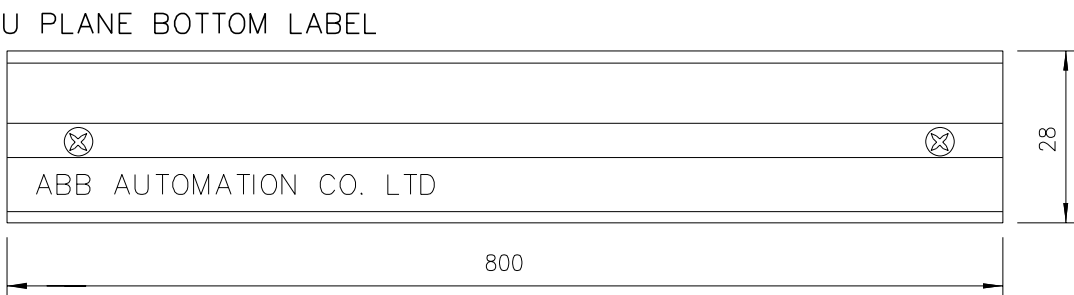

MANUFACTURING LABEL



PROJECT	:	National Grid SA S/S 8709
ORDER REFERENCE	:	2875 RF S13656
YEAR OF MANUFACTURE:	:	2013
PANEL NO.	:	+R05.2
DRAWING NO.	:	S13656-CD-323928

MADE IN THE KINGDOM OF SAUDI ARABIA

AS-BUILT BY _____ DATE _____	CONTRACT NO. 11131113/00	JOB ORDER NO. S-13656
------------------------------	--------------------------	-----------------------

			DRAWN BY <u>RIZ</u> CHECKED BY <u>JKR</u>
01	13 49	FACTORY ASBUILT	DATE STARTED <u>24.01.2013</u> DATE COMPLETED _____
00	13 04	FOR APPROVAL	
REV. NO.	DATE	DESCRIPTION	OPRG. DEPT. <u>CTPD</u> ENG. DEPT. <u>AUT-PSAC</u>

ASSEMBLY DRAWING

132/13.8kV GT-1 RELAY PANEL-2 +R05.2
--------------------------------------

S/S 8709-132/13.8KV IN AL-KHARJ CITY
--------------------------------------

RIYADH	SAUDI ARABIA
--------	--------------

## الشركة الوطنية لنقل الكهرباء







INDEX	PLANT NO.	DRAWING NUMBER	SHEET NO.		REV. NO.
-	C421	CD-322927	SHT	CONT.	01
			G04	L00	

NG/D2-D (2012/01)

DMS

VECTOR

NGD200

	1	2	3	4	5	6	7	8	9	10																																																																																																																									
A			POWER SYSTEMS NETWORK MANAGEMENT PROTECTION AND SUBSTATION AUTOMATION SYSTEMS WBS NO: S-13656					ABB AUTOMATION COMPANY LTD., 414, AL-KHARJ ROAD SECOND INDUSTRIAL CITY RIYADH-11383 K.S.A																																																																																																																											
B																																																																																																																																			
C	CONTRACTOR : ABB Contracting Company																																																																																																																																		
	CLIENT : National Gridsa																																																																																																																																		
D	PROJECT : CONSTRUCTION OF NEW 132/13.8kV SS 8709 IN AL-KHARJ CITY																																																																																																																																		
	SUBSTATION : S/S 8709																																																																																																																																		
E	CONTRACT NO. : 11131113/00																																																																																																																																		
	TITLE : LIST OF APPARATUS +R05.2 [GT-1]																																																																																																																																		
F																																																																																																																																			
G	<table><tr><td colspan="3">AS-BUILT BY _____ DATE _____</td><td colspan="2">CONTRACT NO. 11131113/00</td><td colspan="2">JOB ORDER NO. S-13656</td><td colspan="2">LIST OF APPARATUS</td><td colspan="2"><div>الشركة الوطنية لنقل الكهرباء</div><div> نقل الكهرباء National Grid sa</div></td></tr><tr><td></td><td></td><td></td><td colspan="2">DRAWN BY RIZ</td><td colspan="2">CHECKED BY JKR</td><td colspan="2">132/13.8kV GT-1 RELAY PANEL-2 +R05.2</td><td colspan="2">INDEX</td></tr><tr><td></td><td>01</td><td>13 49</td><td colspan="2">FACTORY ASBUILT</td><td colspan="2">DATE STARTED 24.01.2013</td><td colspan="2">S/S 8709-132/13.8KV IN AL-KHARJ CITY</td><td colspan="2">PLANT NO.</td></tr><tr><td></td><td>00</td><td>13 04</td><td colspan="2">FOR APPROVAL</td><td colspan="2">DATE COMPLETED _____</td><td colspan="2">RIYADH SAUDI ARABIA</td><td colspan="2">DRAWING NUMBER</td></tr><tr><td></td><td>REV. NO.</td><td>DATE</td><td colspan="2">DESCRIPTION</td><td colspan="2">OPRG. DEPT. CTPD</td><td colspan="2">ENG. DEPT. AUT-PSAC</td><td colspan="2">SHEET NO.</td></tr><tr><td></td><td></td><td></td><td colspan="2"></td><td colspan="2"></td><td colspan="2"></td><td colspan="2">SHT</td></tr><tr><td></td><td></td><td></td><td colspan="2"></td><td colspan="2"></td><td colspan="2"></td><td colspan="2">CONT.</td></tr><tr><td></td><td></td><td></td><td colspan="2"></td><td colspan="2"></td><td colspan="2"></td><td colspan="2">REV. NO.</td></tr><tr><td></td><td></td><td></td><td colspan="2"></td><td colspan="2"></td><td colspan="2"></td><td colspan="2">01</td></tr><tr><td></td><td></td><td></td><td colspan="2"></td><td colspan="2"></td><td colspan="2"></td><td colspan="2">L00</td></tr><tr><td></td><td></td><td></td><td colspan="2"></td><td colspan="2"></td><td colspan="2"></td><td colspan="2">L01</td></tr></table>										AS-BUILT BY _____ DATE _____			CONTRACT NO. 11131113/00		JOB ORDER NO. S-13656		LIST OF APPARATUS		<div>الشركة الوطنية لنقل الكهرباء</div> <div> نقل الكهرباء National Grid sa</div>					DRAWN BY RIZ		CHECKED BY JKR		132/13.8kV GT-1 RELAY PANEL-2 +R05.2		INDEX			01	13 49	FACTORY ASBUILT		DATE STARTED 24.01.2013		S/S 8709-132/13.8KV IN AL-KHARJ CITY		PLANT NO.			00	13 04	FOR APPROVAL		DATE COMPLETED _____		RIYADH SAUDI ARABIA		DRAWING NUMBER			REV. NO.	DATE	DESCRIPTION		OPRG. DEPT. CTPD		ENG. DEPT. AUT-PSAC		SHEET NO.											SHT											CONT.											REV. NO.											01											L00											L01	
AS-BUILT BY _____ DATE _____			CONTRACT NO. 11131113/00		JOB ORDER NO. S-13656		LIST OF APPARATUS		<div>الشركة الوطنية لنقل الكهرباء</div> <div> نقل الكهرباء National Grid sa</div>																																																																																																																										
			DRAWN BY RIZ		CHECKED BY JKR		132/13.8kV GT-1 RELAY PANEL-2 +R05.2		INDEX																																																																																																																										
	01	13 49	FACTORY ASBUILT		DATE STARTED 24.01.2013		S/S 8709-132/13.8KV IN AL-KHARJ CITY		PLANT NO.																																																																																																																										
	00	13 04	FOR APPROVAL		DATE COMPLETED _____		RIYADH SAUDI ARABIA		DRAWING NUMBER																																																																																																																										
	REV. NO.	DATE	DESCRIPTION		OPRG. DEPT. CTPD		ENG. DEPT. AUT-PSAC		SHEET NO.																																																																																																																										
									SHT																																																																																																																										
									CONT.																																																																																																																										
									REV. NO.																																																																																																																										
									01																																																																																																																										
									L00																																																																																																																										
									L01																																																																																																																										

NG/D2-D (2012/01)

DMS

VECTOR

NGD200



	1	2	3	4	5	6	7	8	9	10
A										
B										
C										
D										
E										
F										
G										

AS-BUILT BY _____ DATE _____		CONTRACT NO. 11131113/00		JOB ORDER NO. S-13656		LIST OF APPARATUS		<div>الشركة الوطنية لنقل الكهرباء</div> <div> نقل الكهرباء National Grid sa</div>			
01	13 49	FACTORY ASBUILT	DRAWN BY RIZ CHECKED BY JKR		132/13.8kV GT-1 RELAY PANEL-2 +R05.2		INDEX	PLANT NO.	DRAWING NUMBER	SHEET NO.	REV. NO.
00	13 04	FOR APPROVAL	DATE STARTED 24.01.2013 DATE COMPLETED _____		S/S 8709-132/13.8KV IN AL-KHARJ CITY					SHT	CONT.
REV. NO.	DATE	DESCRIPTION	OPRG. DEPT. CTPD ENG. DEPT. AUT-PSAC		RIYADH SAUDI ARABIA		-	C421	CD-322927	L02	L03
											01

NG/D2-D (2012/01)




DMS VECTOR

NGD200





1		2		3		4		5		6		7		8		9		10																																																																																																								
A	<table><tr><th>SR. NO.</th><th>GA REF.</th><th>SCH. REF.</th><th>D E S C R I P T I O N</th><th>SHT.</th><th>QTY.</th><th>TYPE</th><th>MAKE</th><th>ORDER INFORMATION</th></tr><tr><td>10</td><td></td><td></td><td>MCB 2 POLE 6A, FOR DC SUPPLY WITH 2NC AUXILIARY CONTACT</td><td>416</td><td>3</td><td>S282 UC K6 S2-H02</td><td>ABB</td><td>GHS S282 0164 R0317 GH S270 191 6R0003</td></tr><tr><td></td><td>U39.5001</td><td>Q1</td><td>R2€ SUPPLY</td><td></td><td></td><td></td><td></td><td></td></tr><tr><td></td><td>U39.5002</td><td>Q2</td><td>R3€ SUPPLY</td><td></td><td></td><td></td><td></td><td></td></tr><tr><td></td><td>U36.5001</td><td>Q3</td><td>TC2 SUPPLY</td><td></td><td></td><td></td><td></td><td></td></tr></table>																			SR. NO.	GA REF.	SCH. REF.	D E S C R I P T I O N	SHT.	QTY.	TYPE	MAKE	ORDER INFORMATION	10			MCB 2 POLE 6A, FOR DC SUPPLY WITH 2NC AUXILIARY CONTACT	416	3	S282 UC K6 S2-H02	ABB	GHS S282 0164 R0317 GH S270 191 6R0003		U39.5001	Q1	R2€ SUPPLY							U39.5002	Q2	R3€ SUPPLY							U36.5001	Q3	TC2 SUPPLY																																																															
	SR. NO.	GA REF.	SCH. REF.	D E S C R I P T I O N	SHT.	QTY.	TYPE	MAKE	ORDER INFORMATION																																																																																																																	
	10			MCB 2 POLE 6A, FOR DC SUPPLY WITH 2NC AUXILIARY CONTACT	416	3	S282 UC K6 S2-H02	ABB	GHS S282 0164 R0317 GH S270 191 6R0003																																																																																																																	
		U39.5001	Q1	R2€ SUPPLY																																																																																																																						
		U39.5002	Q2	R3€ SUPPLY																																																																																																																						
	U36.5001	Q3	TC2 SUPPLY																																																																																																																							
B	<table><tr><td>11</td><td>U39.5003</td><td>C01</td><td>CONVENIENCE OUTLET 10A, 127V AC</td><td>411</td><td>2</td><td>USM45&amp;USMS45</td><td>ABB</td><td>74140 &amp; 74180</td></tr><tr><td></td><td></td><td>C02</td><td>CONVENIENCE OUTLET 10A, 220V AC</td><td></td><td></td><td></td><td></td><td></td></tr><tr><td></td><td></td><td>C1,C2</td><td>MINIATURE CIRCUIT BREAKER, 2 POLE, 10A FOR CONVENIENCE OUTLET WITH AUXILIARY SWITCH, 1NO + 1NC CONTACTS</td><td>411</td><td>2</td><td>S202-C10 S2C-H11L</td><td>ABB</td><td>2CDS 252 001 R0427 GH 270 1917 R001</td></tr><tr><td></td><td></td><td>C3</td><td>THERMOSTAT FOR SPACE HEATER, 5-35°C</td><td>411</td><td>1</td><td>SK 3110</td><td>RITTAL</td><td>SK 3110</td></tr><tr><td></td><td></td><td></td><td></td><td></td><td></td><td></td><td></td><td></td></tr></table>																			11	U39.5003	C01	CONVENIENCE OUTLET 10A, 127V AC	411	2	USM45&USMS45	ABB	74140 & 74180			C02	CONVENIENCE OUTLET 10A, 220V AC								C1,C2	MINIATURE CIRCUIT BREAKER, 2 POLE, 10A FOR CONVENIENCE OUTLET WITH AUXILIARY SWITCH, 1NO + 1NC CONTACTS	411	2	S202-C10 S2C-H11L	ABB	2CDS 252 001 R0427 GH 270 1917 R001			C3	THERMOSTAT FOR SPACE HEATER, 5-35°C	411	1	SK 3110	RITTAL	SK 3110																																																																			
	11	U39.5003	C01	CONVENIENCE OUTLET 10A, 127V AC	411	2	USM45&USMS45	ABB	74140 & 74180																																																																																																																	
			C02	CONVENIENCE OUTLET 10A, 220V AC																																																																																																																						
			C1,C2	MINIATURE CIRCUIT BREAKER, 2 POLE, 10A FOR CONVENIENCE OUTLET WITH AUXILIARY SWITCH, 1NO + 1NC CONTACTS	411	2	S202-C10 S2C-H11L	ABB	2CDS 252 001 R0427 GH 270 1917 R001																																																																																																																	
			C3	THERMOSTAT FOR SPACE HEATER, 5-35°C	411	1	SK 3110	RITTAL	SK 3110																																																																																																																	
C	<table><tr><td>12</td><td>U39.5004</td><td>TJ</td><td>TELEPHONE JACK 1GANG 4WIRE</td><td>411</td><td>1</td><td>EDF410</td><td>EDISON</td><td>EDF410</td></tr><tr><td></td><td></td><td></td><td></td><td></td><td></td><td></td><td></td><td></td></tr><tr><td></td><td></td><td>C7</td><td>ON/OFF SWITCH FOR SPACE HEATER</td><td>411</td><td>1</td><td>M2SS1-10B</td><td>ABB</td><td>1SFA 611 200 R1006</td></tr><tr><td></td><td></td><td>DS</td><td>DOOR SWITCH FOR CONTROL OF CUBICLE INTERNAL ILLUMINATION LAMP</td><td>411</td><td>1</td><td>LS30P</td><td>ABB</td><td>1SFA 611 605 R1101 1SBV 010 213 R1202</td></tr><tr><td></td><td></td><td></td><td></td><td></td><td></td><td></td><td></td><td></td></tr></table>																			12	U39.5004	TJ	TELEPHONE JACK 1GANG 4WIRE	411	1	EDF410	EDISON	EDF410												C7	ON/OFF SWITCH FOR SPACE HEATER	411	1	M2SS1-10B	ABB	1SFA 611 200 R1006			DS	DOOR SWITCH FOR CONTROL OF CUBICLE INTERNAL ILLUMINATION LAMP	411	1	LS30P	ABB	1SFA 611 605 R1101 1SBV 010 213 R1202																																																																			
	12	U39.5004	TJ	TELEPHONE JACK 1GANG 4WIRE	411	1	EDF410	EDISON	EDF410																																																																																																																	
			C7	ON/OFF SWITCH FOR SPACE HEATER	411	1	M2SS1-10B	ABB	1SFA 611 200 R1006																																																																																																																	
			DS	DOOR SWITCH FOR CONTROL OF CUBICLE INTERNAL ILLUMINATION LAMP	411	1	LS30P	ABB	1SFA 611 605 R1101 1SBV 010 213 R1202																																																																																																																	
D	<table><tr><td></td><td></td><td>IL</td><td>INTERNAL ILLUMINATION CUBICLE LAMP SUITABLE FOR 127V AC, 60Hz SUPPLY</td><td>411</td><td>1</td><td>T4</td><td>SUNON</td><td>SP-20W</td></tr><tr><td></td><td></td><td></td><td></td><td></td><td></td><td></td><td></td><td></td></tr><tr><td></td><td></td><td>SH</td><td>SPACE HEATER, 150W, 120V, 60Hz</td><td>411</td><td>1</td><td>RICA</td><td>GRUPPO</td><td>1FZEK006C001</td></tr><tr><td></td><td></td><td></td><td></td><td></td><td></td><td></td><td></td><td></td></tr><tr><td></td><td></td><td></td><td></td><td></td><td></td><td></td><td></td><td></td></tr></table>																					IL	INTERNAL ILLUMINATION CUBICLE LAMP SUITABLE FOR 127V AC, 60Hz SUPPLY	411	1	T4	SUNON	SP-20W												SH	SPACE HEATER, 150W, 120V, 60Hz	411	1	RICA	GRUPPO	1FZEK006C001																																																																												
			IL	INTERNAL ILLUMINATION CUBICLE LAMP SUITABLE FOR 127V AC, 60Hz SUPPLY	411	1	T4	SUNON	SP-20W																																																																																																																	
			SH	SPACE HEATER, 150W, 120V, 60Hz	411	1	RICA	GRUPPO	1FZEK006C001																																																																																																																	
E	<table><tr><td>13</td><td></td><td>R1</td><td>FIXED RESISTOR FOR TRIP CIRCUIT SUPERVISION CKT.</td><td>491</td><td>2</td><td>GRF 30/200</td><td>DANOTHERM</td><td>GRF 30/200</td></tr><tr><td></td><td></td><td>R2</td><td>2.5Kohm,15W</td><td></td><td></td><td></td><td></td><td></td></tr><tr><td></td><td></td><td></td><td></td><td></td><td></td><td></td><td></td><td></td></tr><tr><td></td><td></td><td></td><td></td><td></td><td></td><td></td><td></td><td></td></tr><tr><td></td><td></td><td></td><td></td><td></td><td></td><td></td><td></td><td></td></tr></table>																			13		R1	FIXED RESISTOR FOR TRIP CIRCUIT SUPERVISION CKT.	491	2	GRF 30/200	DANOTHERM	GRF 30/200			R2	2.5Kohm,15W																																																																																										
	13		R1	FIXED RESISTOR FOR TRIP CIRCUIT SUPERVISION CKT.	491	2	GRF 30/200	DANOTHERM	GRF 30/200																																																																																																																	
			R2	2.5Kohm,15W																																																																																																																						
F	<table><tr><td></td><td></td><td></td><td></td><td></td><td></td><td></td><td></td><td></td></tr><tr><td></td><td></td><td></td><td></td><td></td><td></td><td></td><td></td><td></td></tr><tr><td></td><td></td><td></td><td></td><td></td><td></td><td></td><td></td><td></td></tr><tr><td></td><td></td><td></td><td></td><td></td><td></td><td></td><td></td><td></td></tr><tr><td></td><td></td><td></td><td></td><td></td><td></td><td></td><td></td><td></td></tr></table>																																																																																																																									
G	<table><tr><td colspan="3">AS-BUILT BY _____ DATE _____</td><td colspan="3">CONTRACT NO. 11131113/00</td><td colspan="3">JOB ORDER NO. S-13656</td><td colspan="3">LIST OF APPARATUS</td><td colspan="6" rowspan="2"><div>الشركة الوطنية لنقل الكهرباء</div><div>نقل الكهرباء</div><div>National Grid sa</div></td></tr><tr><td></td><td></td><td></td><td></td><td></td><td></td><td></td><td></td><td></td><td></td><td></td><td></td><td></td><td></td><td></td><td></td><td></td><td></td><td></td></tr><tr><td>01</td><td>13 49</td><td>FACTORY ASBUILT</td><td colspan="3">DRAWN BY RIZ CHECKED BY JKR</td><td colspan="3">132/13.8kV GT-1 RELAY PANEL-2 +R05.2</td><td colspan="3">INDEX</td><td colspan="3">PLANT NO.</td><td colspan="3">DRAWING NUMBER</td><td colspan="2">SHEET NO.</td><td colspan="2">REV. NO.</td></tr><tr><td>00</td><td>13 04</td><td>FOR APPROVAL</td><td colspan="3">DATE STARTED 24.01.2013 DATE COMPLETED _____</td><td colspan="3">S/S 8709-132/13.8KV IN AL-KHARJ CITY</td><td colspan="3"></td><td colspan="3"></td><td colspan="3"></td><td colspan="2"></td><td colspan="2"></td></tr><tr><td>REV. NO.</td><td>DATE</td><td>DESCRIPTION</td><td colspan="3">OPRG. DEPT. CTPD ENG. DEPT. AUT-PSAC</td><td colspan="3">RIYADH SAUDI ARABIA</td><td colspan="3"></td><td colspan="3">C421</td><td colspan="3">CD-322927</td><td colspan="2">L03 L04</td><td colspan="2">01</td></tr></table>																			AS-BUILT BY _____ DATE _____			CONTRACT NO. 11131113/00			JOB ORDER NO. S-13656			LIST OF APPARATUS			<div>الشركة الوطنية لنقل الكهرباء</div> <div>نقل الكهرباء</div> <div>National Grid sa</div>																									01	13 49	FACTORY ASBUILT	DRAWN BY RIZ CHECKED BY JKR			132/13.8kV GT-1 RELAY PANEL-2 +R05.2			INDEX			PLANT NO.			DRAWING NUMBER			SHEET NO.		REV. NO.		00	13 04	FOR APPROVAL	DATE STARTED 24.01.2013 DATE COMPLETED _____			S/S 8709-132/13.8KV IN AL-KHARJ CITY																REV. NO.	DATE	DESCRIPTION	OPRG. DEPT. CTPD ENG. DEPT. AUT-PSAC			RIYADH SAUDI ARABIA						C421			CD-322927			L03 L04		01	
	AS-BUILT BY _____ DATE _____			CONTRACT NO. 11131113/00			JOB ORDER NO. S-13656			LIST OF APPARATUS			<div>الشركة الوطنية لنقل الكهرباء</div> <div>نقل الكهرباء</div> <div>National Grid sa</div>																																																																																																													
	01	13 49	FACTORY ASBUILT	DRAWN BY RIZ CHECKED BY JKR			132/13.8kV GT-1 RELAY PANEL-2 +R05.2			INDEX			PLANT NO.			DRAWING NUMBER			SHEET NO.		REV. NO.																																																																																																					
	00	13 04	FOR APPROVAL	DATE STARTED 24.01.2013 DATE COMPLETED _____			S/S 8709-132/13.8KV IN AL-KHARJ CITY																																																																																																																			
REV. NO.	DATE	DESCRIPTION	OPRG. DEPT. CTPD ENG. DEPT. AUT-PSAC			RIYADH SAUDI ARABIA						C421			CD-322927			L03 L04		01																																																																																																						



	1	2	3	4	5	6	7	8	9	10
A										
B	SR. NO.	GA REF.	SCH. REF.	D E S C R I P T I O N		SHEET. NO.	QTY.	TYPE	MAKE	ORDERING INFORMATION
	13		X1	BLOT CONNECTING TERMINAL BLOCKS DISCONNECTIBLE FOR CT CIRCUITS		502	45	OTTA 6T P/P	PHOENIX	0790462
			X2	SPRING LOADED TERMINAL BLOCKS DISCONNECTIBLE FOR VT CIRCUITS		502	10	D6/8.ST1.RS	ENTRELEC	1SNA 115 831 R0400
C			X3	SPRING LOADED TERMINAL BLOCKS DISCONNECTIBLE FOR AC CIRCUITS		502	10	D6/8.ST1.RS	ENTRELEC	1SNA 115 831 R0400
			X42	SPRING LOADED TERMINAL BLOCK FOR DC EXT. CIRCUITS		502	20	D6/8.ST1.RS	ENTRELEC	1SNA 115 831 R0400
			X52	SPRING LOADED TERMINAL BLOCK FOR DC PROTN. CIRCUITS		502	90	M6/8.RS	ENTRELEC	1SNA 115 685 R1200
D			X6	SPRING LOADED TERMINAL BLOCKS DISCONNECTIBLE FOR STN.-COM ALARM CIRCUITS		502	5	M6/8.RS	ENTRELEC	1SNA 115 685 R1200
			X62	KNIFE TYPE TERMINAL BLOCKS DISCONNECTIBLE FOR STN.-COM ALARM CIRCUITS		502	20	M6/8.SNB	ENTRELEC	1SNA 115 688 R2500
			XTJ	SPRING LOADED TERMINAL BLOCK KNIFE FOR TELEPHONE JACK		502	5	M6/8.RS	ENTRELEC	1SNA 115 685 R1200
E			XSH	SPRING LOADED TERMINAL BLOCKS FOR SPACE HEATER		502	3	M6/8.RS	ENTRELEC	1SNA 115 685 R1200
			XD	TERMINAL BLOCKS WITH BLOCKING DIODE, Vrrm=1kV, If=3A AND SURGE TRAP, ENERGY ABSORPTION RATING 8J (10/1000mS)		436	10	M4/6.S IN5408 V150ZA1	ENTRELEC MEJDAF RS	11521310 02-049 239-270
			X92	SPRING LOADED TERMINAL BLOCK KNIFE TYPE FOR SPARE CONTACTS		502	20	M6/8.RS	ENTRELEC	1SNA 115 685 R1200
F			X53	SPRING LOADED TERMINAL BLOCK FOR DC PROTN. CIRCUITS		502	25	M6/8.RS	ENTRELEC	1SNA 115 685 R1200
G	AS-BUILT BY _____ DATE _____		CONTRACT NO. 11131113/00		JOB ORDER NO. S-13656		LIST OF APPARATUS			
	01	13 49	FACTORY ASBUILT		DRAWN BY RIZ CHECKED BY JKR		132/13.8kV GT-1 RELAY PANEL-2 +R05.2			
	00	13 04	FOR APPROVAL		DATE STARTED 24.01.2013 DATE COMPLETED _____		S/S 8709-132/13.8KV IN AL-KHARJ CITY			
	REV. NO.	DATE	DESCRIPTION		OPRG. DEPT. CTPD ENG. DEPT. AUT-PSAC		RIYADH SAUDI ARABIA		INDEX PLANT NO. DRAWING NUMBER SHEET NO. REV. NO.	
							- C421 CD-322927		L04 L05 01	

	1	2	3	4	5	6	7	8	9	10																																																	
A																																																											
B																																																											
C																																																											
D																																																											
E																																																											
F																																																											
G	<table><tr><td colspan="3">AS-BUILT BY _____ DATE _____</td><td colspan="2">CONTRACT NO. 11131113/00</td><td colspan="2">JOB ORDER NO. S-13656</td><td colspan="3">LIST OF APPARATUS</td><td colspan="2"><div>الشركة الوطنية لنقل الكهرباء</div><div> نقل الكهرباء National Grid sa</div></td></tr><tr><td rowspan="3"><div>01</div><div>00</div><div>REV. NO.</div></td><td rowspan="3"><div>13 49</div><div>13 04</div><div>DATE</div></td><td colspan="2">FACTORY ASBUILT</td><td colspan="2">DRAWN BY <u>RIZ</u> CHECKED BY <u>JKR</u></td><td colspan="3">132/13.8kV GT-1 RELAY PANEL-2 +R05.2</td><td>INDEX</td><td>PLANT NO.</td><td>DRAWING NUMBER</td><td colspan="2">SHEET NO.</td><td>REV. NO.</td></tr><tr><td colspan="2">FOR APPROVAL</td><td colspan="2">DATE STARTED <u>24.01.2013</u> DATE COMPLETED _____</td><td colspan="3">S/S 8709-132/13.8KV IN AL-KHARJ CITY</td><td rowspan="2">-</td><td rowspan="2">C421</td><td rowspan="2">CD-322927</td><td colspan="2">SHT CONT.</td><td rowspan="2">01</td></tr><tr><td colspan="2"></td><td colspan="2">OPRG. DEPT. <u>CTPD</u> ENG. DEPT. <u>AUT-PSAC</u></td><td colspan="3">RIYADH SAUDI ARABIA</td><td colspan="2">L05L06</td></tr></table>										AS-BUILT BY _____ DATE _____			CONTRACT NO. 11131113/00		JOB ORDER NO. S-13656		LIST OF APPARATUS			<div>الشركة الوطنية لنقل الكهرباء</div> <div> نقل الكهرباء National Grid sa</div>		<div>01</div> <div>00</div> <div>REV. NO.</div>	<div>13 49</div> <div>13 04</div> <div>DATE</div>	FACTORY ASBUILT		DRAWN BY <u>RIZ</u> CHECKED BY <u>JKR</u>		132/13.8kV GT-1 RELAY PANEL-2 +R05.2			INDEX	PLANT NO.	DRAWING NUMBER	SHEET NO.		REV. NO.	FOR APPROVAL		DATE STARTED <u>24.01.2013</u> DATE COMPLETED _____		S/S 8709-132/13.8KV IN AL-KHARJ CITY			-	C421	CD-322927	SHT CONT.		01			OPRG. DEPT. <u>CTPD</u> ENG. DEPT. <u>AUT-PSAC</u>		RIYADH SAUDI ARABIA			L05L06	
AS-BUILT BY _____ DATE _____			CONTRACT NO. 11131113/00		JOB ORDER NO. S-13656		LIST OF APPARATUS			<div>الشركة الوطنية لنقل الكهرباء</div> <div> نقل الكهرباء National Grid sa</div>																																																	
<div>01</div> <div>00</div> <div>REV. NO.</div>	<div>13 49</div> <div>13 04</div> <div>DATE</div>	FACTORY ASBUILT		DRAWN BY <u>RIZ</u> CHECKED BY <u>JKR</u>		132/13.8kV GT-1 RELAY PANEL-2 +R05.2			INDEX	PLANT NO.	DRAWING NUMBER	SHEET NO.		REV. NO.																																													
		FOR APPROVAL		DATE STARTED <u>24.01.2013</u> DATE COMPLETED _____		S/S 8709-132/13.8KV IN AL-KHARJ CITY			-	C421	CD-322927	SHT CONT.		01																																													
				OPRG. DEPT. <u>CTPD</u> ENG. DEPT. <u>AUT-PSAC</u>		RIYADH SAUDI ARABIA						L05L06																																															

	1	2	3	4	5	6	7	8	9	10																																																																															
A																																																																																									
B																																																																																									
C																																																																																									
D																																																																																									
E																																																																																									
F																																																																																									
G	<table><tr><td colspan="3">AS-BUILT BY _____ DATE _____</td><td colspan="2">CONTRACT NO. 11131113/00</td><td colspan="2">JOB ORDER NO. S-13656</td><td colspan="3">LIST OF APPARATUS</td><td colspan="2"><div>الشركة الوطنية لنقل الكهرباء</div><div>نقل الكهرباء</div><div>National Grid sa</div></td></tr><tr><td></td><td></td><td></td><td colspan="2">DRAWN BY RIZ</td><td colspan="2">CHECKED BY JKR</td><td colspan="3">132/13.8kv GT-1 RELAY PANEL-2 +R05.2</td><td>INDEX</td><td>PLANT NO.</td><td>DRAWING NUMBER</td><td colspan="2">SHEET NO.</td><td>REV. NO.</td></tr><tr><td></td><td>01</td><td>13 49</td><td colspan="2">FACTORY ASBUILT</td><td colspan="2">DATE STARTED 24.01.2013</td><td colspan="2">DATE COMPLETED</td><td colspan="3">S/S 8709-132/13.8KV IN AL-KHARJ CITY</td><td></td><td></td><td></td><td></td><td></td></tr><tr><td></td><td>00</td><td>13 04</td><td colspan="2">FOR APPROVAL</td><td colspan="2">OPRG. DEPT. CTPD</td><td colspan="2">ENG. DEPT. AUT-PSAC</td><td colspan="3">RIYADH SAUDI ARABIA</td><td>-</td><td>C421</td><td>CD-322927</td><td>L06000</td><td>01</td></tr><tr><td></td><td>REV. NO.</td><td>DATE</td><td colspan="2">DESCRIPTION</td><td colspan="2"></td><td colspan="2"></td><td colspan="3"></td><td></td><td></td><td></td><td></td><td></td></tr></table>										AS-BUILT BY _____ DATE _____			CONTRACT NO. 11131113/00		JOB ORDER NO. S-13656		LIST OF APPARATUS			<div>الشركة الوطنية لنقل الكهرباء</div> <div>نقل الكهرباء</div> <div>National Grid sa</div>					DRAWN BY RIZ		CHECKED BY JKR		132/13.8kv GT-1 RELAY PANEL-2 +R05.2			INDEX	PLANT NO.	DRAWING NUMBER	SHEET NO.		REV. NO.		01	13 49	FACTORY ASBUILT		DATE STARTED 24.01.2013		DATE COMPLETED		S/S 8709-132/13.8KV IN AL-KHARJ CITY									00	13 04	FOR APPROVAL		OPRG. DEPT. CTPD		ENG. DEPT. AUT-PSAC		RIYADH SAUDI ARABIA			-	C421	CD-322927	L06000	01		REV. NO.	DATE	DESCRIPTION													
AS-BUILT BY _____ DATE _____			CONTRACT NO. 11131113/00		JOB ORDER NO. S-13656		LIST OF APPARATUS			<div>الشركة الوطنية لنقل الكهرباء</div> <div>نقل الكهرباء</div> <div>National Grid sa</div>																																																																															
			DRAWN BY RIZ		CHECKED BY JKR		132/13.8kv GT-1 RELAY PANEL-2 +R05.2			INDEX	PLANT NO.	DRAWING NUMBER	SHEET NO.		REV. NO.																																																																										
	01	13 49	FACTORY ASBUILT		DATE STARTED 24.01.2013		DATE COMPLETED		S/S 8709-132/13.8KV IN AL-KHARJ CITY																																																																																
	00	13 04	FOR APPROVAL		OPRG. DEPT. CTPD		ENG. DEPT. AUT-PSAC		RIYADH SAUDI ARABIA			-	C421	CD-322927	L06000	01																																																																									
	REV. NO.	DATE	DESCRIPTION																																																																																						

	1	2	3	4	5	6	7	8	9	10																																																												
A			POWER SYSTEMS NETWORK MANAGEMENT PROTECTION AND SUBSTATION AUTOMATION SYSTEMS WBS NO: S-13656					ABB AUTOMATION COMPANY LTD. 414, AL-KHARJ ROAD SECOND INDUSTRIAL CITY RIYADH-11383 K.S.A																																																														
B																																																																						
C	CONTRACTOR : ABB Contracting Company																																																																					
	CLIENT : National Gridsa																																																																					
D	PROJECT : CONSTRUCTION OF NEW 132/13.8kV SS 8709 IN AL-KHARJ CITY																																																																					
	SUBSTATION : S/S 8709																																																																					
E	CONTRACT NO. : 11131113/00																																																																					
	TITLE : SCHEMATICS DRAWINGS (+R05.1,+R05.2)																																																																					
F																																																																						
G	<table><tr><td colspan="3">AS-BUILT BY _____ DATE _____</td><td colspan="2">CONTRACT NO. 11131113/00</td><td colspan="2">JOB ORDER NO. S-13656</td><td colspan="3">COVER SHEET</td><td colspan="2"> <b>نقل الكهرباء</b> الشركة الوطنية لنقل الكهرباء National Grid sa</td></tr><tr><td colspan="2">01</td><td colspan="1">13 49</td><td colspan="2">FACTORY ASBUILT</td><td colspan="2">DRAWN BY RIZ CHECKED BY JKR</td><td colspan="3">132/13.8KV GT-1 RELAY PANEL -+R05.1/+R05.2</td><td colspan="2">SHEET NO.</td></tr><tr><td colspan="2">00</td><td colspan="1">13 04</td><td colspan="2">FOR APPROVAL</td><td colspan="2">DATE STARTED 24.01.2013 DATE COMPLETED _____</td><td colspan="3">S/S 8709-132/13.8KV IN AL-KHARJ CITY</td><td colspan="2">REV. NO.</td></tr><tr><td colspan="2">REV. NO.</td><td colspan="1">DATE</td><td colspan="2">DESCRIPTION</td><td colspan="2">OPRG. DEPT. CTPD ENG. DEPT. AUT-PSAC</td><td colspan="3">RIYADH SAUDI ARABIA</td><td colspan="2">01</td></tr><tr><td colspan="2"></td><td colspan="1"></td><td colspan="2"></td><td colspan="2"></td><td colspan="3"></td><td colspan="2"></td></tr></table>										AS-BUILT BY _____ DATE _____			CONTRACT NO. 11131113/00		JOB ORDER NO. S-13656		COVER SHEET			 <b>نقل الكهرباء</b> الشركة الوطنية لنقل الكهرباء National Grid sa		01		13 49	FACTORY ASBUILT		DRAWN BY RIZ CHECKED BY JKR		132/13.8KV GT-1 RELAY PANEL -+R05.1/+R05.2			SHEET NO.		00		13 04	FOR APPROVAL		DATE STARTED 24.01.2013 DATE COMPLETED _____		S/S 8709-132/13.8KV IN AL-KHARJ CITY			REV. NO.		REV. NO.		DATE	DESCRIPTION		OPRG. DEPT. CTPD ENG. DEPT. AUT-PSAC		RIYADH SAUDI ARABIA			01													
AS-BUILT BY _____ DATE _____			CONTRACT NO. 11131113/00		JOB ORDER NO. S-13656		COVER SHEET			 <b>نقل الكهرباء</b> الشركة الوطنية لنقل الكهرباء National Grid sa																																																												
01		13 49	FACTORY ASBUILT		DRAWN BY RIZ CHECKED BY JKR		132/13.8KV GT-1 RELAY PANEL -+R05.1/+R05.2			SHEET NO.																																																												
00		13 04	FOR APPROVAL		DATE STARTED 24.01.2013 DATE COMPLETED _____		S/S 8709-132/13.8KV IN AL-KHARJ CITY			REV. NO.																																																												
REV. NO.		DATE	DESCRIPTION		OPRG. DEPT. CTPD ENG. DEPT. AUT-PSAC		RIYADH SAUDI ARABIA			01																																																												

THIS DRAWING AND THE INFORMATION CONTAINED HEREIN ARE THE SOLE PROPERTY OF National Grid SA

NO REPRODUCTION IN FULL OR IN PART SHALL BE OBTAINED FROM THIS DOCUMENT WITHOUT THE WRITTEN CONSENT OF ITS OWNER.


NG/D2-D (2012/01)

DMS VECTOR

NGD200



	1	2	3	4	5	6	7	8	9	10
A										
B										
C										
D										
E										
F										
G										





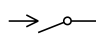
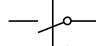
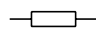

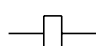



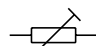

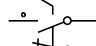
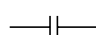
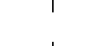
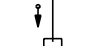
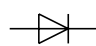








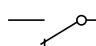
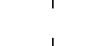

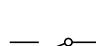
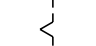
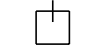
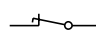
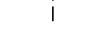

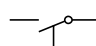

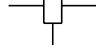
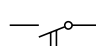
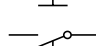









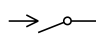
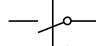
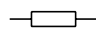

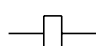



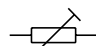

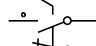
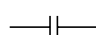
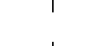
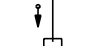
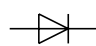




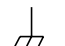
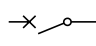
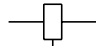

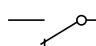
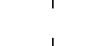

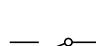
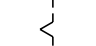
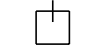
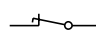
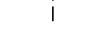

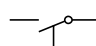

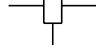
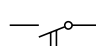
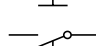









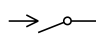
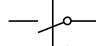
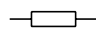

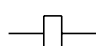


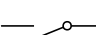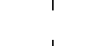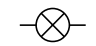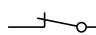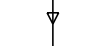
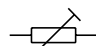

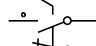
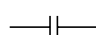
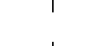
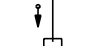
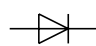


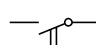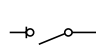
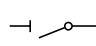
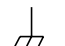
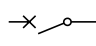
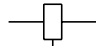

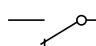
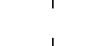

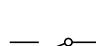
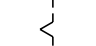
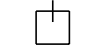
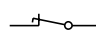
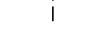

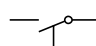

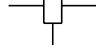
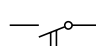
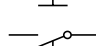





AS-BUILT BY _____ DATE _____			CONTRACT NO. 11131113/00		JOB ORDER NO. S-13656		CONTENTS SHEET		<div>الشركة الوطنية لنقل الكهرباء</div> <div> نقل الكهرباء National Grid sa</div>				
01	13 49	FACTORY ASBUILT	DRAWN BY RIZ CHECKED BY JKR			132/13.8KV GT-1 RELAY PANEL-1/2		INDEX	PLANT NO.	DRAWING NUMBER	SHEET NO.	REV. NO.	
00	13 04	FOR APPROVAL	DATE STARTED 24.01.2013 DATE COMPLETED _____			S/S 8709-132/13.8KV IN AL-KHARJ CITY		-	C421	CD-322928	SHT 002	CONT. 011	01
REV. NO.	DATE	DESCRIPTION	OPRG. DEPT. CTPD ENG. DEPT. AUT-PSAC			RIYADH SAUDI ARABIA							

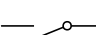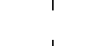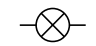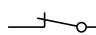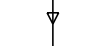NG/D2-D (2012/01)

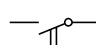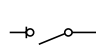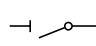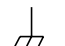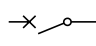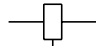DMS

VECTOR

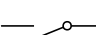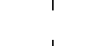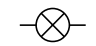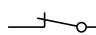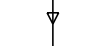NGD200

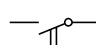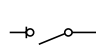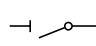1		2		3		4		5		6		7		8		9		10																																																																																																																																																																																																																																					
<table><tr><td colspan="2">SYMBOL</td><td colspan="2">DESCRIPTION</td><td colspan="2">SYMBOL</td><td colspan="2">DESCRIPTION</td><td colspan="2">SYMBOL</td><td colspan="2">DESCRIPTION</td></tr><tr><td colspan="2"></td><td colspan="2">FRAME CONNECTION</td><td colspan="2"></td><td colspan="2">MAIN CONTACT OF A CIRCUIT BREAKER</td><td colspan="2"></td><td colspan="2">RELAY WITH TWO MAKE CONTACTS, ONE OF THEM DELAYED WHEN OPERATING</td></tr><tr><td colspan="2"></td><td colspan="2">EARTH CONNECTION</td><td colspan="2"></td><td colspan="2">PASSING MAKE CONTACT CLOSING MOMENTARILY DURING OPERATION AND RELEASE</td><td colspan="2"></td><td colspan="2">RELAY WITH TWO ACTUATORS AND A TWO STABLE POSITIONS</td></tr><tr><td colspan="2"></td><td colspan="2">RESISTOR</td><td colspan="2"></td><td colspan="2">BREAK CONTACT DELAYED WHEN OPERATING</td><td colspan="2"></td><td colspan="2"></td></tr><tr><td colspan="2"></td><td colspan="2">VARIABLE RESISTOR</td><td colspan="2"></td><td colspan="2">MAKE CONTACT DELAYED WHEN RELEASING</td><td colspan="2"></td><td colspan="2">SIGNALLING LAMP</td></tr><tr><td colspan="2"></td><td colspan="2">RESISTOR WITH PRESET ADJUSTMENT</td><td colspan="2"></td><td colspan="2">TWO MECHANICAL LINKS CROSSING WITHOUT CONNECTION</td><td colspan="2"></td><td colspan="2">MECHANICAL INDICATOR WITH AUTOMATIC RESET</td></tr><tr><td colspan="2"></td><td colspan="2">CAPACITOR</td><td colspan="2"></td><td colspan="2">JUNCTION OF MECHANICAL LINKS</td><td colspan="2"></td><td colspan="2">MECHANICAL INDICATOR WITH NON-AUTOMATIC RESET</td></tr><tr><td colspan="2"></td><td colspan="2">SEMICONDUCTOR DIODE USED AS A CAPACITIVE DEVICE</td><td colspan="2"></td><td colspan="2">AUTOMATIC RESET</td><td colspan="2"></td><td colspan="2">ELECTRICALLY CONTROLLED MECHANICAL INDICATOR WITH AUTOMATIC RESET</td></tr><tr><td colspan="2"></td><td colspan="2">OPEN CONTACT, MAKE CONTACT</td><td colspan="2"></td><td colspan="2">NON-AUTOMATIC RESET</td><td colspan="2"></td><td colspan="2"></td></tr><tr><td colspan="2"></td><td colspan="2">CLOSED CONTACT, BREAK CONTACT</td><td colspan="2"></td><td colspan="2">SWITCHING DEVICE WITH MANUAL OPERATION AND WITH AUTOMATIC RESET</td><td colspan="2"></td><td colspan="2">RELAY WITH MAKE CONTACT</td></tr><tr><td colspan="2"></td><td colspan="2">CHANGE-OVER CONTACT, BREAK BEFORE MAKE</td><td colspan="2"></td><td colspan="2">SWITCHING DEVICE WITH MANUAL OPERATION AND WITH NON-AUTOMATIC RESET</td><td colspan="2"></td><td colspan="2">RELAY WITH CHANGE-OVER CONTACT</td></tr><tr><td colspan="2"></td><td colspan="2">MAKE CONTACT WHICH IS EARLY WHEN OPERATING AND LATE WHEN RELEASING</td><td colspan="2"></td><td colspan="2">CHANGE-OVER SWITCHING DEVICE WITH MANUAL CONTROL AUTOMATIC RESET FROM POSITION 1-2 TO THE NEUTRAL POSITION</td><td colspan="2"></td><td colspan="2">ELECTRO-MECHANICAL POSITION INDICATOR WITH ONE DE-ENERGIZED AND ONE OPERATED POSITION</td></tr><tr><td colspan="2"></td><td colspan="2">BREAK CONTACT WHICH IS LATE WHEN OPERATING AND EARLY WHEN RELEASING</td><td colspan="2"></td><td colspan="2">RELAY WITH MAKE CONTACT, DELAYED WHEN OPERATING</td><td colspan="2"></td><td colspan="2">ELECTRO-MECHANICAL POSITION INDICATOR WITH ONE DE-ENERGIZED AND TWO OPERATED POSITION</td></tr><tr><td colspan="2"></td><td colspan="2">SWITCHING DEVICE WITH MANUAL CONTROL</td><td colspan="2"></td><td colspan="2">RELAY WITH MAKE CONTACT, DELAYED WHEN RELEASING</td><td colspan="2"></td><td colspan="2">BELL, BUZZER</td></tr><tr><td colspan="2"></td><td colspan="2">MAKE CONTACT DELAYED WHEN OPERATING</td><td colspan="2"></td><td colspan="2">RELAY WITH MAKE CONTACT, DELAYED WHEN OPERATING AND RELEASING</td><td colspan="2"></td><td colspan="2">SIREN , HORN</td></tr><tr><td colspan="2"></td><td colspan="2">BREAK CONTACT DELAYED WHEN RELEASING</td><td colspan="2"></td><td colspan="2"></td><td colspan="2"></td><td colspan="2"></td></tr><tr><td colspan="2"></td><td colspan="2">MAKE CONTACT DELAYED WHEN OPERATING AND RELEASING</td><td colspan="2"></td><td colspan="2"></td><td colspan="2"></td><td colspan="2"></td></tr><tr><td colspan="2"></td><td colspan="2">MAIN CONTACT OF A SWITCH DISCONNECTOR</td><td colspan="2"></td><td colspan="2"></td><td colspan="2"></td><td colspan="2"></td></tr><tr><td colspan="2"></td><td colspan="2">MAIN CONTACT OF A DISCONNECTOR</td><td colspan="2"></td><td colspan="2"></td><td colspan="2"></td><td colspan="2"></td></tr></table>																				SYMBOL		DESCRIPTION		SYMBOL		DESCRIPTION		SYMBOL		DESCRIPTION				FRAME CONNECTION				MAIN CONTACT OF A CIRCUIT BREAKER				RELAY WITH TWO MAKE CONTACTS, ONE OF THEM DELAYED WHEN OPERATING				EARTH CONNECTION				PASSING MAKE CONTACT CLOSING MOMENTARILY DURING OPERATION AND RELEASE				RELAY WITH TWO ACTUATORS AND A TWO STABLE POSITIONS				RESISTOR				BREAK CONTACT DELAYED WHEN OPERATING								VARIABLE RESISTOR				MAKE CONTACT DELAYED WHEN RELEASING				SIGNALLING LAMP				RESISTOR WITH PRESET ADJUSTMENT				TWO MECHANICAL LINKS CROSSING WITHOUT CONNECTION				MECHANICAL INDICATOR WITH AUTOMATIC RESET				CAPACITOR				JUNCTION OF MECHANICAL LINKS				MECHANICAL INDICATOR WITH NON-AUTOMATIC RESET				SEMICONDUCTOR DIODE USED AS A CAPACITIVE DEVICE				AUTOMATIC RESET				ELECTRICALLY CONTROLLED MECHANICAL INDICATOR WITH AUTOMATIC RESET				OPEN CONTACT, MAKE CONTACT				NON-AUTOMATIC RESET								CLOSED CONTACT, BREAK CONTACT				SWITCHING DEVICE WITH MANUAL OPERATION AND WITH AUTOMATIC RESET				RELAY WITH MAKE CONTACT				CHANGE-OVER CONTACT, BREAK BEFORE MAKE				SWITCHING DEVICE WITH MANUAL OPERATION AND WITH NON-AUTOMATIC RESET				RELAY WITH CHANGE-OVER CONTACT				MAKE CONTACT WHICH IS EARLY WHEN OPERATING AND LATE WHEN RELEASING				CHANGE-OVER SWITCHING DEVICE WITH MANUAL CONTROL AUTOMATIC RESET FROM POSITION 1-2 TO THE NEUTRAL POSITION				ELECTRO-MECHANICAL POSITION INDICATOR WITH ONE DE-ENERGIZED AND ONE OPERATED POSITION				BREAK CONTACT WHICH IS LATE WHEN OPERATING AND EARLY WHEN RELEASING				RELAY WITH MAKE CONTACT, DELAYED WHEN OPERATING				ELECTRO-MECHANICAL POSITION INDICATOR WITH ONE DE-ENERGIZED AND TWO OPERATED POSITION				SWITCHING DEVICE WITH MANUAL CONTROL				RELAY WITH MAKE CONTACT, DELAYED WHEN RELEASING				BELL, BUZZER				MAKE CONTACT DELAYED WHEN OPERATING				RELAY WITH MAKE CONTACT, DELAYED WHEN OPERATING AND RELEASING				SIREN , HORN				BREAK CONTACT DELAYED WHEN RELEASING												MAKE CONTACT DELAYED WHEN OPERATING AND RELEASING												MAIN CONTACT OF A SWITCH DISCONNECTOR												MAIN CONTACT OF A DISCONNECTOR									
SYMBOL		DESCRIPTION		SYMBOL		DESCRIPTION		SYMBOL		DESCRIPTION																																																																																																																																																																																																																																													
		FRAME CONNECTION				MAIN CONTACT OF A CIRCUIT BREAKER				RELAY WITH TWO MAKE CONTACTS, ONE OF THEM DELAYED WHEN OPERATING																																																																																																																																																																																																																																													
		EARTH CONNECTION				PASSING MAKE CONTACT CLOSING MOMENTARILY DURING OPERATION AND RELEASE				RELAY WITH TWO ACTUATORS AND A TWO STABLE POSITIONS																																																																																																																																																																																																																																													
		RESISTOR				BREAK CONTACT DELAYED WHEN OPERATING																																																																																																																																																																																																																																																	
		VARIABLE RESISTOR				MAKE CONTACT DELAYED WHEN RELEASING				SIGNALLING LAMP																																																																																																																																																																																																																																													
		RESISTOR WITH PRESET ADJUSTMENT				TWO MECHANICAL LINKS CROSSING WITHOUT CONNECTION				MECHANICAL INDICATOR WITH AUTOMATIC RESET																																																																																																																																																																																																																																													
		CAPACITOR				JUNCTION OF MECHANICAL LINKS				MECHANICAL INDICATOR WITH NON-AUTOMATIC RESET																																																																																																																																																																																																																																													
		SEMICONDUCTOR DIODE USED AS A CAPACITIVE DEVICE				AUTOMATIC RESET				ELECTRICALLY CONTROLLED MECHANICAL INDICATOR WITH AUTOMATIC RESET																																																																																																																																																																																																																																													
		OPEN CONTACT, MAKE CONTACT				NON-AUTOMATIC RESET																																																																																																																																																																																																																																																	
		CLOSED CONTACT, BREAK CONTACT				SWITCHING DEVICE WITH MANUAL OPERATION AND WITH AUTOMATIC RESET				RELAY WITH MAKE CONTACT																																																																																																																																																																																																																																													
		CHANGE-OVER CONTACT, BREAK BEFORE MAKE				SWITCHING DEVICE WITH MANUAL OPERATION AND WITH NON-AUTOMATIC RESET				RELAY WITH CHANGE-OVER CONTACT																																																																																																																																																																																																																																													
		MAKE CONTACT WHICH IS EARLY WHEN OPERATING AND LATE WHEN RELEASING				CHANGE-OVER SWITCHING DEVICE WITH MANUAL CONTROL AUTOMATIC RESET FROM POSITION 1-2 TO THE NEUTRAL POSITION				ELECTRO-MECHANICAL POSITION INDICATOR WITH ONE DE-ENERGIZED AND ONE OPERATED POSITION																																																																																																																																																																																																																																													
		BREAK CONTACT WHICH IS LATE WHEN OPERATING AND EARLY WHEN RELEASING				RELAY WITH MAKE CONTACT, DELAYED WHEN OPERATING				ELECTRO-MECHANICAL POSITION INDICATOR WITH ONE DE-ENERGIZED AND TWO OPERATED POSITION																																																																																																																																																																																																																																													
		SWITCHING DEVICE WITH MANUAL CONTROL				RELAY WITH MAKE CONTACT, DELAYED WHEN RELEASING				BELL, BUZZER																																																																																																																																																																																																																																													
		MAKE CONTACT DELAYED WHEN OPERATING				RELAY WITH MAKE CONTACT, DELAYED WHEN OPERATING AND RELEASING				SIREN , HORN																																																																																																																																																																																																																																													
		BREAK CONTACT DELAYED WHEN RELEASING																																																																																																																																																																																																																																																					
		MAKE CONTACT DELAYED WHEN OPERATING AND RELEASING																																																																																																																																																																																																																																																					
		MAIN CONTACT OF A SWITCH DISCONNECTOR																																																																																																																																																																																																																																																					
		MAIN CONTACT OF A DISCONNECTOR																																																																																																																																																																																																																																																					
<table><tr><td colspan="3">AS-BUILT BY _____ DATE _____</td><td colspan="3">CONTRACT NO. 11131113/00</td><td colspan="3">JOB ORDER NO. S-13656</td><td colspan="4">GRAPHICAL SYMBOLS FOR DIAGRAMS</td><td colspan="4" rowspan="2"><div>نقل الكهرباء</div><div>National Grid sa</div></td></tr><tr><td colspan="3"></td><td colspan="3"></td><td colspan="3"></td><td colspan="4">132/13.8KV GT-1 RELAY PANEL-1/2</td></tr><tr><td colspan="3">01 13 49 FACTORY ASBUILT</td><td colspan="3">DRAWN BY RIZ CHECKED BY JKR</td><td colspan="3"></td><td colspan="4">S/S 8709-132/13.8KV IN AL-KHARJ CITY</td><td colspan="2">INDEX</td><td colspan="2">PLANT NO.</td><td colspan="2">DRAWING NUMBER</td><td colspan="2">SHEET NO.</td><td colspan="2">REV. NO.</td></tr><tr><td colspan="3">00 13 04 FOR APPROVAL</td><td colspan="3">DATE STARTED 24.01.2013 DATE COMPLETED _____</td><td colspan="3"></td><td colspan="4">RIYADH SAUDI ARABIA</td><td colspan="2">-</td><td colspan="2">C421</td><td colspan="2">CD-322928</td><td colspan="2">SHT 011 CONT. 012</td><td colspan="2">01</td></tr><tr><td colspan="2">REV. NO.</td><td colspan="2">DATE</td><td colspan="2">DESCRIPTION</td><td colspan="2">OPRG. DEPT. CTPD</td><td colspan="2">ENG. DEPT. AUT-PSAC</td><td colspan="3"></td><td colspan="2"></td><td colspan="2"></td><td colspan="2"></td><td colspan="2"></td><td colspan="2"></td></tr></table>																				AS-BUILT BY _____ DATE _____			CONTRACT NO. 11131113/00			JOB ORDER NO. S-13656			GRAPHICAL SYMBOLS FOR DIAGRAMS				<div>نقل الكهرباء</div> <div>National Grid sa</div>													132/13.8KV GT-1 RELAY PANEL-1/2				01 13 49 FACTORY ASBUILT			DRAWN BY RIZ CHECKED BY JKR						S/S 8709-132/13.8KV IN AL-KHARJ CITY				INDEX		PLANT NO.		DRAWING NUMBER		SHEET NO.		REV. NO.		00 13 04 FOR APPROVAL			DATE STARTED 24.01.2013 DATE COMPLETED _____						RIYADH SAUDI ARABIA				-		C421		CD-322928		SHT 011 CONT. 012		01		REV. NO.		DATE		DESCRIPTION		OPRG. DEPT. CTPD		ENG. DEPT. AUT-PSAC																																																																																																																																															
AS-BUILT BY _____ DATE _____			CONTRACT NO. 11131113/00			JOB ORDER NO. S-13656			GRAPHICAL SYMBOLS FOR DIAGRAMS				<div>نقل الكهرباء</div> <div>National Grid sa</div>																																																																																																																																																																																																																																										
									132/13.8KV GT-1 RELAY PANEL-1/2																																																																																																																																																																																																																																														
01 13 49 FACTORY ASBUILT			DRAWN BY RIZ CHECKED BY JKR						S/S 8709-132/13.8KV IN AL-KHARJ CITY				INDEX		PLANT NO.		DRAWING NUMBER		SHEET NO.		REV. NO.																																																																																																																																																																																																																																		
00 13 04 FOR APPROVAL			DATE STARTED 24.01.2013 DATE COMPLETED _____						RIYADH SAUDI ARABIA				-		C421		CD-322928		SHT 011 CONT. 012		01																																																																																																																																																																																																																																		
REV. NO.		DATE		DESCRIPTION		OPRG. DEPT. CTPD		ENG. DEPT. AUT-PSAC																																																																																																																																																																																																																																															

AS-BUILT BY \_\_\_\_\_ DATE \_\_\_\_\_ CONTRACT NO. 11131113/00 JOB ORDER NO. S-13656

01 13 49 FACTORY ASBUILT			DRAWN BY RIZ CHECKED BY JKR	
00 13 04 FOR APPROVAL			DATE STARTED 24.01.2013 DATE COMPLETED _____	
REV. NO.	DATE	DESCRIPTION	OPRG. DEPT. CTPD ENG. DEPT. AUT-PSAC	

GRAPHICAL SYMBOLS FOR DIAGRAMS

132/13.8KV GT-1 RELAY PANEL-1/2

S/S 8709-132/13.8KV IN AL-KHARJ CITY

RIYADH SAUDI ARABIA

الشركة الوطنية لنقل الكهرباء  
National Grid sa

INDEX	PLANT NO.	DRAWING NUMBER	SHEET NO.		REV. NO.
-	C421	CD-322928	SHT	CONT.	01
			011	012	

NG/D2-D (2012/01)

DMS VECTOR NGD200

A

B

C

D

E

F

SYMBOL	DESCRIPTION	SYMBOL	DESCRIPTION	SYMBOL	DESCRIPTION
	FUSE / LINK		WATTMETER		ELEMENT WITH NEGATED INHIBITING INPUT
	FUSE WITH THE SUPPLY SIDE INDICATED		VARMETER		ELEMENT WITH INPUT WHICH DOES NOT CARRY ANY LOGIC INFORMATION
	SINGLE-PHASE TRANSFORMER WITH TWO SEPARATE WINDINGS (TWO ALTERNATIVE FORMS)		POWER FACTOR METER		ELEMENT WITH POSTPONED OUTPUT
	SINGLE-PHASE TRANSFORMER WITH THREE SEPARATE WINDINGS (TWO ALTERNATIVE FORMS)		POSITION INDICATOR		AND-ELEMENT WITH TWO INPUTS
	SINGLE-PHASE TRANSFORMER WITH FERRO MAGNETIC CORE		SYNCHROSCOPE		OR-ELEMENT WITH TWO INPUTS
	SINGLE-PHASE VOLTAGE TRANSFORMER (MULTI-LINE AND SINGLE-LINE REPRESENTATION)		RECORDING VOLTMETER		LOGIC THRESHOLD ELEMENT WITH FOUR INPUTS AND THRESHOLD VALUE 2
	SINGLE-PHASE VOLTAGE TRANSFORMER WITH TWO SECONDARY WINDINGS (MULTI-LINE AND SINGLE-LINE REPRESENTATION)		RECORDING WATTMETER		ELEMENT WITH THREE INPUTS FOR "2 AND ONLY 2"
	CURRENT TRANSFORMER (MULTI-LINE AND SINGLE-LINE REPRESENTATION)		HOUR METER		EXCLUSIVE OR-ELEMENT WITH THREE INPUTS
	CURRENT TRANSFORMER WITH TWO CORES (MULTI-LINE AND SINGLE-LINE REPRESENTATION)		WATT-HOUR METER		LOGIC IDENTITY ELEMENT WITH THREE INPUTS
	CURRENT TRANSFORMER WITH TWO SECONDARY WINDINGS ON ONE CORE (MULTI-LINE AND SINGLE-LINE REPRESENTATION)		WATT-HOUR METER FOR ENERGY FROM A BUSBAR SYSTEM		MAJORITY ELEMENT WITH THREE INPUTS
	FILTER		ELEMENT WITH STATIC INPUT		NEGATOR
	HIGH-PASS FILTER		ELEMENT WITH STATIC NEGATED INPUT		NAND ELEMENT WITH TWO INPUTS
	BAND-PASS FILTER		ELEMENT WITH STATIC NEGATED OUTPUT		NOR ELEMENT WITH TWO INPUTS
	VOLTMETER		ELEMENT WITH DYNAMIC INPUT		BISTABLE ELEMENT
	AMMETER		ELEMENT WITH DYNAMIC NEGATED INPUT		
			ELEMENT WITH INHIBITING INPUT		

AS-BUILT BY \_\_\_\_\_ DATE \_\_\_\_\_

CONTRACT NO. 11131113/00

JOB ORDER NO. S-13656

GRAPHICAL SYMBOLS FOR DIAGRAMS

132/13.8KV GT-1 RELAY PANEL-1/2

S/S 8709-132/13.8KV IN AL-KHARJ CITY

RIYADH

SAUDI ARABIA

الشركة الوطنية لنقل الكهرباء



National Grid sa

INDEX	PLANT NO.	DRAWING NUMBER	SHEET NO.		REV. NO.
			SHT	CONT.	
-	C421	CD-322928	012	013	01

NG/D2-D (2012/01)

DMS

VECTOR

NGD200



	1	2	3	4	5	6	7	8	9	10																																																																														
A																																																																																								
B																																																																																								
C																																																																																								
D																																																																																								
E																																																																																								
F																																																																																								
G	<table><tr><td colspan="5">AS-BUILT BY _____ DATE _____</td><td colspan="2">CONTRACT NO. 11131113/00</td><td colspan="2">JOB ORDER NO. S-13656</td><td colspan="2">COMMON LEGEND</td></tr><tr><td colspan="3">01</td><td colspan="2">13 49</td><td colspan="3">FACTORY ASBUILT</td><td colspan="2">DRAWN BY RIZ</td><td colspan="2">CHECKED BY JKR</td></tr><tr><td colspan="3">00</td><td colspan="2">13 04</td><td colspan="3">FOR APPROVAL</td><td colspan="2">DATE STARTED 24.01.2013</td><td colspan="2">DATE COMPLETED _____</td></tr><tr><td colspan="3">REV. NO.</td><td colspan="2">DATE</td><td colspan="3">DESCRIPTION</td><td colspan="2">OPRG. DEPT. CTPD</td><td colspan="2">ENG. DEPT. AUT-PSAC</td></tr></table> <table><tr><td colspan="2">132/13.8KV GT-1 RELAY PANEL-1/2</td><td colspan="2">S/S 8709-132/13.8KV IN AL-KHARJ CITY</td><td colspan="2">RIYADH</td><td colspan="2">SAUDI ARABIA</td></tr></table> <table><tr><td>INDEX</td><td>PLANT NO.</td><td>DRAWING NUMBER</td><td>SHEET NO.</td><td>REV. NO.</td></tr><tr><td>-</td><td>C421</td><td>CD-322928</td><td>SHT 013</td><td>CONT. 014</td></tr><tr><td colspan="3"></td><td colspan="2">01</td></tr></table> <table><tr><td colspan="2">الشركة الوطنية لنقل الكهرباء</td><td colspan="2">National Grid sa</td></tr><tr><td colspan="2">NG/D2-D (2012/01)</td><td colspan="2">NGD200</td></tr></table>										AS-BUILT BY _____ DATE _____					CONTRACT NO. 11131113/00		JOB ORDER NO. S-13656		COMMON LEGEND		01			13 49		FACTORY ASBUILT			DRAWN BY RIZ		CHECKED BY JKR		00			13 04		FOR APPROVAL			DATE STARTED 24.01.2013		DATE COMPLETED _____		REV. NO.			DATE		DESCRIPTION			OPRG. DEPT. CTPD		ENG. DEPT. AUT-PSAC		132/13.8KV GT-1 RELAY PANEL-1/2		S/S 8709-132/13.8KV IN AL-KHARJ CITY		RIYADH		SAUDI ARABIA		INDEX	PLANT NO.	DRAWING NUMBER	SHEET NO.	REV. NO.	-	C421	CD-322928	SHT 013	CONT. 014				01		الشركة الوطنية لنقل الكهرباء		National Grid sa		NG/D2-D (2012/01)		NGD200	
AS-BUILT BY _____ DATE _____					CONTRACT NO. 11131113/00		JOB ORDER NO. S-13656		COMMON LEGEND																																																																															
01			13 49		FACTORY ASBUILT			DRAWN BY RIZ		CHECKED BY JKR																																																																														
00			13 04		FOR APPROVAL			DATE STARTED 24.01.2013		DATE COMPLETED _____																																																																														
REV. NO.			DATE		DESCRIPTION			OPRG. DEPT. CTPD		ENG. DEPT. AUT-PSAC																																																																														
132/13.8KV GT-1 RELAY PANEL-1/2		S/S 8709-132/13.8KV IN AL-KHARJ CITY		RIYADH		SAUDI ARABIA																																																																																		
INDEX	PLANT NO.	DRAWING NUMBER	SHEET NO.	REV. NO.																																																																																				
-	C421	CD-322928	SHT 013	CONT. 014																																																																																				
			01																																																																																					
الشركة الوطنية لنقل الكهرباء		National Grid sa																																																																																						
NG/D2-D (2012/01)		NGD200																																																																																						

LEGENDS

±R1	DC SUPPLY – MAIN PROTECTION
±R2	DC SUPPLY – SECONDARY PROTECTION
±R3	DC SUPPLY – BACK UP PROTECTION
±IT	DC SUPPLY – INTER TRIP
FL	DC SUPPLY – FLASHING CIRCUIT
BB RS±	DC SUPPLY – BUS BAR – PROTECTION RESET
BB CBF± /CBF±	DC SUPPLY – CBF PROTECTION
R	RESET BUS – ALARM SYSTEM
CR	CONTROL ROOM
ECC	ENERGY CONTROL CENTRE
LOCAL	THE LOCATION OF CONTROLLED DEVICE
REMOTE	ANY OTHER LOCATION NOT LOCAL
ON	CB NORMALLY OPEN AUXILIARY CONTACT
OFF	CB NORMALLY CLOSED AUXILIARY CONTACT
A	COMMON
T	TEST POSITION
S	SERVICE POSITION
CS	CLOSE IN SERVICE POSITION
CT	CLOSE IN TEST POSITION
LS	LOCAL SERVICE
LT	LOCAL TEST
LC	LOCAL CLOSE
LO	LOCAL OPEN
RO	REMOTE OPEN
OP	OPERATE
RE	RESET

NOTES

LABELS

WHITE LABEL WITH BLACK LETTERING WILL BE PROVIDED FOR ALL MOUNTED APPARATUS EQUIPMENT IDENTIFICATION AND FUNCTION REFERENCE LABEL WILL BE PROVIDED FOR FRONT MOUNTED EQUIPMENTS OF THE PANEL AND EQUIPMENT IDENTIFICATION LABEL WILL BE PROVIDED FOR INTERNALLY MOUNTED EQUIPMENTS

WIRING

PVC INSULATED 600V GRADE  
2.5 SQ.mm. YELLOW COLOURED FOR CT CIRCUITS  
2.5 SQ.mm. RE COLOURED FOR VT CIRCUITS  
1.5 SQ.mm. GREY COLOURED FOR DC SUPPLY, SCADA AND CONTROL CIRCUITS  
2.5 SQ.mm. BLACK COLOURED FOR AVC AND AC CIRCUITS  
2.5 SQ.mm. YELLOW/GREEN COLOURED FOR EARTHING CONNECTIONS  
FOLLOWING MARKERS SHALL BE PROVIDED ON FOLLOWING WIRES:  
+ SIGN FOR DC + WIRE  
– SIGN FOR DC – WIRE

LUGS

A. CT CIRCUITS– RING TYPE  
B. OTHER CIRCUITS – SPADE TYPE

FERULLING

YELLO TUBE 3.2 mm FOR 1.5SQ mm WIRES AND 4.2 FOR 2.5 SQ mm WIRES ( AS PER 31 – TMSS–1, RE.0 )

A

B


C

D

E

F

G

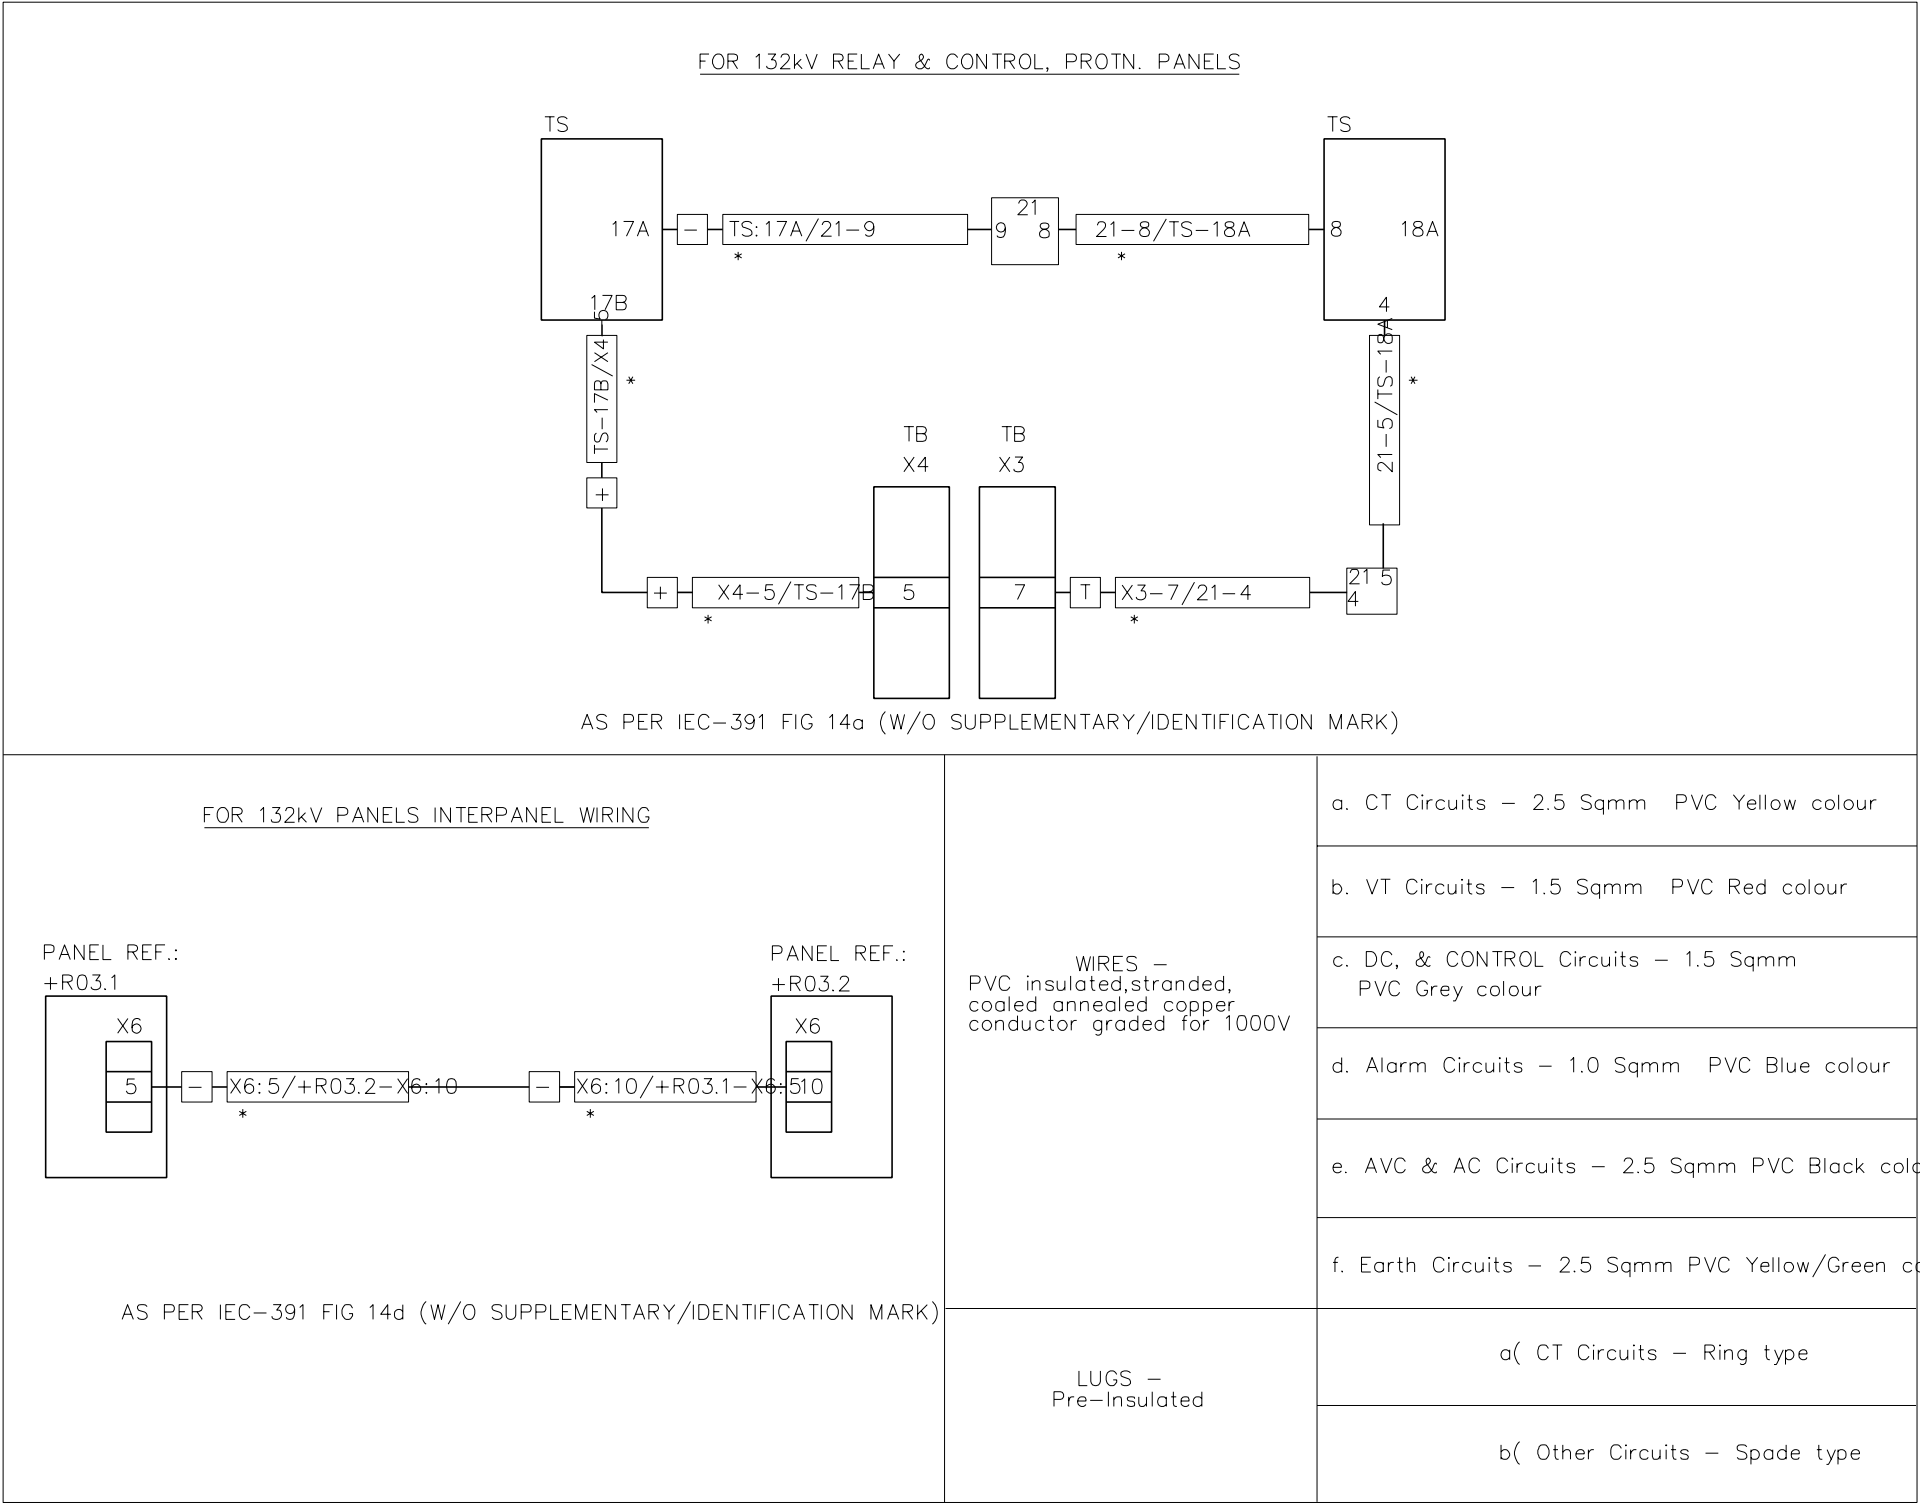

NOTE:1 ADDITIONAL MARKING AS APPLICABLE

NOTE:2 FERRULE NUMBERING WILL BE BLACK LETTERS ON YELLOW TUBE

3.2 mm for 1.5 sq mm wires and

4.2 mm for 2.5 sq mm wires

( As per 31-TMSS-1, REV 0 )

NOTE:3 STARTING POINT OF THE FERRULE LEFT TO RIGHT

AS-BUILT BY _____ DATE _____			CONTRACT NO. 11131113/00	JOB ORDER NO. S-13656
01	13 49	FACTORY ASBUILT	DRAWN BY RIZ CHECKED BY JKR	
00	13 04	FOR APPROVAL	DATE STARTED 24.01.2013 DATE COMPLETED _____	
REV. NO.	DATE	DESCRIPTION	OPRG. DEPT. CTPD ENG. DEPT. AUT-PSAC	

FERRULE AND WIRING DETAILS	
132/13.8KV GT-1 RELAY PANEL-1/2	
S/S 8709-132/13.8KV IN AL-KHARJ CITY	
RIYADH SAUDI ARABIA	

الشركة الوطنية لنقل الكهرباء			 <b>نقل الكهرباء</b> National Grid SA		
INDEX	PLANT NO.	DRAWING NUMBER	SHEET NO.		REV. NO.
-	C421	CD-322928	SHT 014	CONT. 015	01

1		2		3		4		5		6		7		8		9		10											
A		<div><div><div>ABB</div><div>PROTECTION &amp; SUBSTATION AUTOMATION</div></div></div>																		MANUFACTURER		SCHEMATICS DWG.NO		PANEL DESCRIPTION				PANEL REFERENCE	
B																								SS 8709 132kV RELAY PANELS					
B																				CD-322928				132/13.8kV GT-1 RELAY PANEL -1				+R05.1	
																								132/13.8kV GT-1 RELAY PANEL -2				+R05.2	
B																				CD-322931				132/13.8kV GT-2 RELAY PANEL -1				+R01.1	
																								132/13.8kV GT-2 RELAY PANEL -2				+R01.2	
B																				CD-322934				132/13.8kV GT-3 RELAY PANEL -1				+R04.1	
																								132/13.8kV GT-3 RELAY PANEL -2				+R04.2	
B																				CD-322936				132/13.8kV TRANSFORMER-1,2& 3 AVC PANEL				+AVC	
C																				CD-322922				132KV SPARE-1 UGF RELAY PANEL -1				+R07.1	
																								132KV SPARE-1 UGF RELAY PANEL -2				+R07.2	
C																				CD-322916				132KV 8020 UGF RELAY PANEL -1				+R02.1	
																								132KV 8020 UGF RELAY PANEL -2				+R02.2	
C																				CD-322919				132KV 8710 UGF RELAY PANEL -1				+R05.1	
																								132KV 8710 UGF RELAY PANEL -2				+R05.2	
C																				CD-322925				132KV SPARE-2 UGF RELAY PANEL -1				+R06.1	
																								132KV SPARE-2 UGF RELAY PANEL -2				+R06.2	
D																				CD-323012				132KV FOIP PANEL				+FOIP	
D																				CD-322946				132kV BUS COUPLER-A				+R130	
D																				CD-322948				132kV BUS COUPLER-B				+R230	
D		CD-322950				132kV BUS SECTION				+R120																			
E		CD-322991				132kV BUSBAR PROTECTION MAIN-1 CENTRAL UNIT PANEL				+BB1-1																			
E		CD-322993				132kV BUSBAR PROTECTION MAIN-1 BAY UNIT PANEL				+BB1-2																			
E		CD-322995				132kV BUSBAR PROTECTION MAIN-1 BAY UNIT PANEL				+BB1-3																			
E		CD-322997				132kV BUSBAR PROTECTION MAIN-1 BAY UNIT PANEL				+BB1-4																			
F		CD-322999				132kV BUSBAR PROTECTION MAIN-1 BAY UNIT PANEL				+BB1-5																			
F		CD-323001				132kV BUSBAR PROTECTION MAIN-2 CENTRAL UNIT PANEL				+BB2-1																			
F		CD-323003				132kV BUSBAR PROTECTION MAIN-2 BAY UNIT PANEL				+BB2-2																			
F		CD-323005				132kV BUSBAR PROTECTION MAIN-2 BAY UNIT PANEL				+BB2-3																			
F		CD-323007				132kV BUSBAR PROTECTION MAIN-2 BAY UNIT PANEL				+BB2-4																			
F		CD-323009				132kV BUSBAR PROTECTION MAIN-2 BAY UNIT PANEL				+BB2-5																			
G		AS-BUILT BY _____ DATE _____				CONTRACT NO. 11131113/00				JOB ORDER NO. S-13656				DRAWING REFERENCES				<div><div><div>الشركة الوطنية لنقل الكهرباء</div><div>نقل الكهرباء</div><div>National Grid SA</div></div></div>											
						DRAWN BY RIZ CHECKED BY JKR				132/13.8KV GT-1 RELAY PANEL-1/2																			
		01 13 49 FACTORY ASBUILT				DATE STARTED 24.01.2013 DATE COMPLETED _____				S/S 8709-132/13.8KV IN AL-KHARJ CITY																			
		00 13 04 FOR APPROVAL				OPRG. DEPT. CTPD ENG. DEPT. AUT-PSAC				RIYADH SAUDI ARABIA																			
		REV. NO.		DATE		DESCRIPTION								INDEX		PLANT NO.		DRAWING NUMBER		SHEET NO.		REV. NO.							
														-		C421		CD-322928		SHT		CONT.							
																				015		016							
																						01							

THIS DRAWING AND THE INFORMATION CONTAINED HEREIN ARE THE SOLE PROPERTY OF National Grid SA NO REPRODUCTION IN FULL OR IN PART SHALL BE OBTAINED FROM THIS DOCUMENT WITHOUT THE WRITTEN CONSENT OF ITS OWNER.


	1	2	3	4	5	6	7	8	9	10																																																																						
A																																																																																
B																																																																																
C																																																																																
D																																																																																
E																																																																																
F																																																																																
G	<table><tr><td colspan="3">AS-BUILT BY _____ DATE _____</td><td colspan="2">CONTRACT NO. 11131113/00</td><td colspan="2">JOB ORDER NO. S-13656</td><td colspan="3">DRAWING REFERENCES</td><td colspan="2"><div>الشركة الوطنية لنقل الكهرباء</div><div>نقل الكهرباء</div><div>National Grid sa</div></td></tr><tr><td></td><td></td><td></td><td colspan="2">DRAWN BY <u>RIZ</u> CHECKED BY <u>JKR</u></td><td colspan="3">132/13.8KV GT-1 RELAY PANEL-1/2</td><td colspan="2">INDEX</td><td>PLANT NO.</td><td>DRAWING NUMBER</td><td>SHEET NO.</td><td>REV. NO.</td></tr><tr><td></td><td>01</td><td>13 49</td><td colspan="2">FACTORY ASBUILT</td><td colspan="3">DATE STARTED <u>24.01.2013</u> DATE COMPLETED _____</td><td colspan="2">S/S 8709-132/13.8KV IN AL-KHARJ CITY</td><td></td><td></td><td>SHT</td><td>CONT.</td></tr><tr><td></td><td>00</td><td>13 04</td><td colspan="2">FOR APPROVAL</td><td colspan="3">OPRG. DEPT. <u>CTPD</u> ENG. DEPT. <u>AUT-PSAC</u></td><td colspan="2">RIYADH SAUDI ARABIA</td><td>-</td><td>C421</td><td>CD-322928</td><td>016</td><td>051</td></tr><tr><td></td><td>REV. NO.</td><td>DATE</td><td colspan="2">DESCRIPTION</td><td colspan="3"></td><td colspan="2"></td><td></td><td></td><td></td><td></td><td></td></tr></table>										AS-BUILT BY _____ DATE _____			CONTRACT NO. 11131113/00		JOB ORDER NO. S-13656		DRAWING REFERENCES			<div>الشركة الوطنية لنقل الكهرباء</div> <div>نقل الكهرباء</div> <div>National Grid sa</div>					DRAWN BY <u>RIZ</u> CHECKED BY <u>JKR</u>		132/13.8KV GT-1 RELAY PANEL-1/2			INDEX		PLANT NO.	DRAWING NUMBER	SHEET NO.	REV. NO.		01	13 49	FACTORY ASBUILT		DATE STARTED <u>24.01.2013</u> DATE COMPLETED _____			S/S 8709-132/13.8KV IN AL-KHARJ CITY				SHT	CONT.		00	13 04	FOR APPROVAL		OPRG. DEPT. <u>CTPD</u> ENG. DEPT. <u>AUT-PSAC</u>			RIYADH SAUDI ARABIA		-	C421	CD-322928	016	051		REV. NO.	DATE	DESCRIPTION											
AS-BUILT BY _____ DATE _____			CONTRACT NO. 11131113/00		JOB ORDER NO. S-13656		DRAWING REFERENCES			<div>الشركة الوطنية لنقل الكهرباء</div> <div>نقل الكهرباء</div> <div>National Grid sa</div>																																																																						
			DRAWN BY <u>RIZ</u> CHECKED BY <u>JKR</u>		132/13.8KV GT-1 RELAY PANEL-1/2			INDEX		PLANT NO.	DRAWING NUMBER	SHEET NO.	REV. NO.																																																																			
	01	13 49	FACTORY ASBUILT		DATE STARTED <u>24.01.2013</u> DATE COMPLETED _____			S/S 8709-132/13.8KV IN AL-KHARJ CITY				SHT	CONT.																																																																			
	00	13 04	FOR APPROVAL		OPRG. DEPT. <u>CTPD</u> ENG. DEPT. <u>AUT-PSAC</u>			RIYADH SAUDI ARABIA		-	C421	CD-322928	016	051																																																																		
	REV. NO.	DATE	DESCRIPTION																																																																													



PROTECTION & SUBSTATION  
AUTOMATION

THIS DRAWING AND THE INFORMATION CONTAINED HEREIN ARE THE SOLE PROPERTY OF National Grid SA NO REPRODUCTION IN FULL OR IN PART SHALL BE OBTAINED FROM THIS DOCUMENT WITHOUT THE WRITTEN CONSENT OF ITS OWNER.



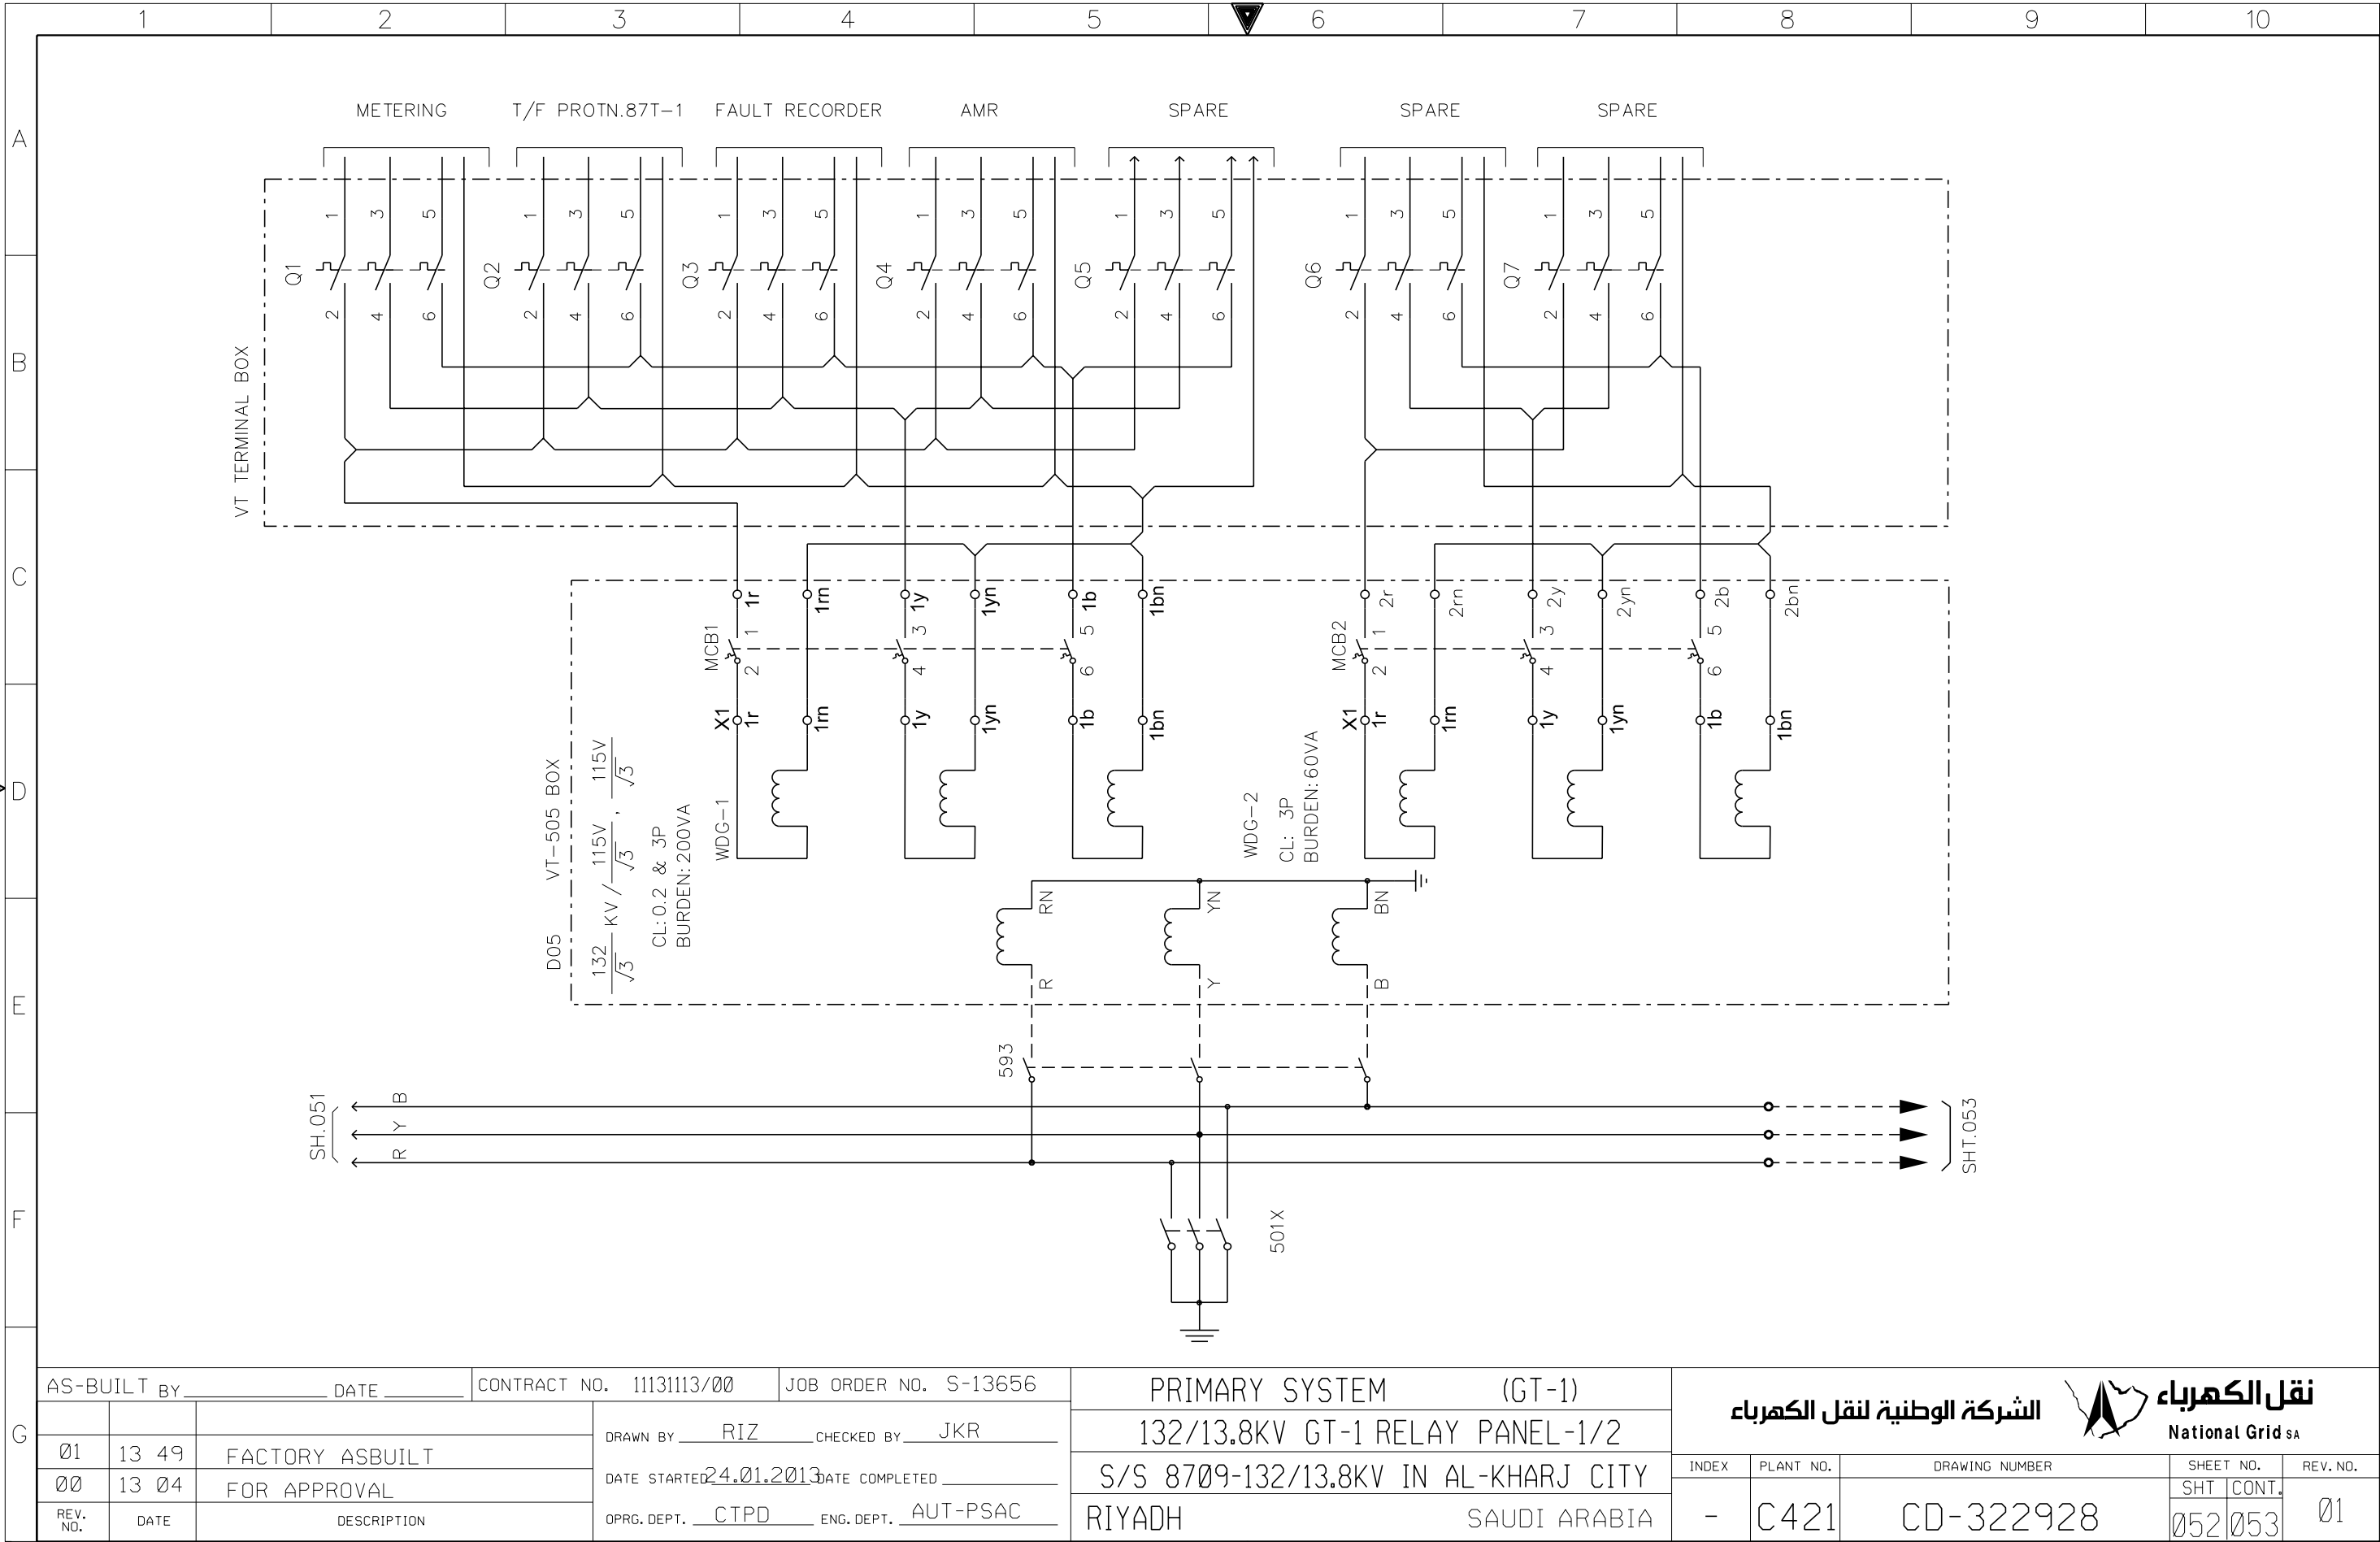

AS-BUILT BY _____ DATE _____			CONTRACT NO. 11131113/00	JOB ORDER NO. S-13656
01	13 49	FACTORY ASBUILT	DRAWN BY RIZ	CHECKED BY JKR
00	13 04	FOR APPROVAL	DATE STARTED 24.01.2013	DATE COMPLETED _____
REV. NO.	DATE	DESCRIPTION	OPRG. DEPT. CTPD	ENG. DEPT. AUT-PSAC

PRIMARY SYSTEM (GT-1)
132/13.8KV GT-1 RELAY PANEL-1/2
S/S 8709-132/13.8KV IN AL-KHARJ CITY
RIYADH SAUDI ARABIA


الشركة الوطنية لنقل الكهرباء National Grid sa				
INDEX	PLANT NO.	DRAWING NUMBER	SHEET NO.	REV. NO.
-	C421	CD-322928	SHT 052	CONT. 053
			01	






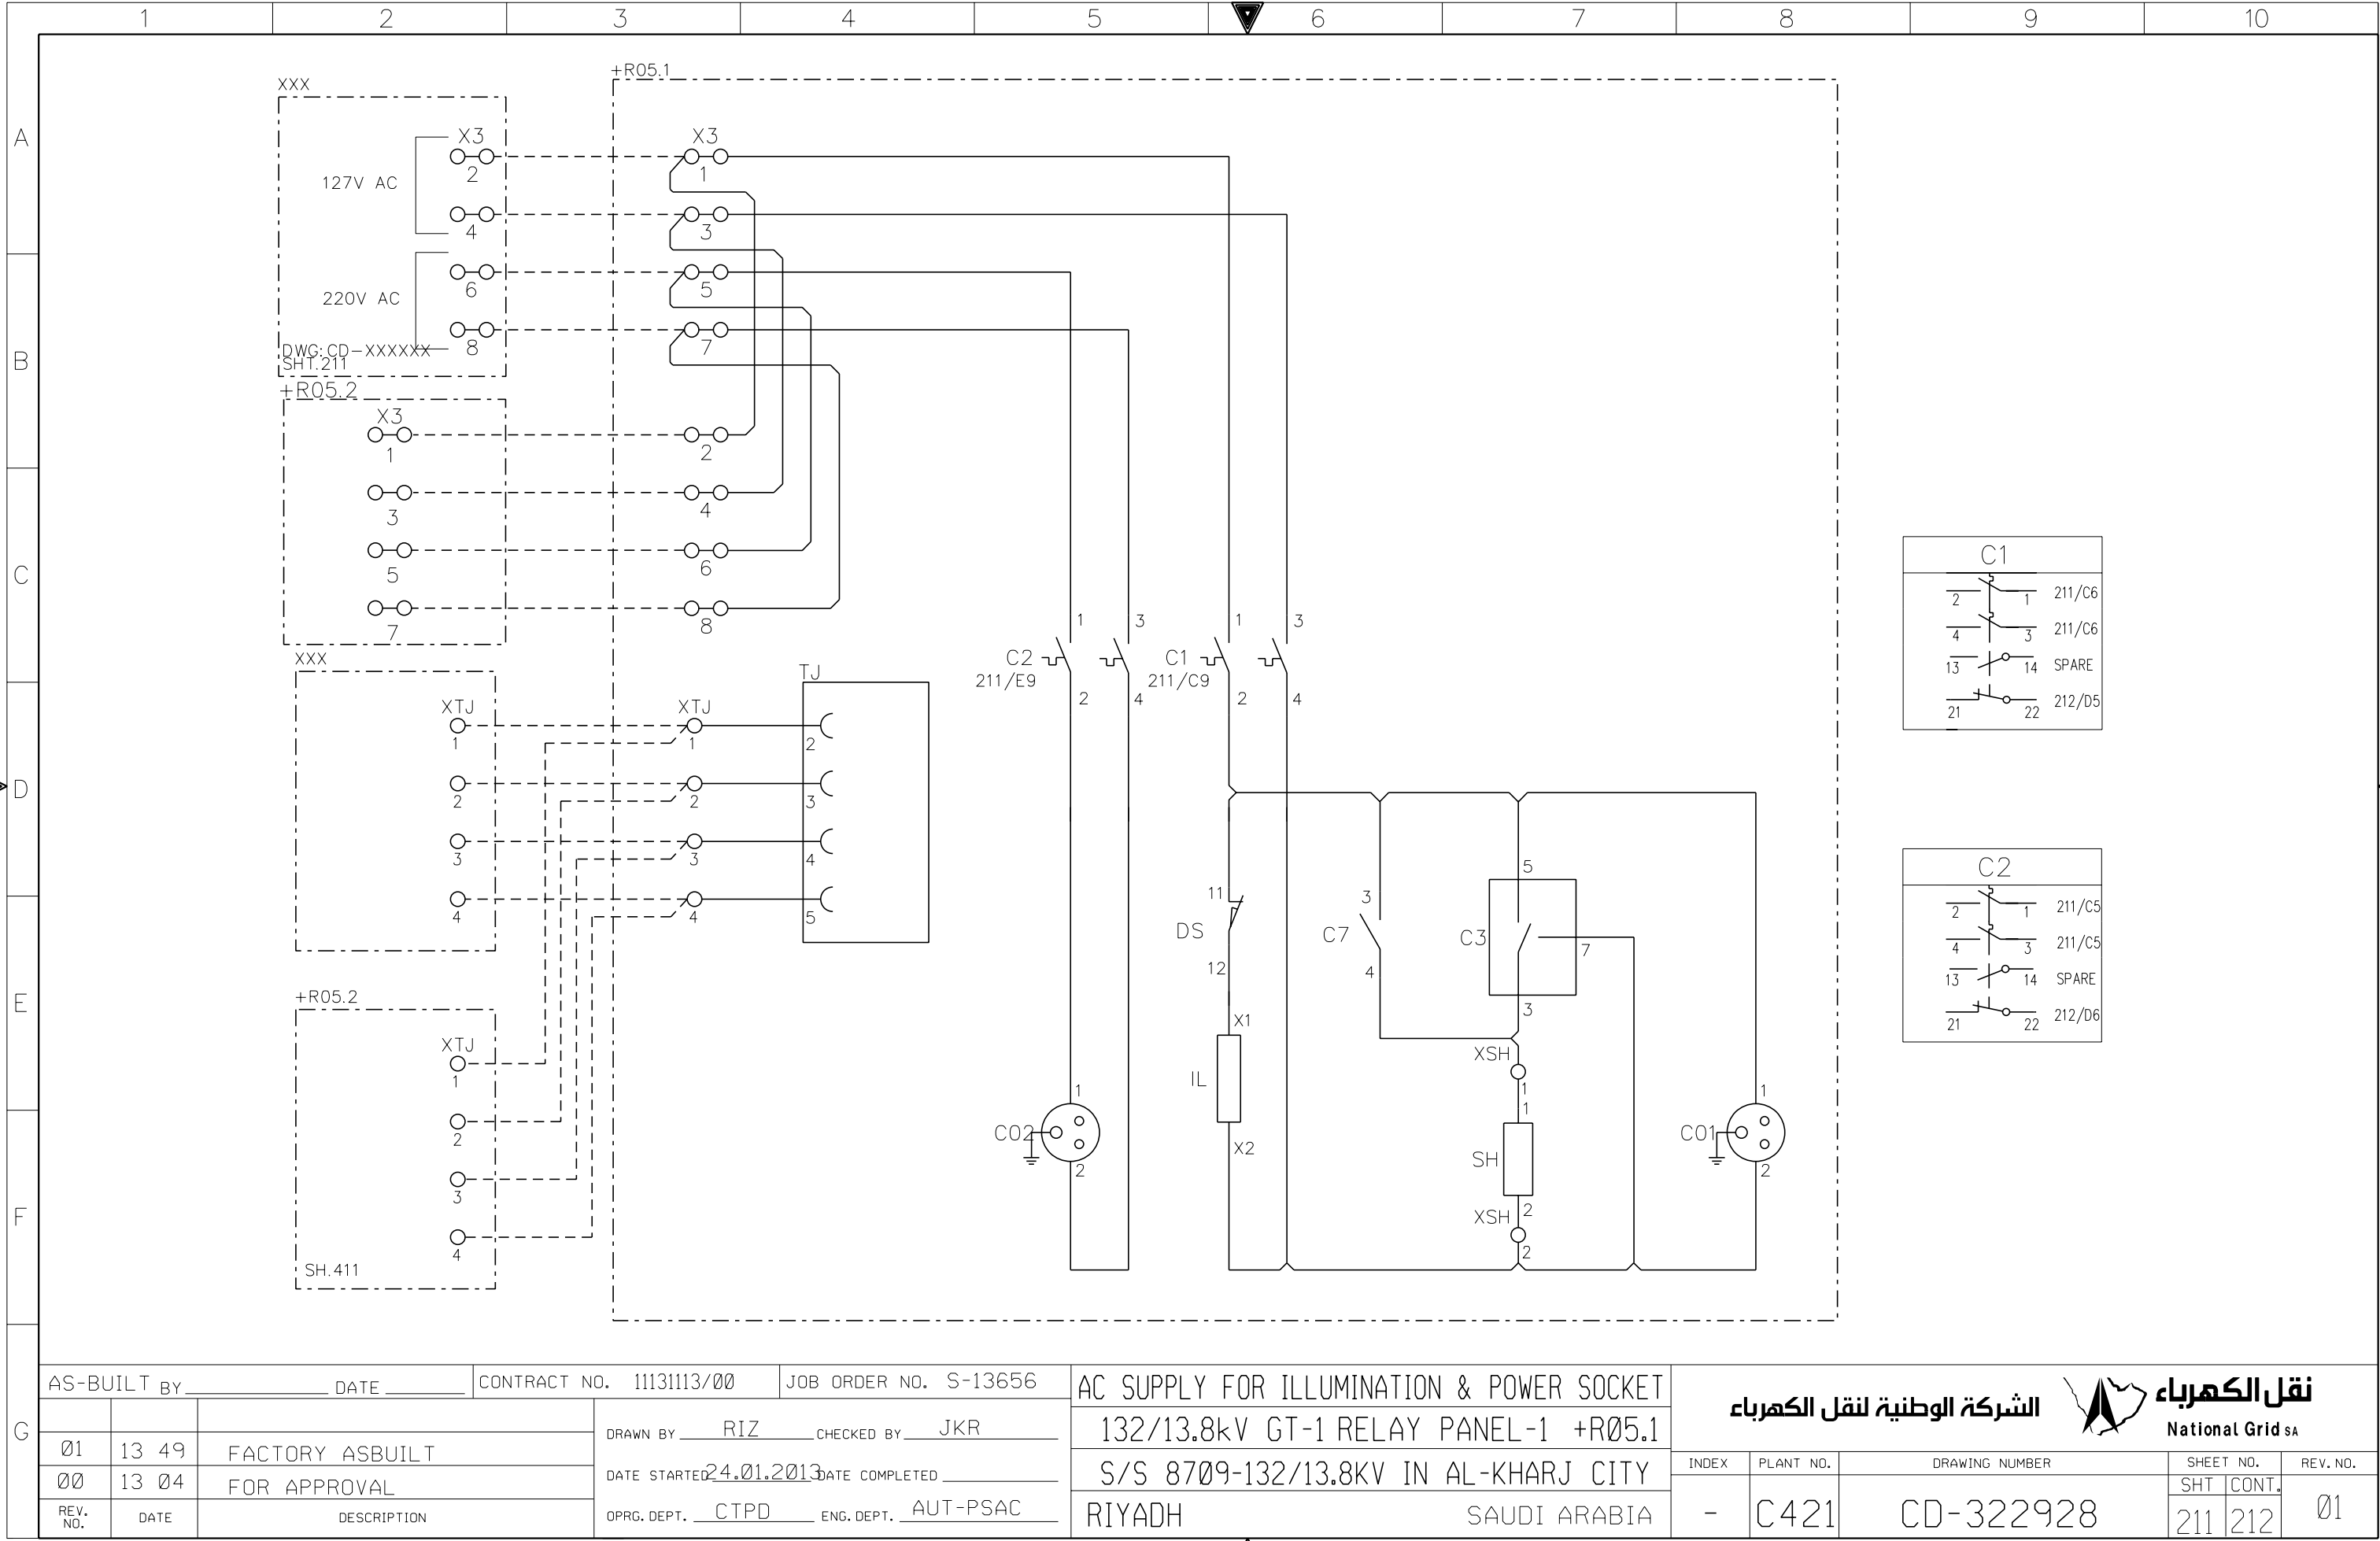




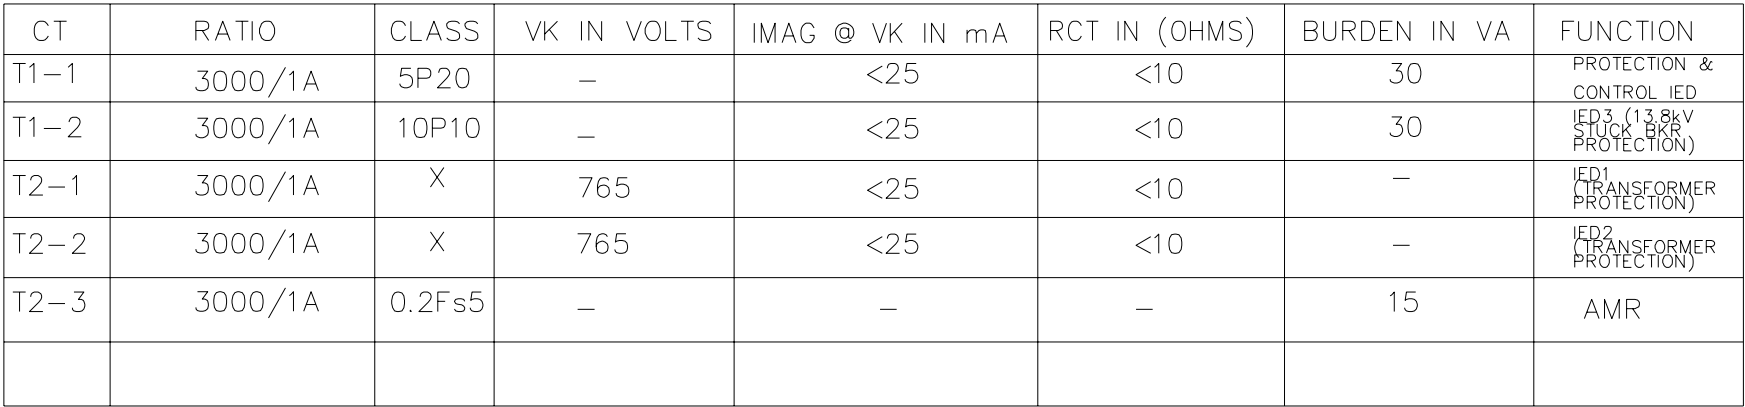


CT	RATIO	CLASS	VK IN VOLTS	IMAG @ VK IN mA	RCT IN (OHMS)	BURDEN IN VA	FUNCTION
T1-1	3000/1A	5P20	—	<25	<10	30	PROTECTION & CONTROL IED
T1-2	3000/1A	10P10	—	<25	<10	30	IED3 (13.8kV STUCK BKR PROTECTION)
T2-1	3000/1A	X	765	<25	<10	—	IED1 (TRANSFORMER PROTECTION)
T2-2	3000/1A	X	765	<25	<10	—	IED2 (TRANSFORMER PROTECTION)
T2-3	3000/1A	0.2Fs5	—	—	—	15	AMR

AS-BUILT BY _____ DATE _____			CONTRACT NO. 11131113/00		JOB ORDER NO. S-13656		<div> <div>  <div> <div>نقل الكهرباء</div> <div>National Grid sa</div> </div> </div> <div> <div>الشركة الوطنية لنقل الكهرباء</div> </div> </div>					
			DRAWN BY _____ RIZ _____ CHECKED BY _____ JKR		PRIMARY SYSTEM (GT-1)							
Ø1 13 49 FACTORY ASBUILT					132/13.8KV GT-1 RELAY PANEL-1/2							
ØØ 13 Ø4 FOR APPROVAL			DATE STARTED 24.01.2013 DATE COMPLETED _____		S/S 8709-132/13.8KV IN AL-KHARJ CITY							
REV. NO. _____ DATE _____ DESCRIPTION _____			OPRG. DEPT. _____ CTPD _____ ENG. DEPT. _____ AUT-PSAC		RIYADH SAUDI ARABIA							
							INDEX	PLANT NO.	DRAWING NUMBER	SHEET NO.		REV. NO.
								C421	CD-322928	SHT 056	CONT. 211	Ø1





THIS DRAWING AND THE INFORMATION CONTAINED HEREIN ARE THE SOLE PROPERTY OF National Grid SA NO REPRODUCTION IN FULL OR IN PART SHALL BE OBTAINED FROM THIS DOCUMENT WITHOUT THE WRITTEN CONSENT OF ITS OWNER.

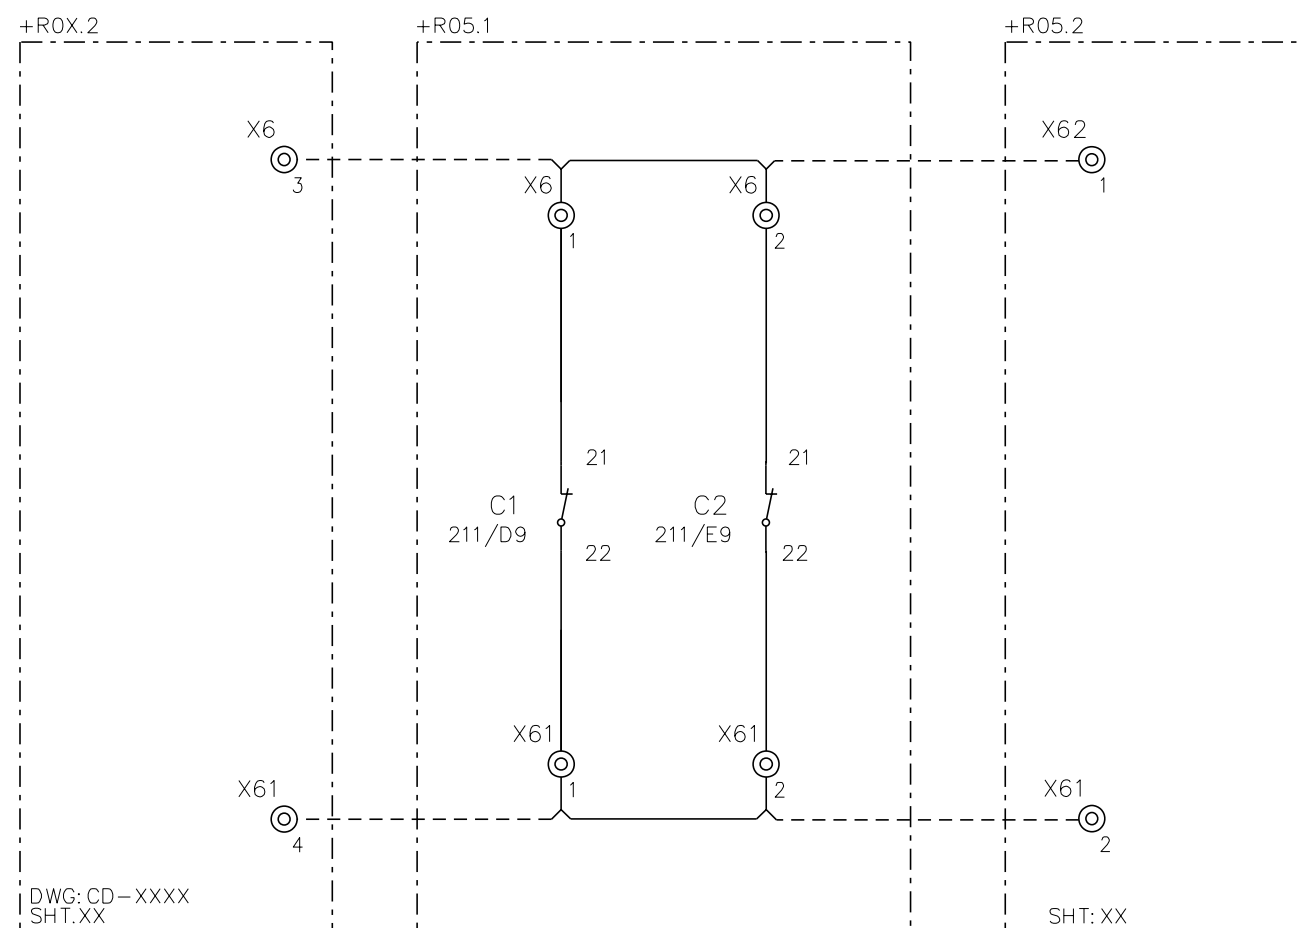


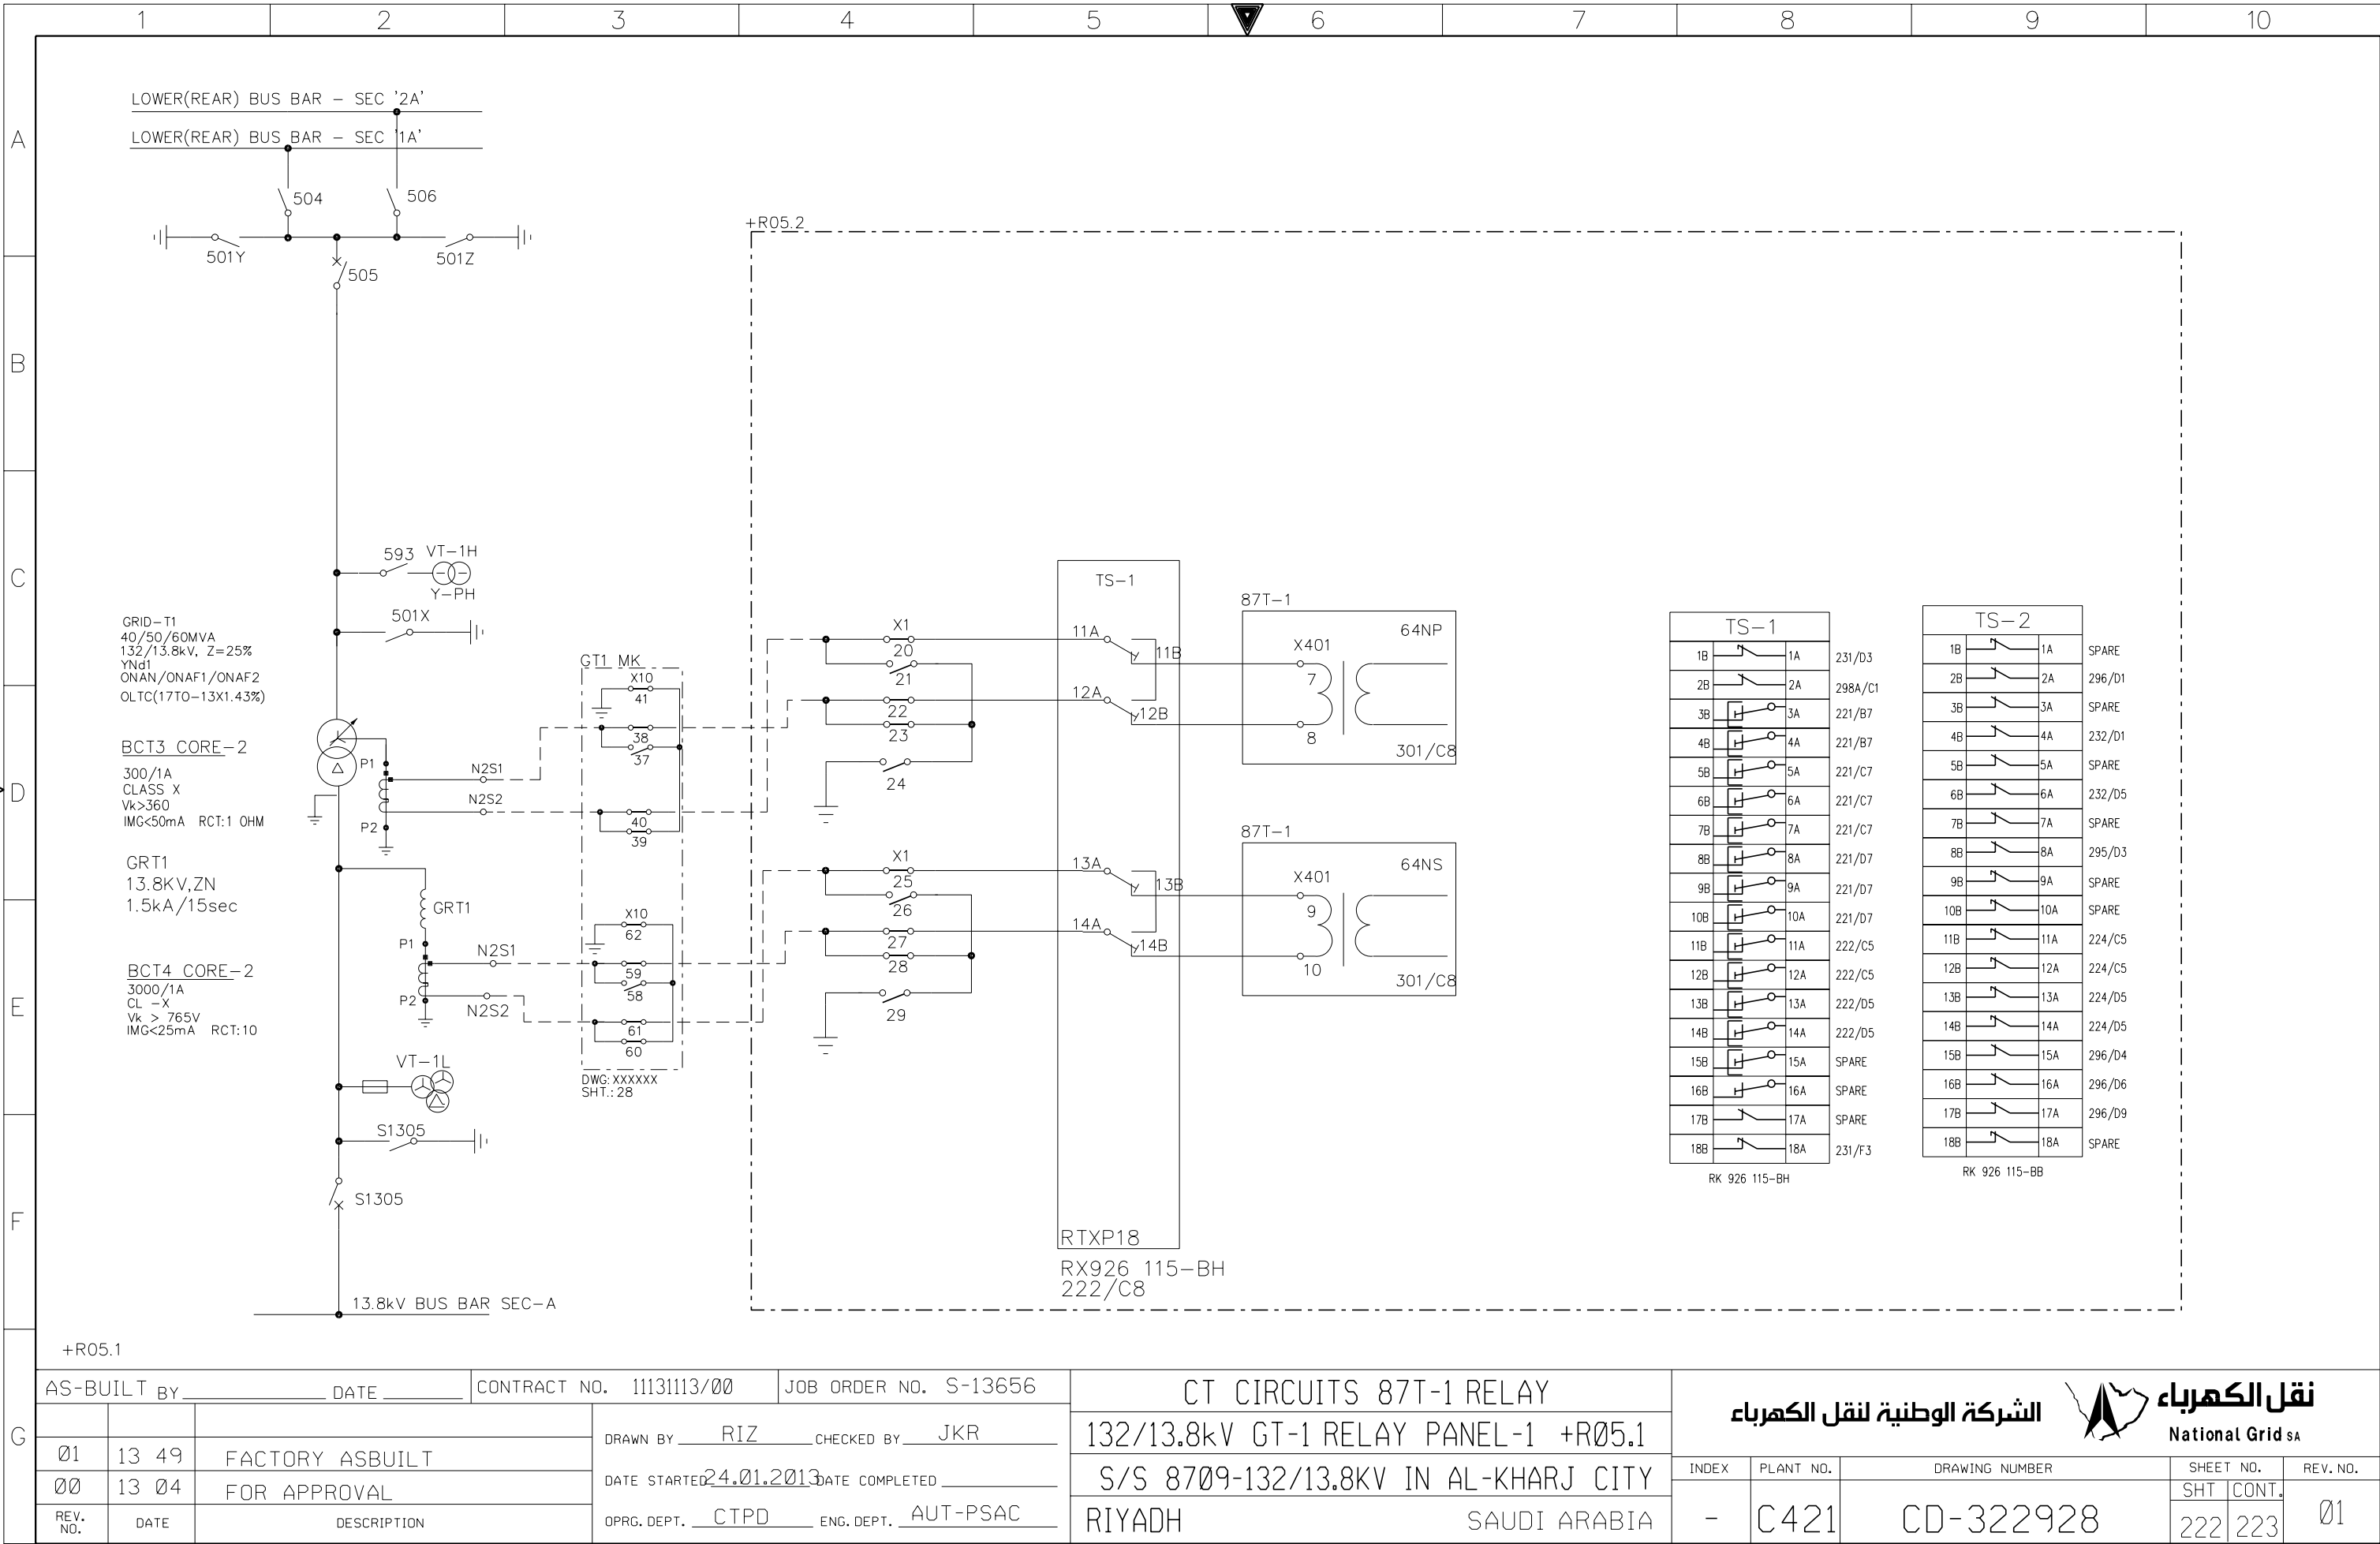
AS-BUILT BY _____ DATE _____		CONTRACT NO. 11131113/00		JOB ORDER NO. S-13656		CUB.LIGHTING,HEATER&SOKET ALARM CKT.	
01	13 49	FACTORY ASBUILT		DRAWN BY <u>RIZ</u> CHECKED BY <u>JKR</u>		132/13.8kV GT-1 RELAY PANEL-1 +R05.1	
00	13 04	FOR APPROVAL		DATE STARTED <u>24.01.2013</u> DATE COMPLETED _____		S/S 8709-132/13.8KV IN AL-KHARJ CITY	
REV. NO.	DATE	DESCRIPTION		OPRG. DEPT. <u>CTPD</u> ENG. DEPT. <u>AUT-PSAC</u>		RIYADH SAUDI ARABIA	

		<b>نقل الكهرباء</b> National Grid SA		<b>الشركة الوطنية لنقل الكهرباء</b>		
INDEX	PLANT NO.	DRAWING NUMBER		SHEET NO.		REV. NO.
-	C421	CD-322928		SHT	CONT.	01
				212	216	

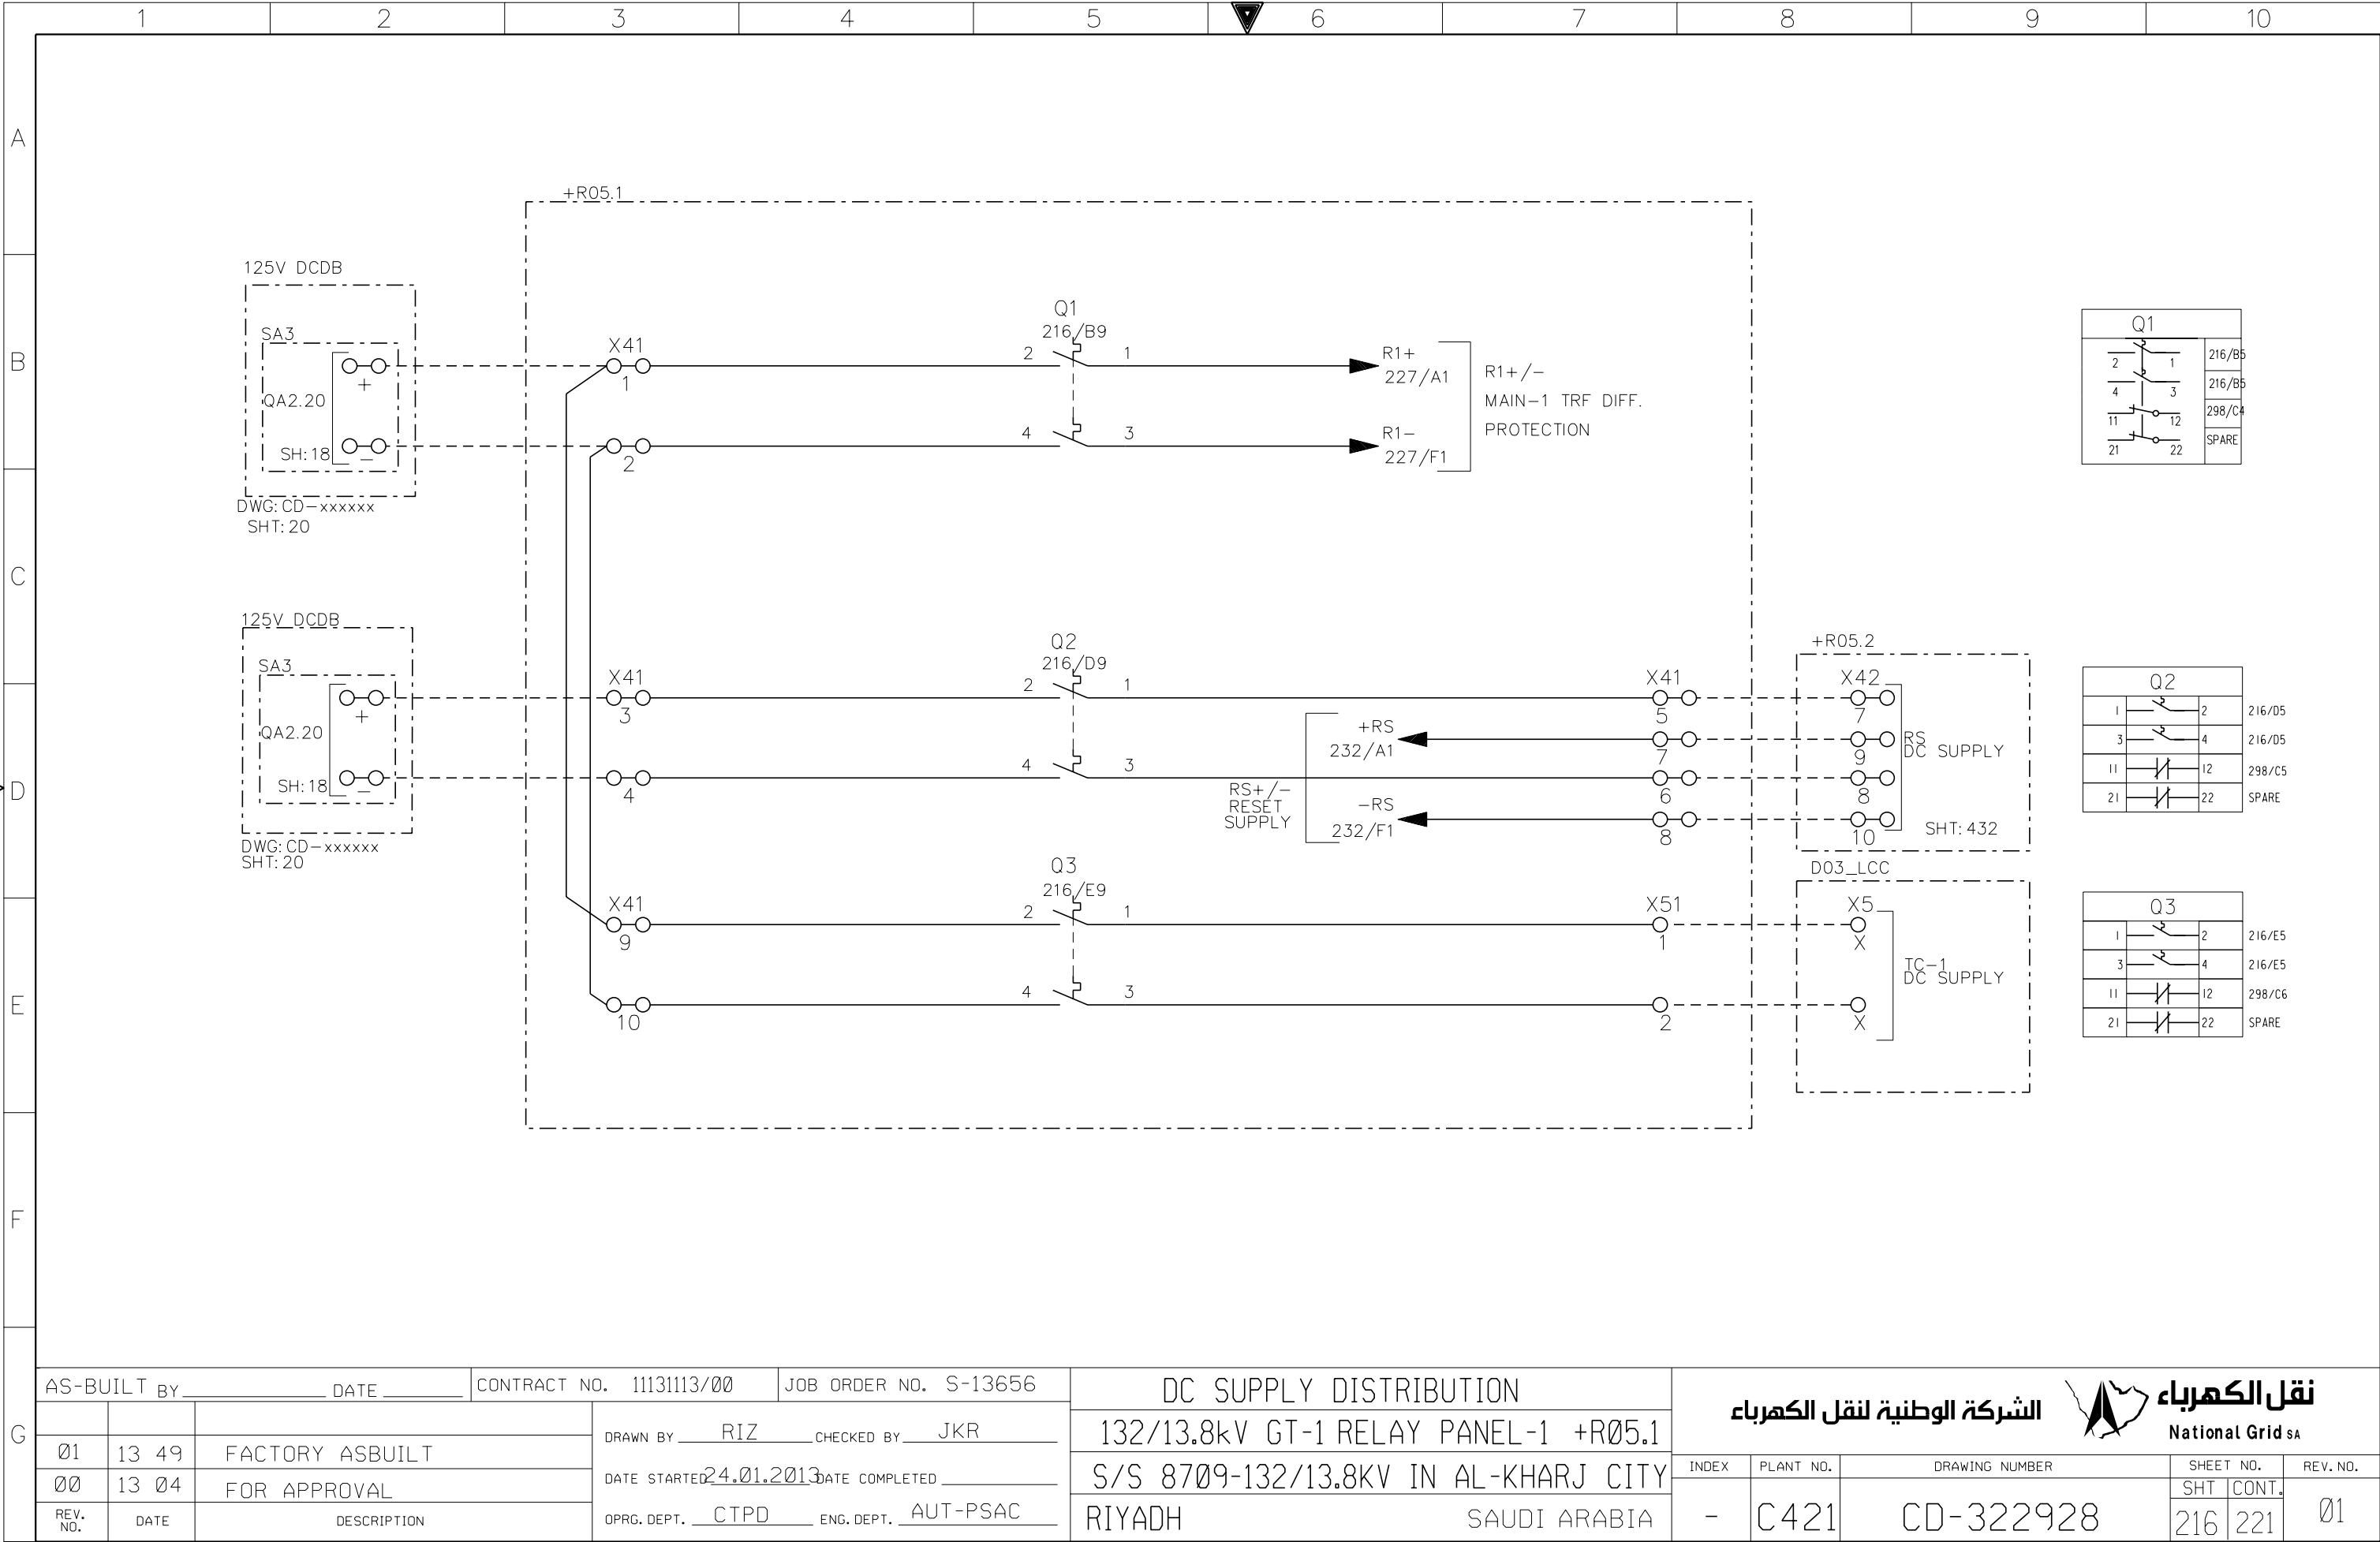


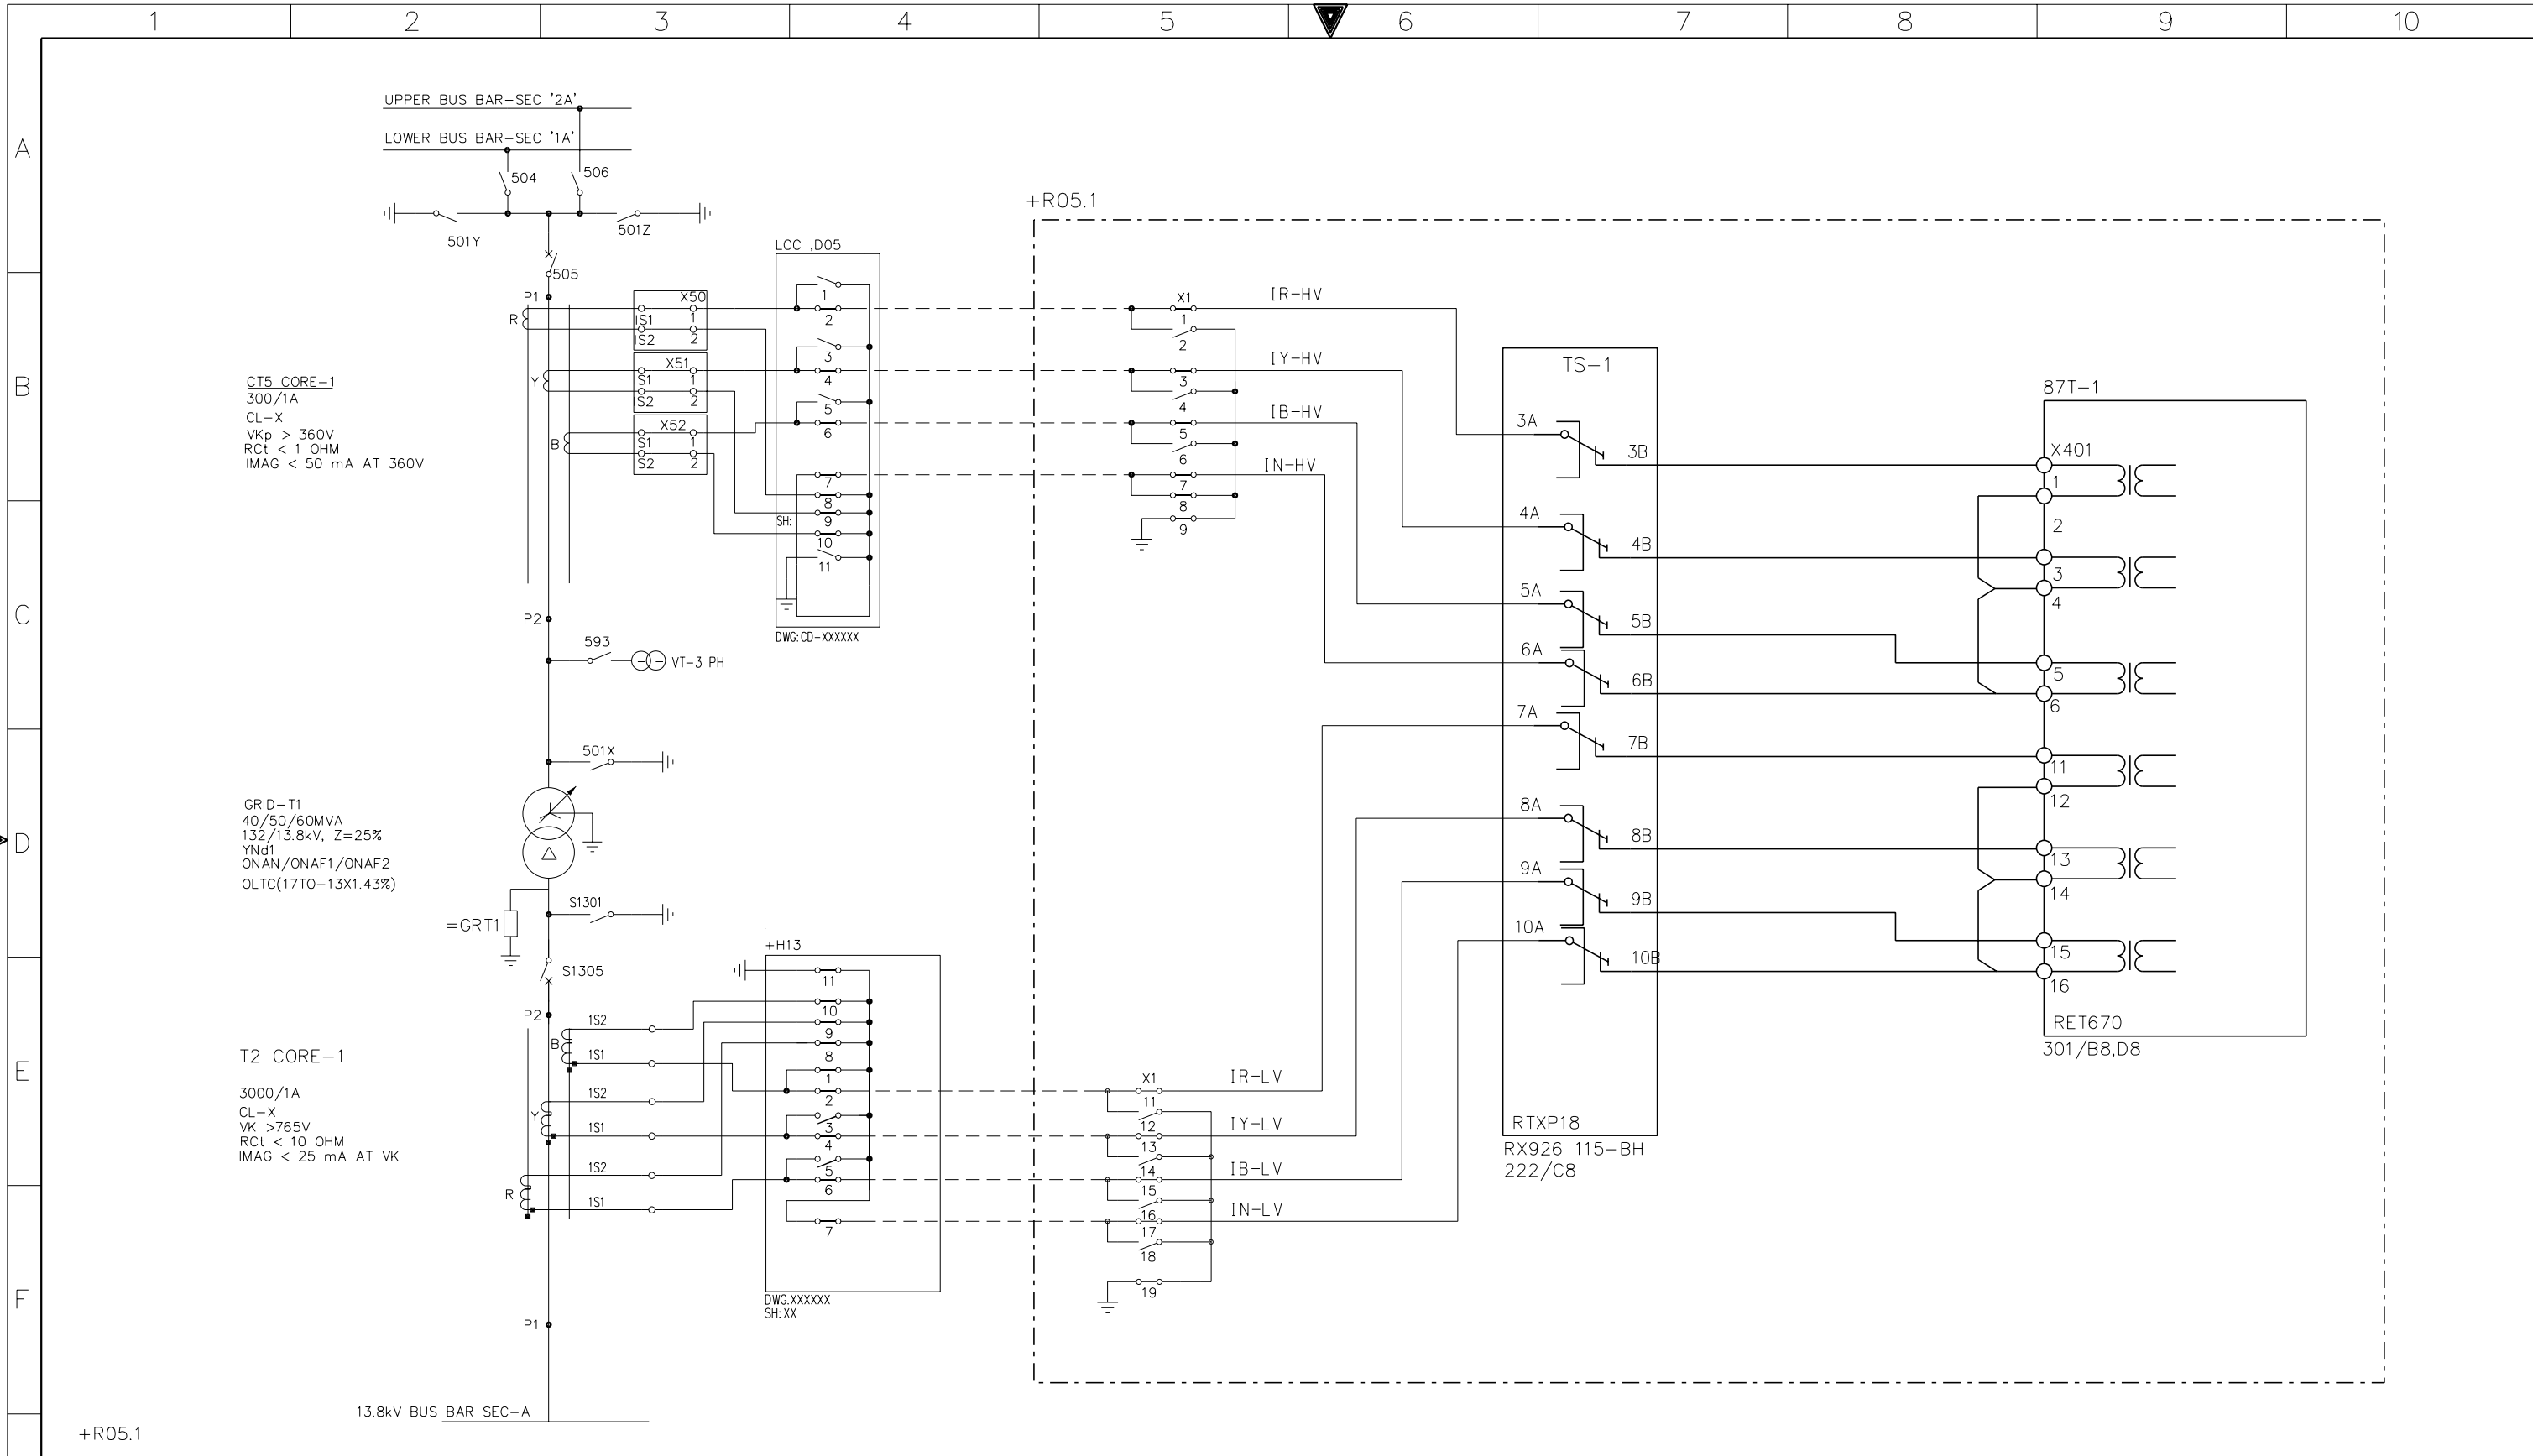

G	AS-BUILT BY _____ DATE _____		CONTRACT NO. 11131113/00		JOB ORDER NO. S-13656		CT CIRCUITS 87T-1 RELAY		<div>الشركة الوطنية لنقل الكهرباء</div> <div>نقل الكهرباء</div> <div>National Grid sa</div>						
				DRAWN BY <u>RIZ</u> CHECKED BY <u>JKR</u>		132/13.8kv GT-1 RELAY PANEL-1 +R05.1									
	01	13 49	FACTORY ASBUILT		DATE STARTED <u>24.01.2013</u> DATE COMPLETED _____		S/S 8709-132/13.8KV IN AL-KHARJ CITY		INDEX	PLANT NO.	DRAWING NUMBER		SHEET NO.		REV. NO.
	00	13 04	FOR APPROVAL		OPRG. DEPT. <u>CTPD</u> ENG. DEPT. <u>AUT-PSAC</u>		RIYADH SAUDI ARABIA		-	C421	CD-322928		SHT	CONT.	01
	REV. NO.	DATE	DESCRIPTION										221	222	



THIS DRAWING AND THE INFORMATION CONTAINED HEREIN ARE THE SOLE PROPERTY OF National Grid SA NO REPRODUCTION IN FULL OR IN PART SHALL BE OBTAINED FROM THIS DOCUMENT WITHOUT THE WRITTEN CONSENT OF ITS OWNER.

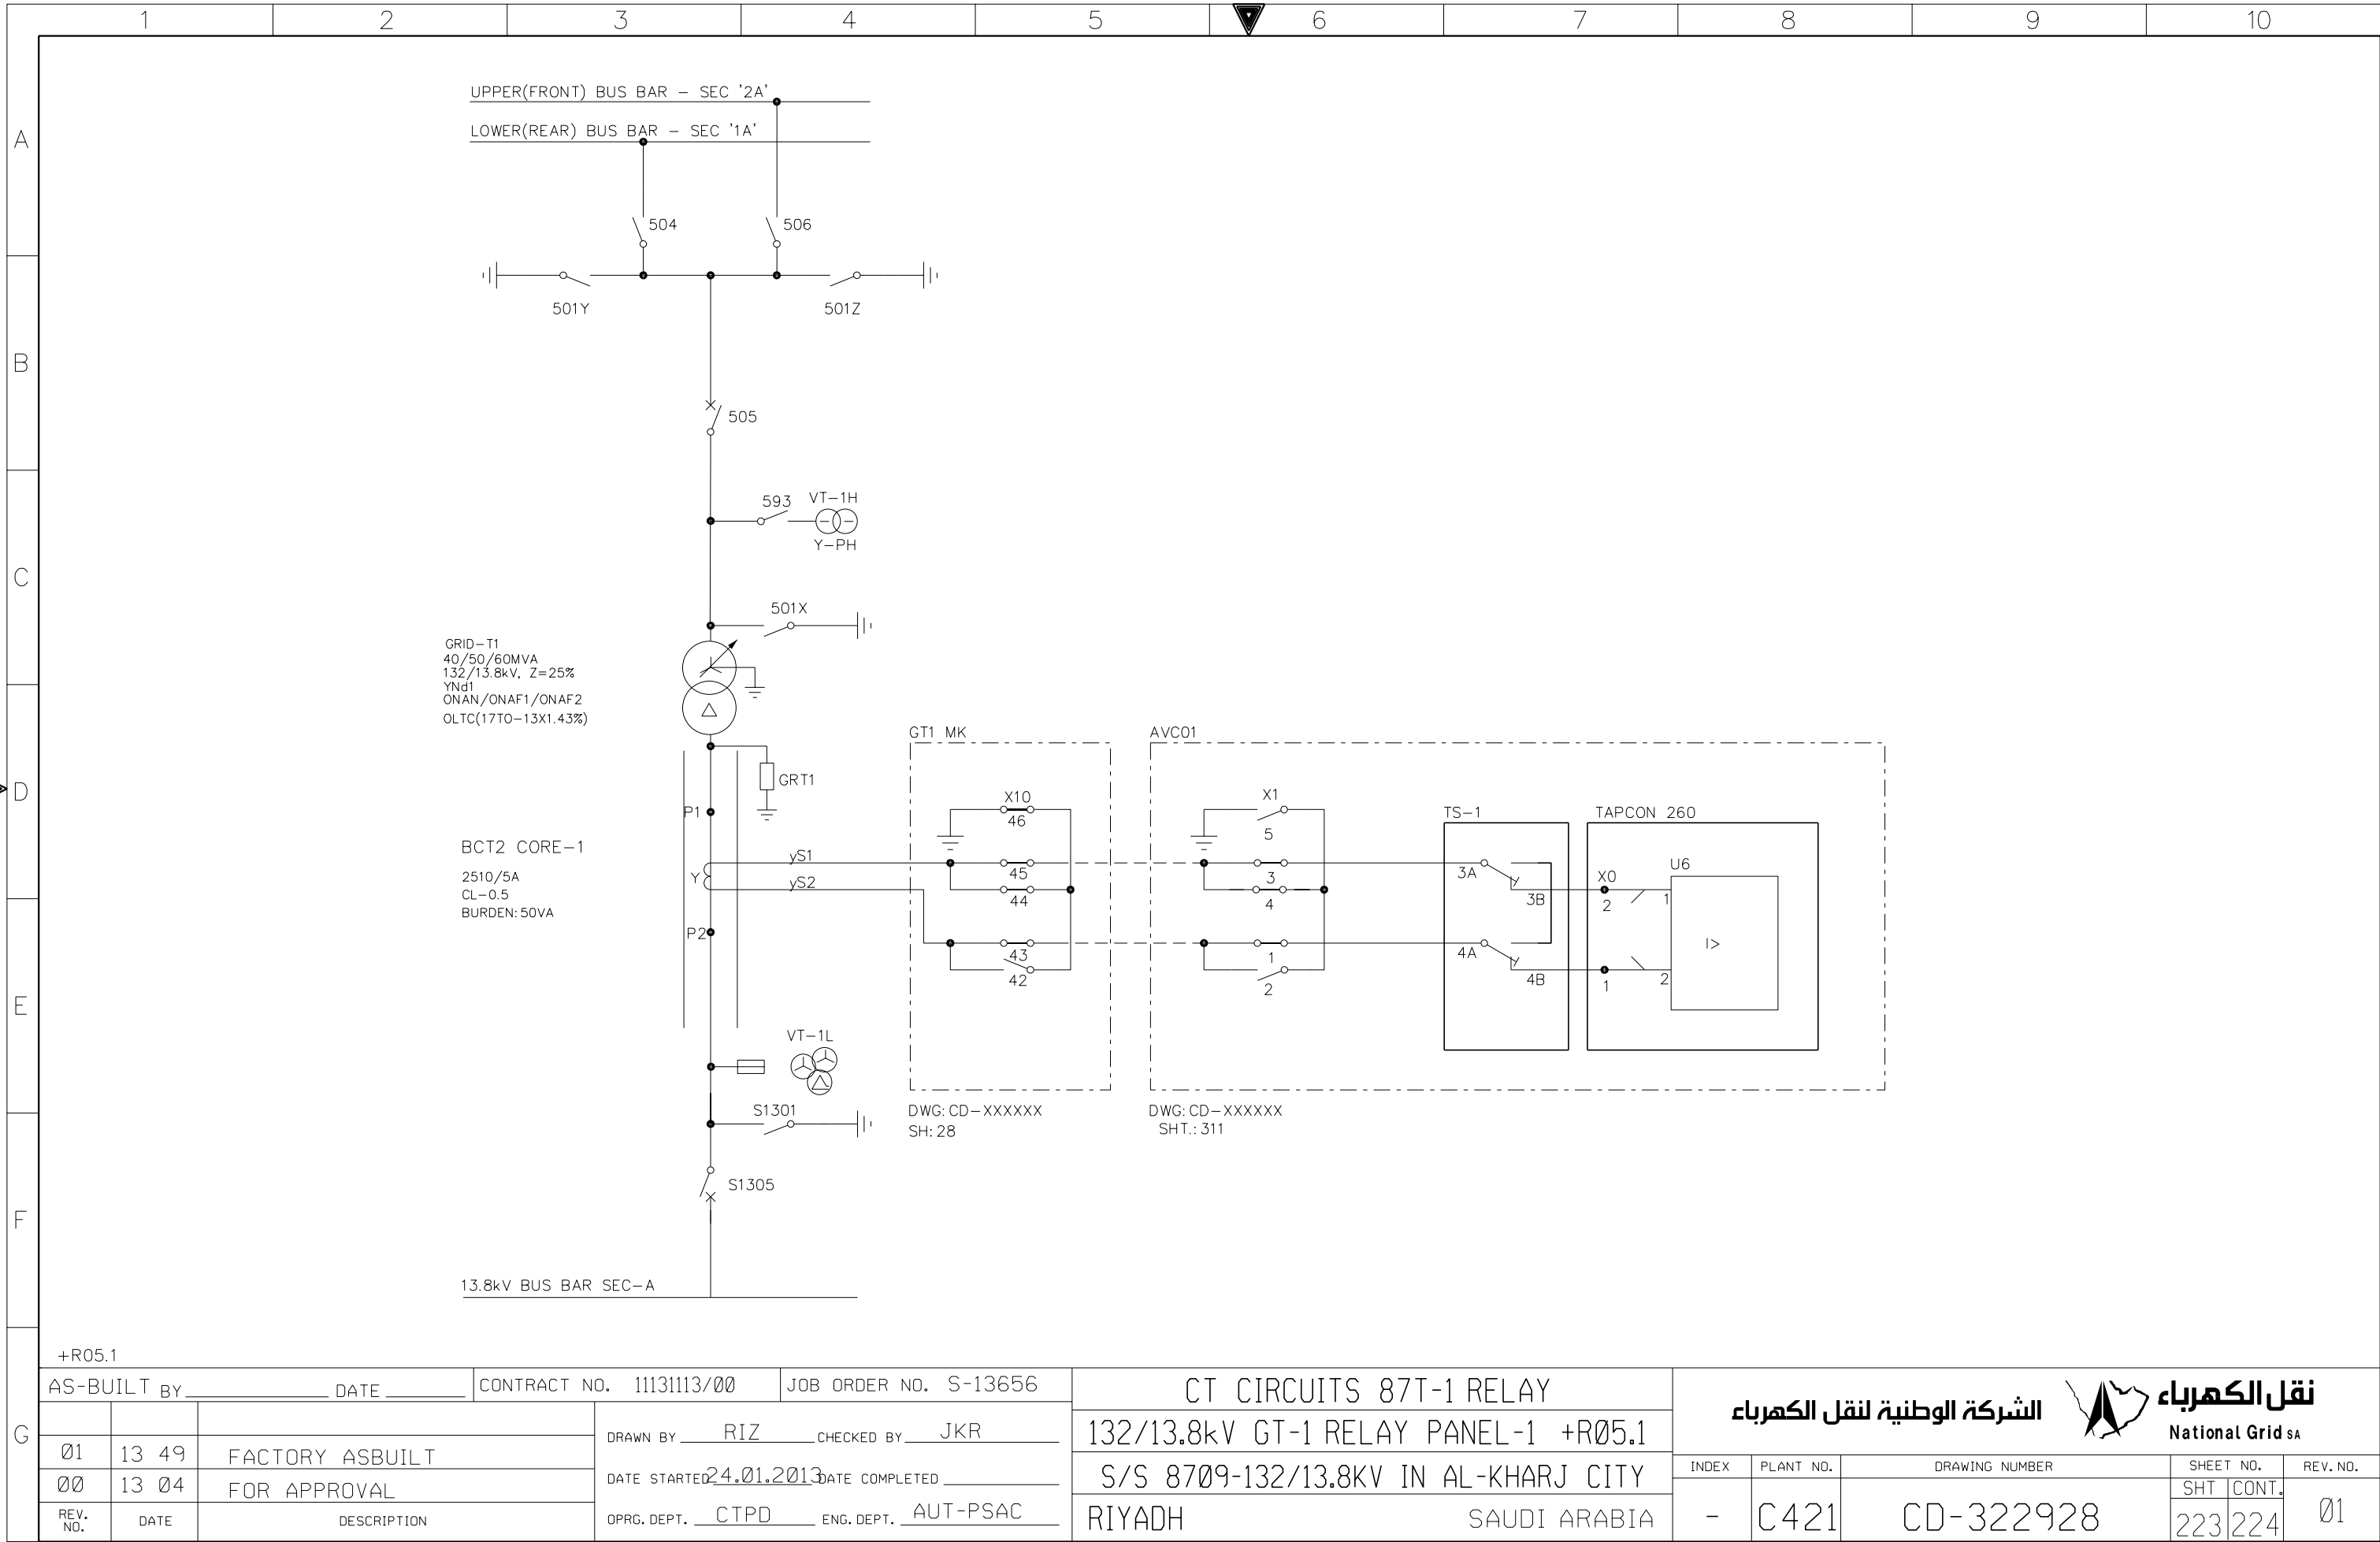

+R05.1

AS-BUILT BY \_\_\_\_\_ DATE \_\_\_\_\_ CONTRACT NO. 11131113/00 JOB ORDER NO. S-13656

01	13 49	FACTORY ASBUILT	DRAWN BY RIZ CHECKED BY JKR
00	13 04	FOR APPROVAL	DATE STARTED 24.01.2013 DATE COMPLETED _____
REV. NO.	DATE	DESCRIPTION	OPRG. DEPT. CTPD ENG. DEPT. AUT-PSAC


CT CIRCUITS 87T-1 RELAY  
132/13.8kV GT-1 RELAY PANEL-1 +R05.1  
S/S 8709-132/13.8KV IN AL-KHARJ CITY  
RIYADH SAUDI ARABIA

الشركة الوطنية لنقل الكهرباء National Grid sa				
INDEX	PLANT NO.	DRAWING NUMBER	SHEET NO.	
-	C421	CD-322928	SHT	CONT.
			223	224
				01

NG/D2-D (2012/01)

DMS VECTOR NGD200



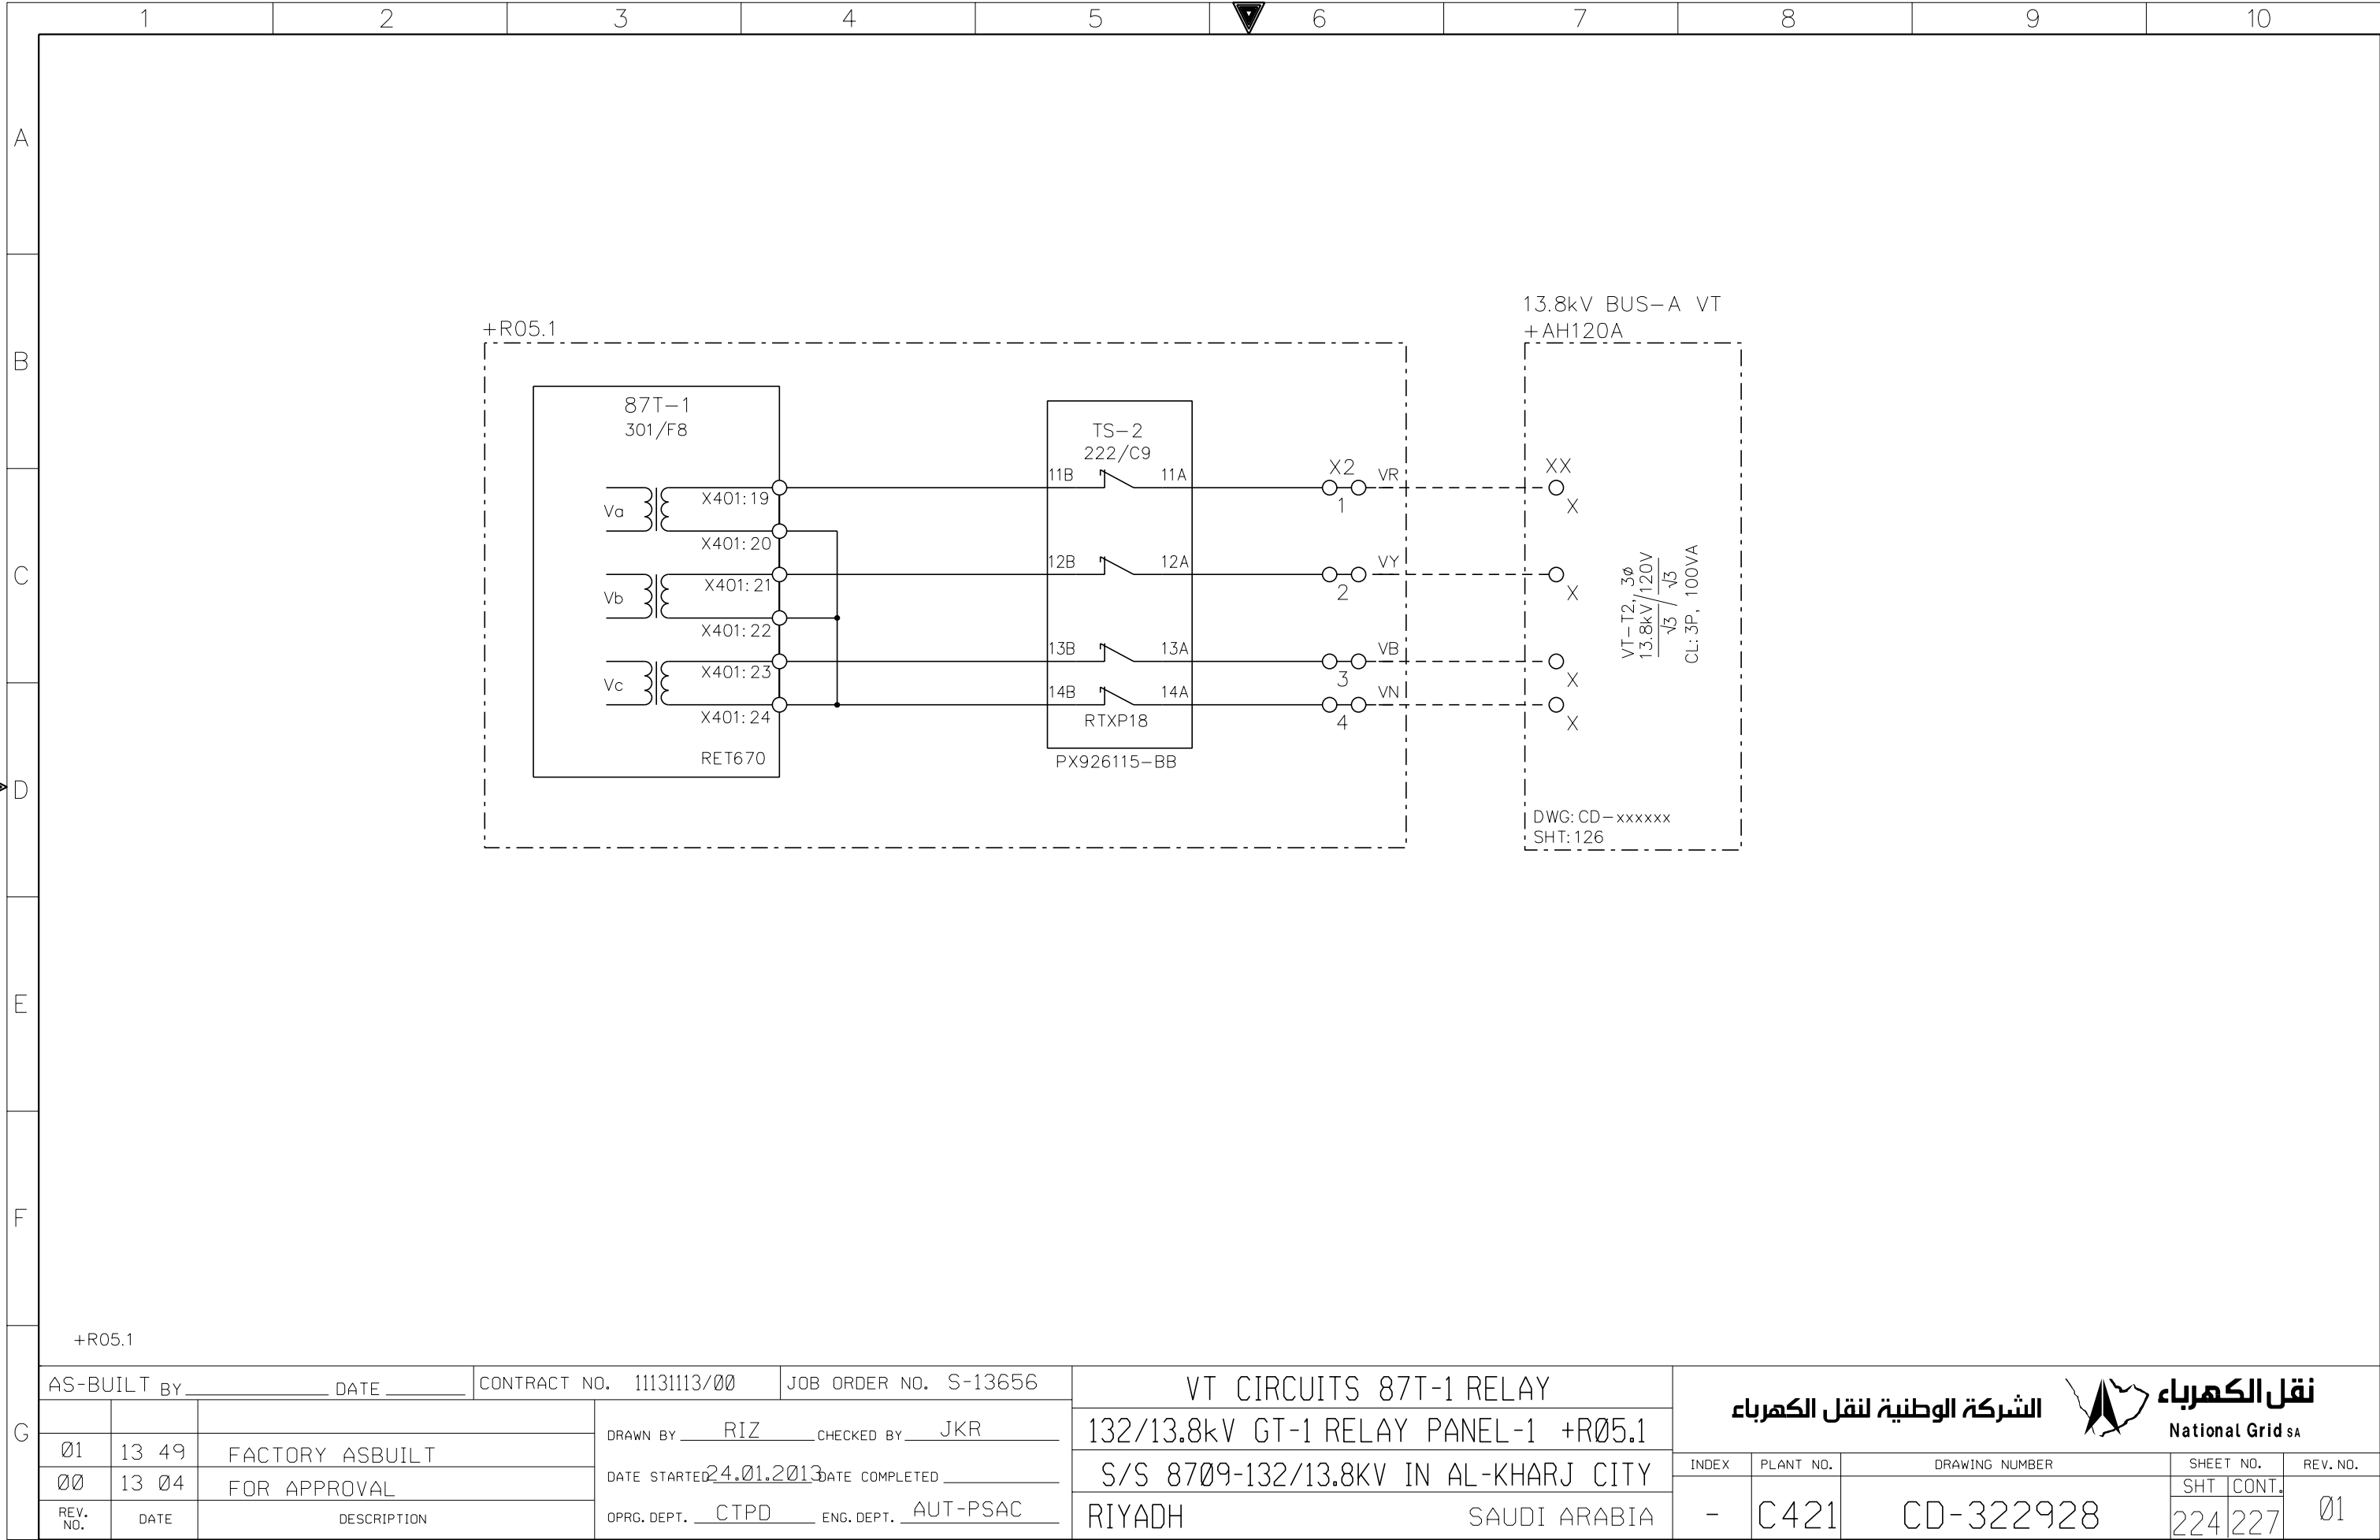

+R05.1

AS-BUILT BY \_\_\_\_\_ DATE \_\_\_\_\_ CONTRACT NO. 11131113/00 JOB ORDER NO. S-13656

01

13 49

FACTORY ASBUILT

00

13 04

FOR APPROVAL

REV. NO.

DATE

DESCRIPTION

DRAWN BY RIZ CHECKED BY JKR

DATE STARTED 24.01.2013 DATE COMPLETED \_\_\_\_\_

OPRG. DEPT. CTPD ENG. DEPT. AUT-PSAC

VT CIRCUITS 87T-1 RELAY

132/13.8kV GT-1 RELAY PANEL-1 +R05.1

S/S 8709-132/13.8KV IN AL-KHARJ CITY

RIYADH SAUDI ARABIA

الشركة الوطنية لنقل الكهرباء

 **نقل الكهرباء**  
National Grid sa

INDEX

PLANT NO.

DRAWING NUMBER

SHEET NO.

SHT

CONT.

REV. NO.

-

C421

CD-322928

224

227


01

NG/D2-D (2012/01)

DMS

VECTOR

NGD200

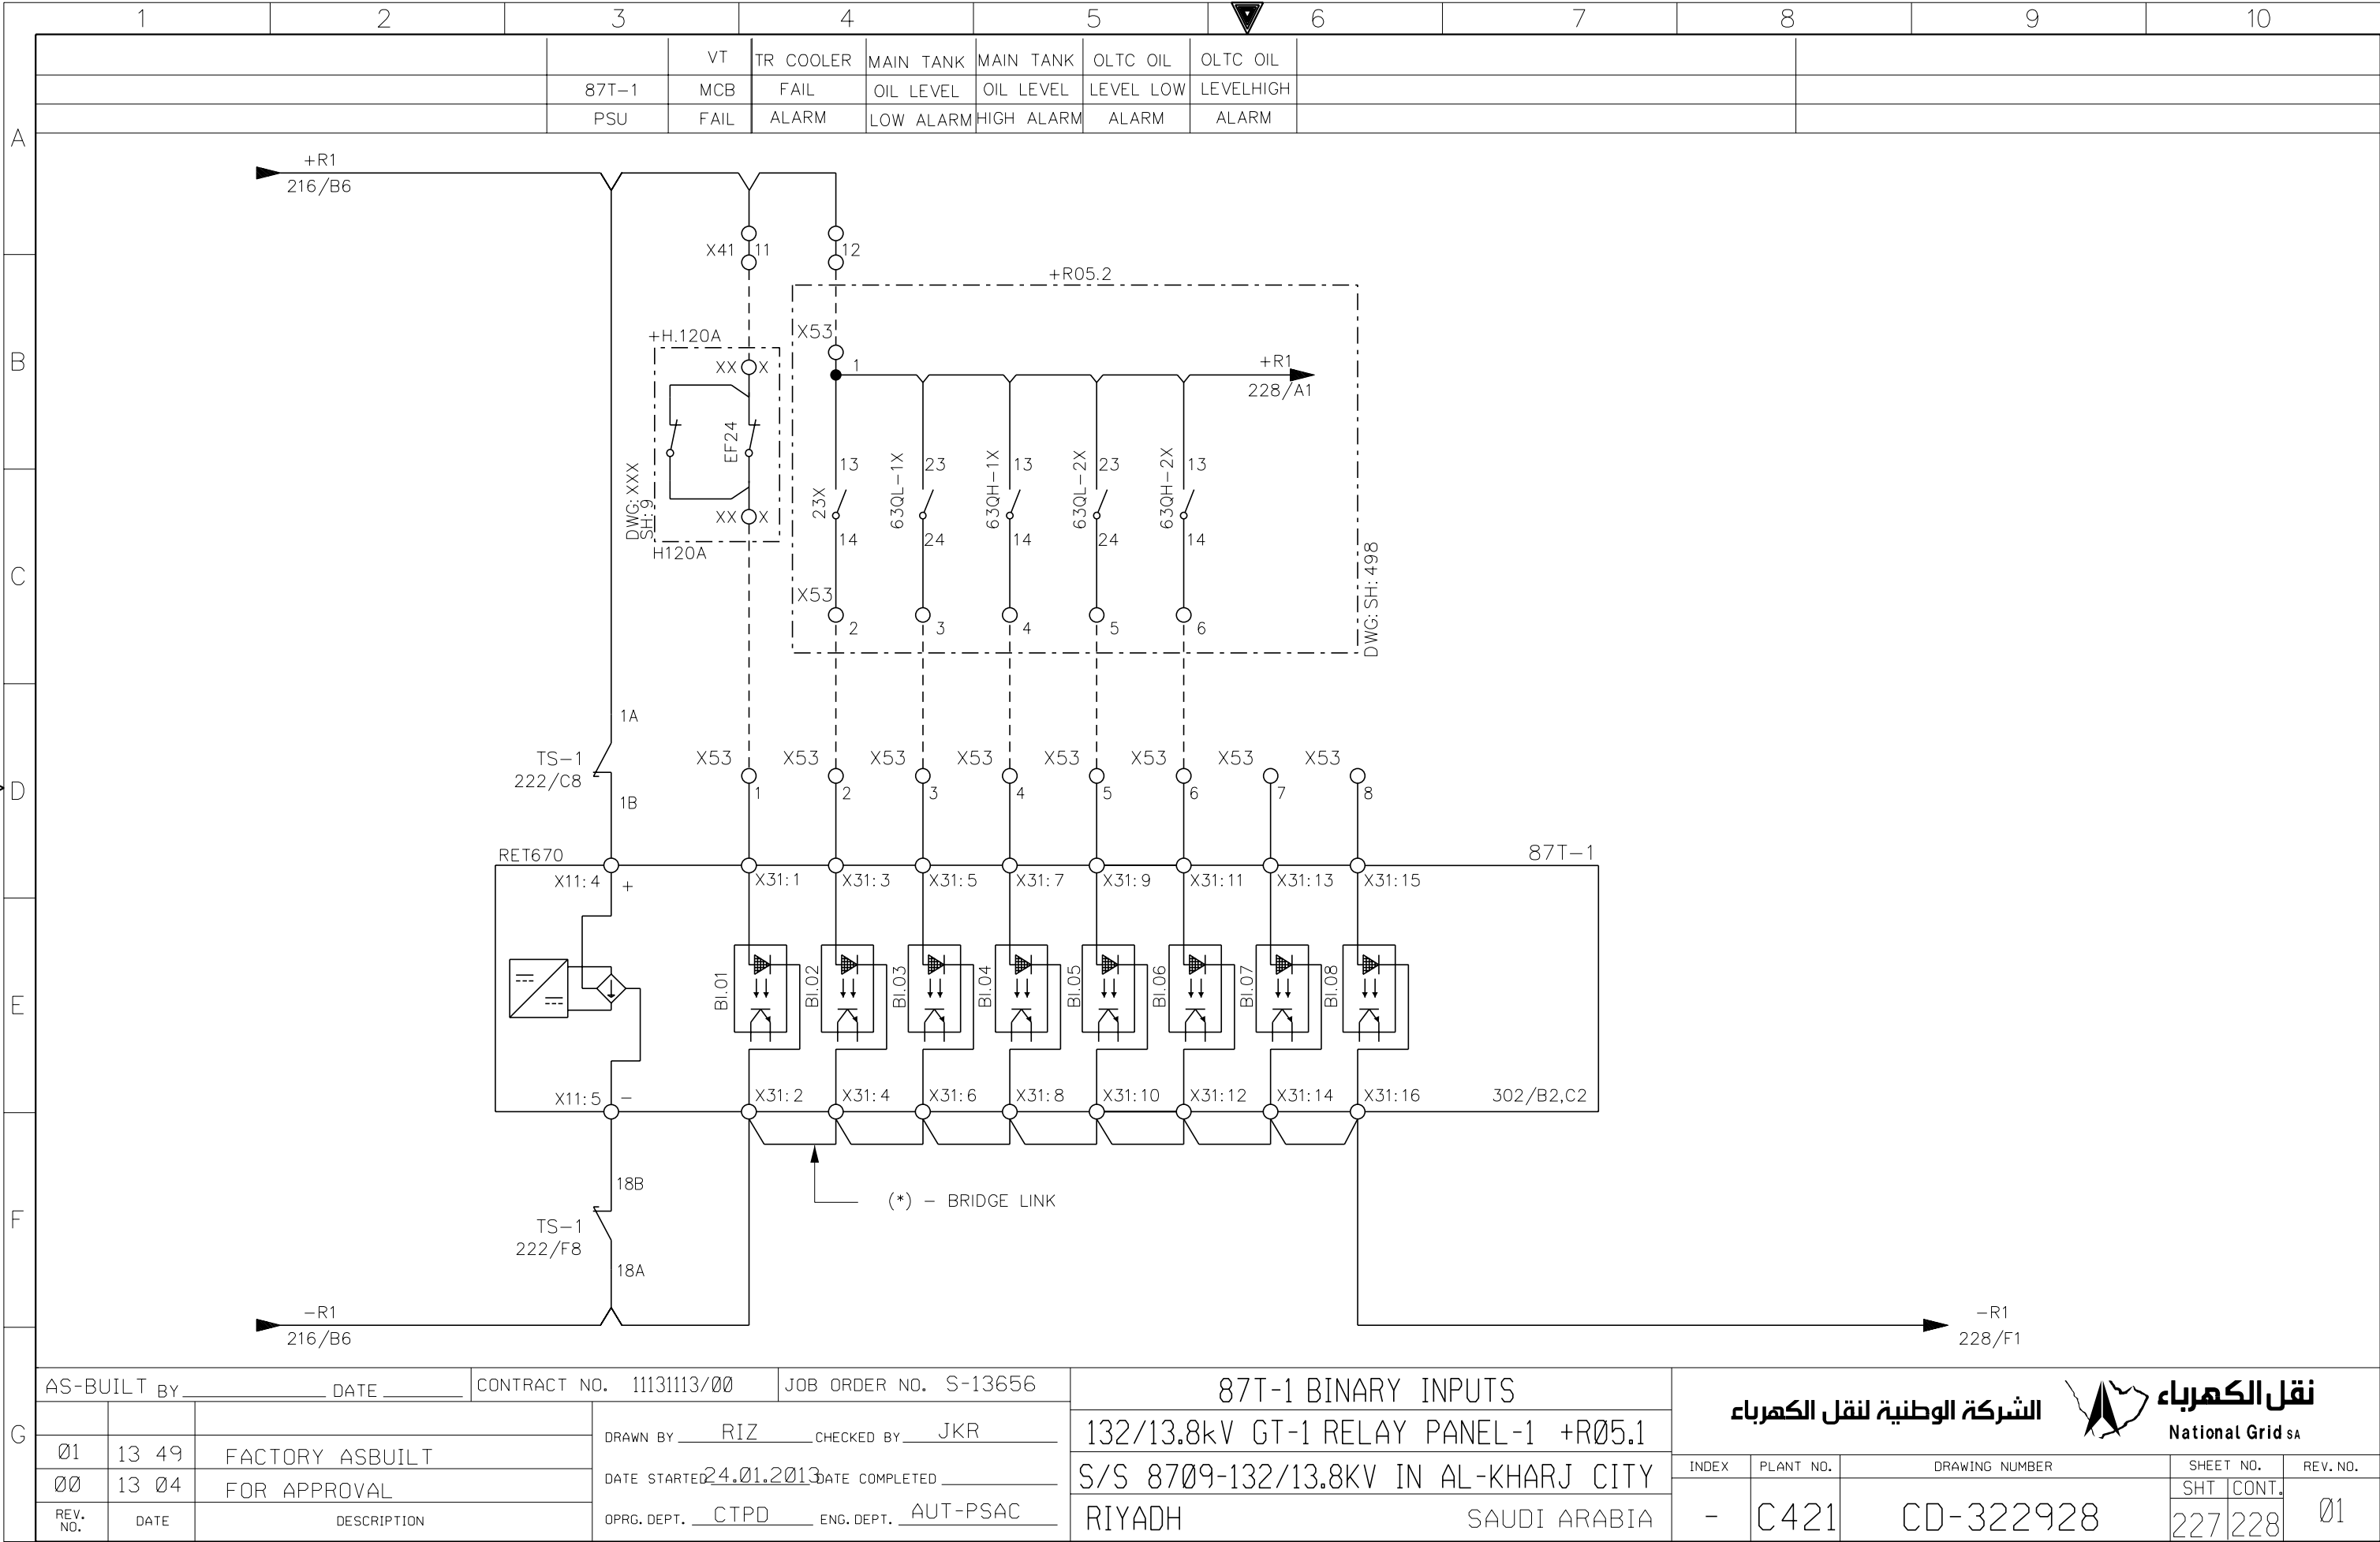


AS-BUILT BY \_\_\_\_\_ DATE \_\_\_\_\_ CONTRACT NO. 11131113/00 JOB ORDER NO. S-13656


01	13 49	FACTORY ASBUILT	DRAWN BY RIZ	CHECKED BY JKR
00	13 04	FOR APPROVAL	DATE STARTED 24.01.2013	DATE COMPLETED
REV. NO.	DATE	DESCRIPTION	OPRG. DEPT. CTPD	ENG. DEPT. AUT-PSAC

87T-1 BINARY INPUTS  
132/13.8kV GT-1 RELAY PANEL-1 +R05.1  
S/S 8709-132/13.8KV IN AL-KHARJ CITY  
RIYADH SAUDI ARABIA

الشركة الوطنية لنقل الكهرباء National Grid sa				
INDEX	PLANT NO.	DRAWING NUMBER	SHEET NO.	REV. NO.
-	C421	CD-322928	SHT 227	CONT. 228
			01	

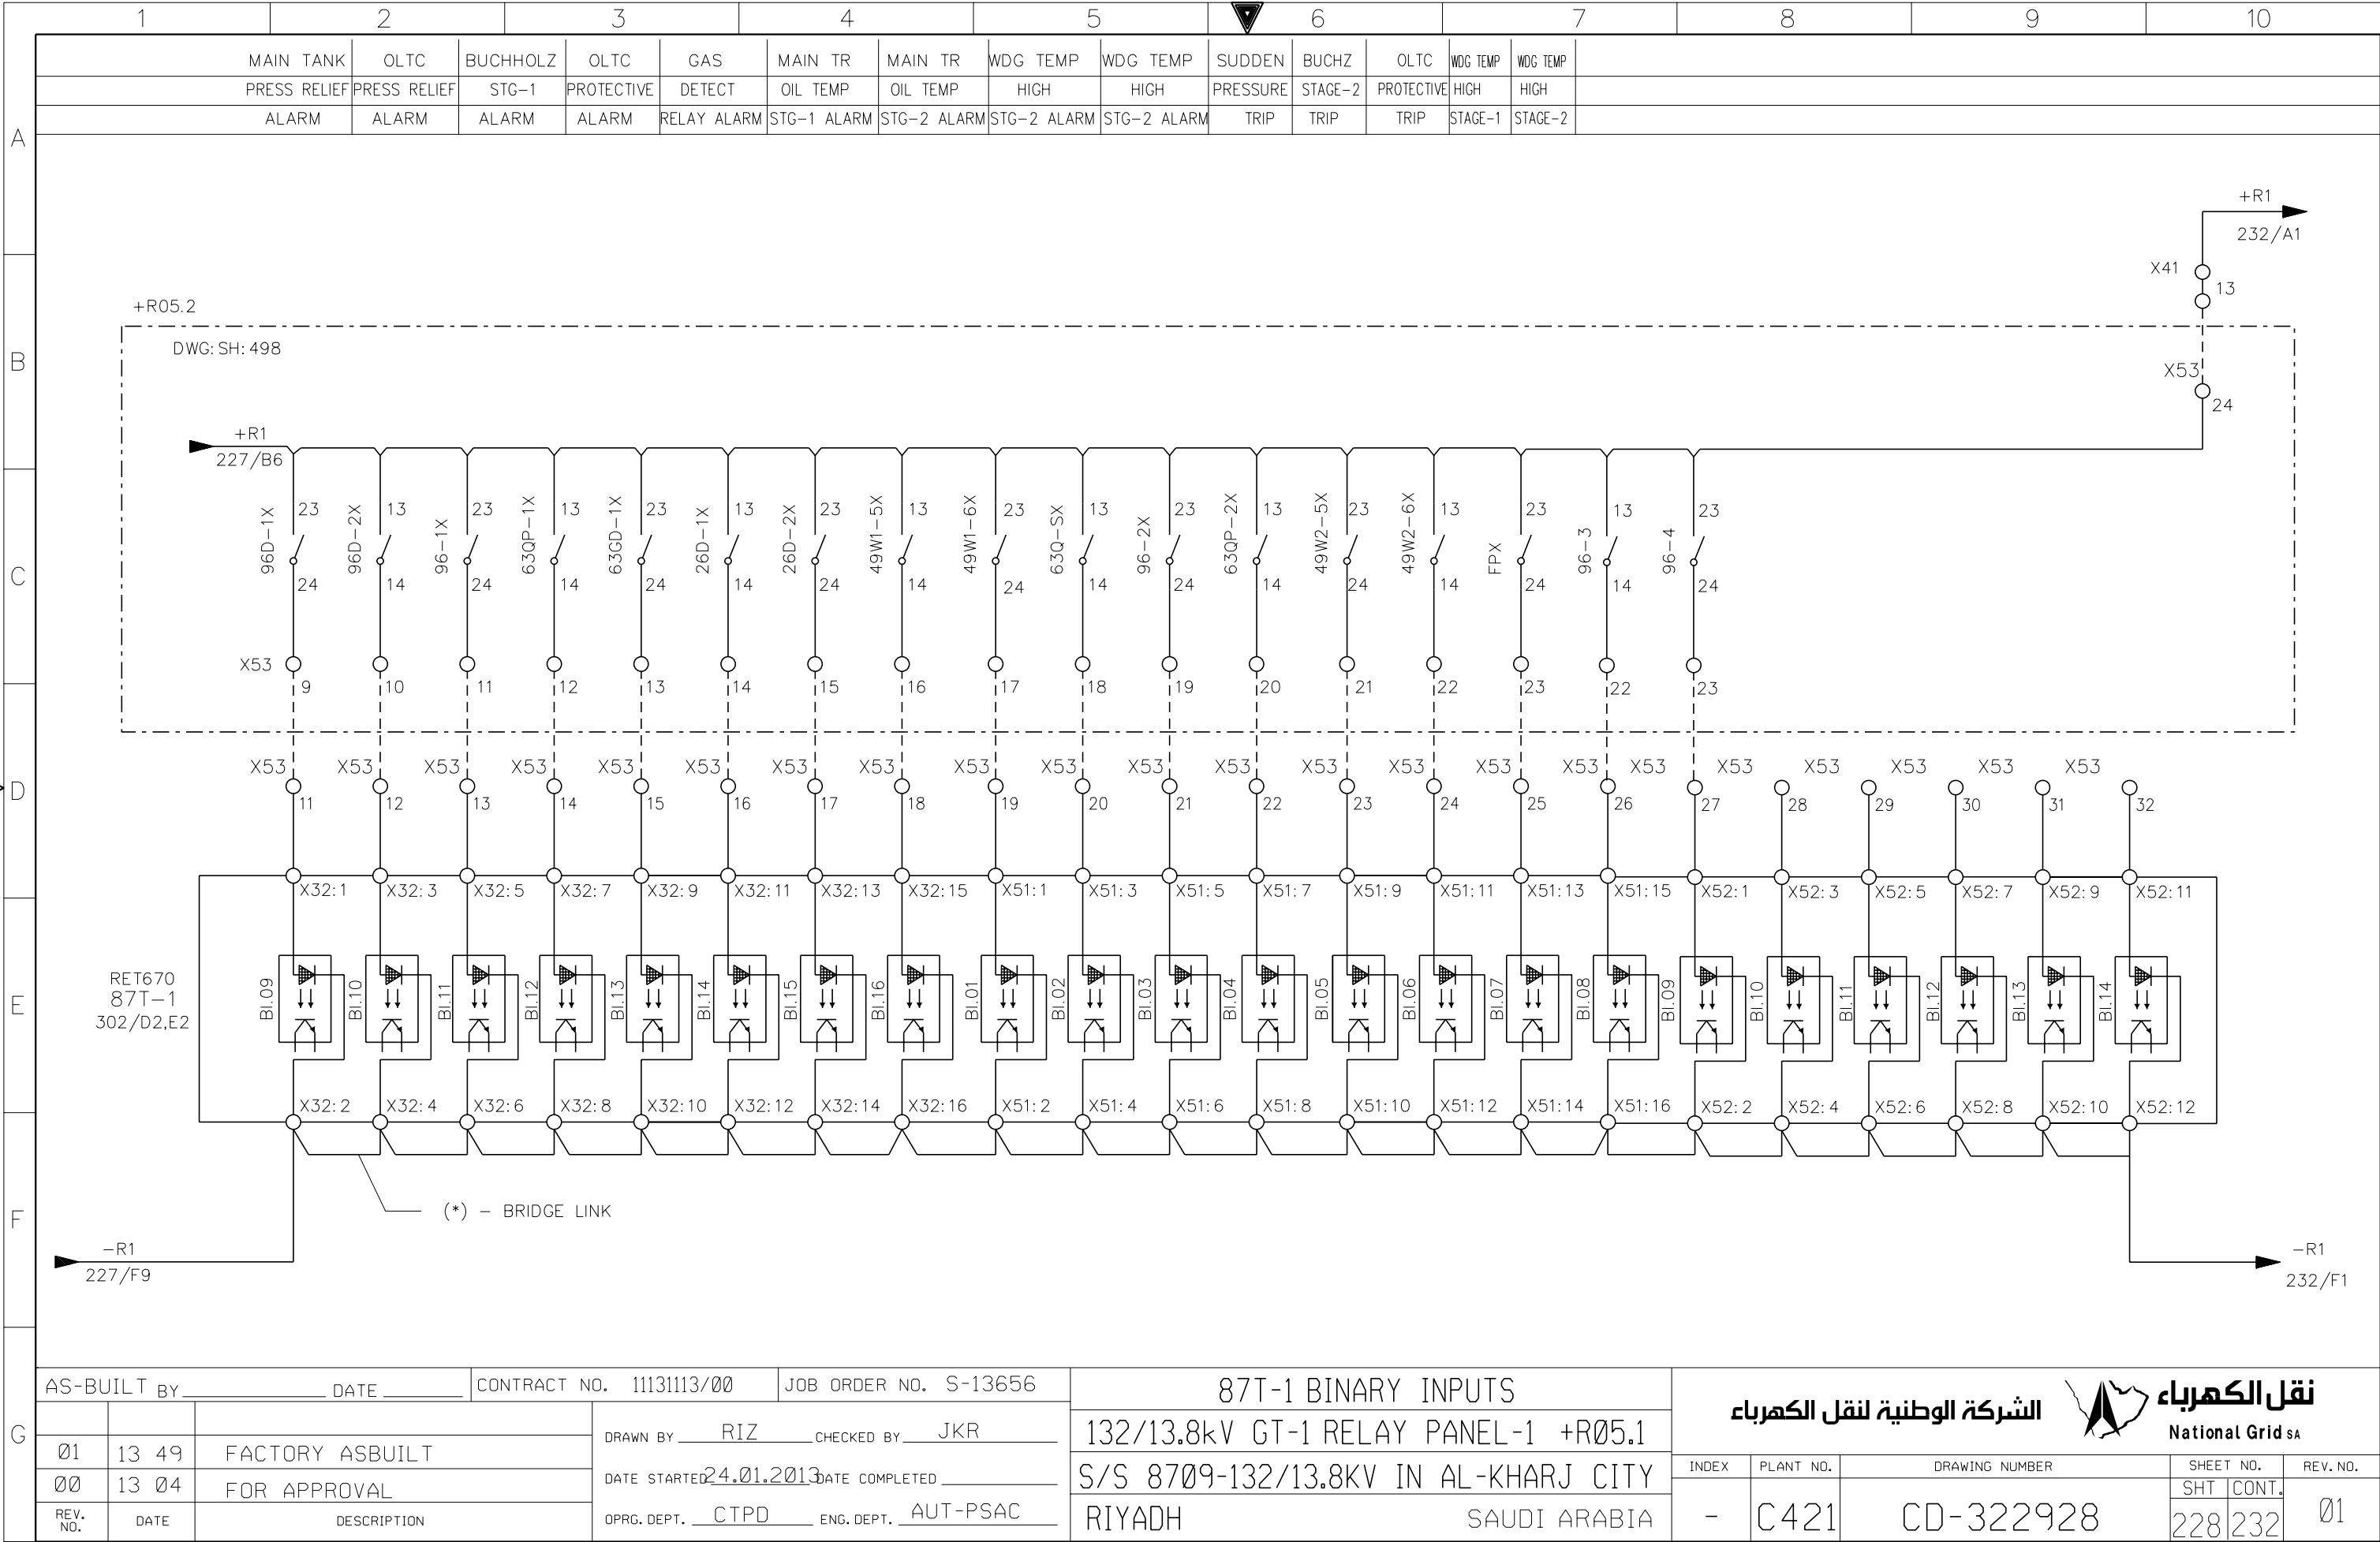


THIS DRAWING AND THE INFORMATION CONTAINED HEREIN ARE THE SOLE PROPERTY OF National Grid SA. NO REPRODUCTION IN FULL OR IN PART SHALL BE OBTAINED FROM THIS DOCUMENT WITHOUT THE WRITTEN CONSENT OF ITS OWNER.

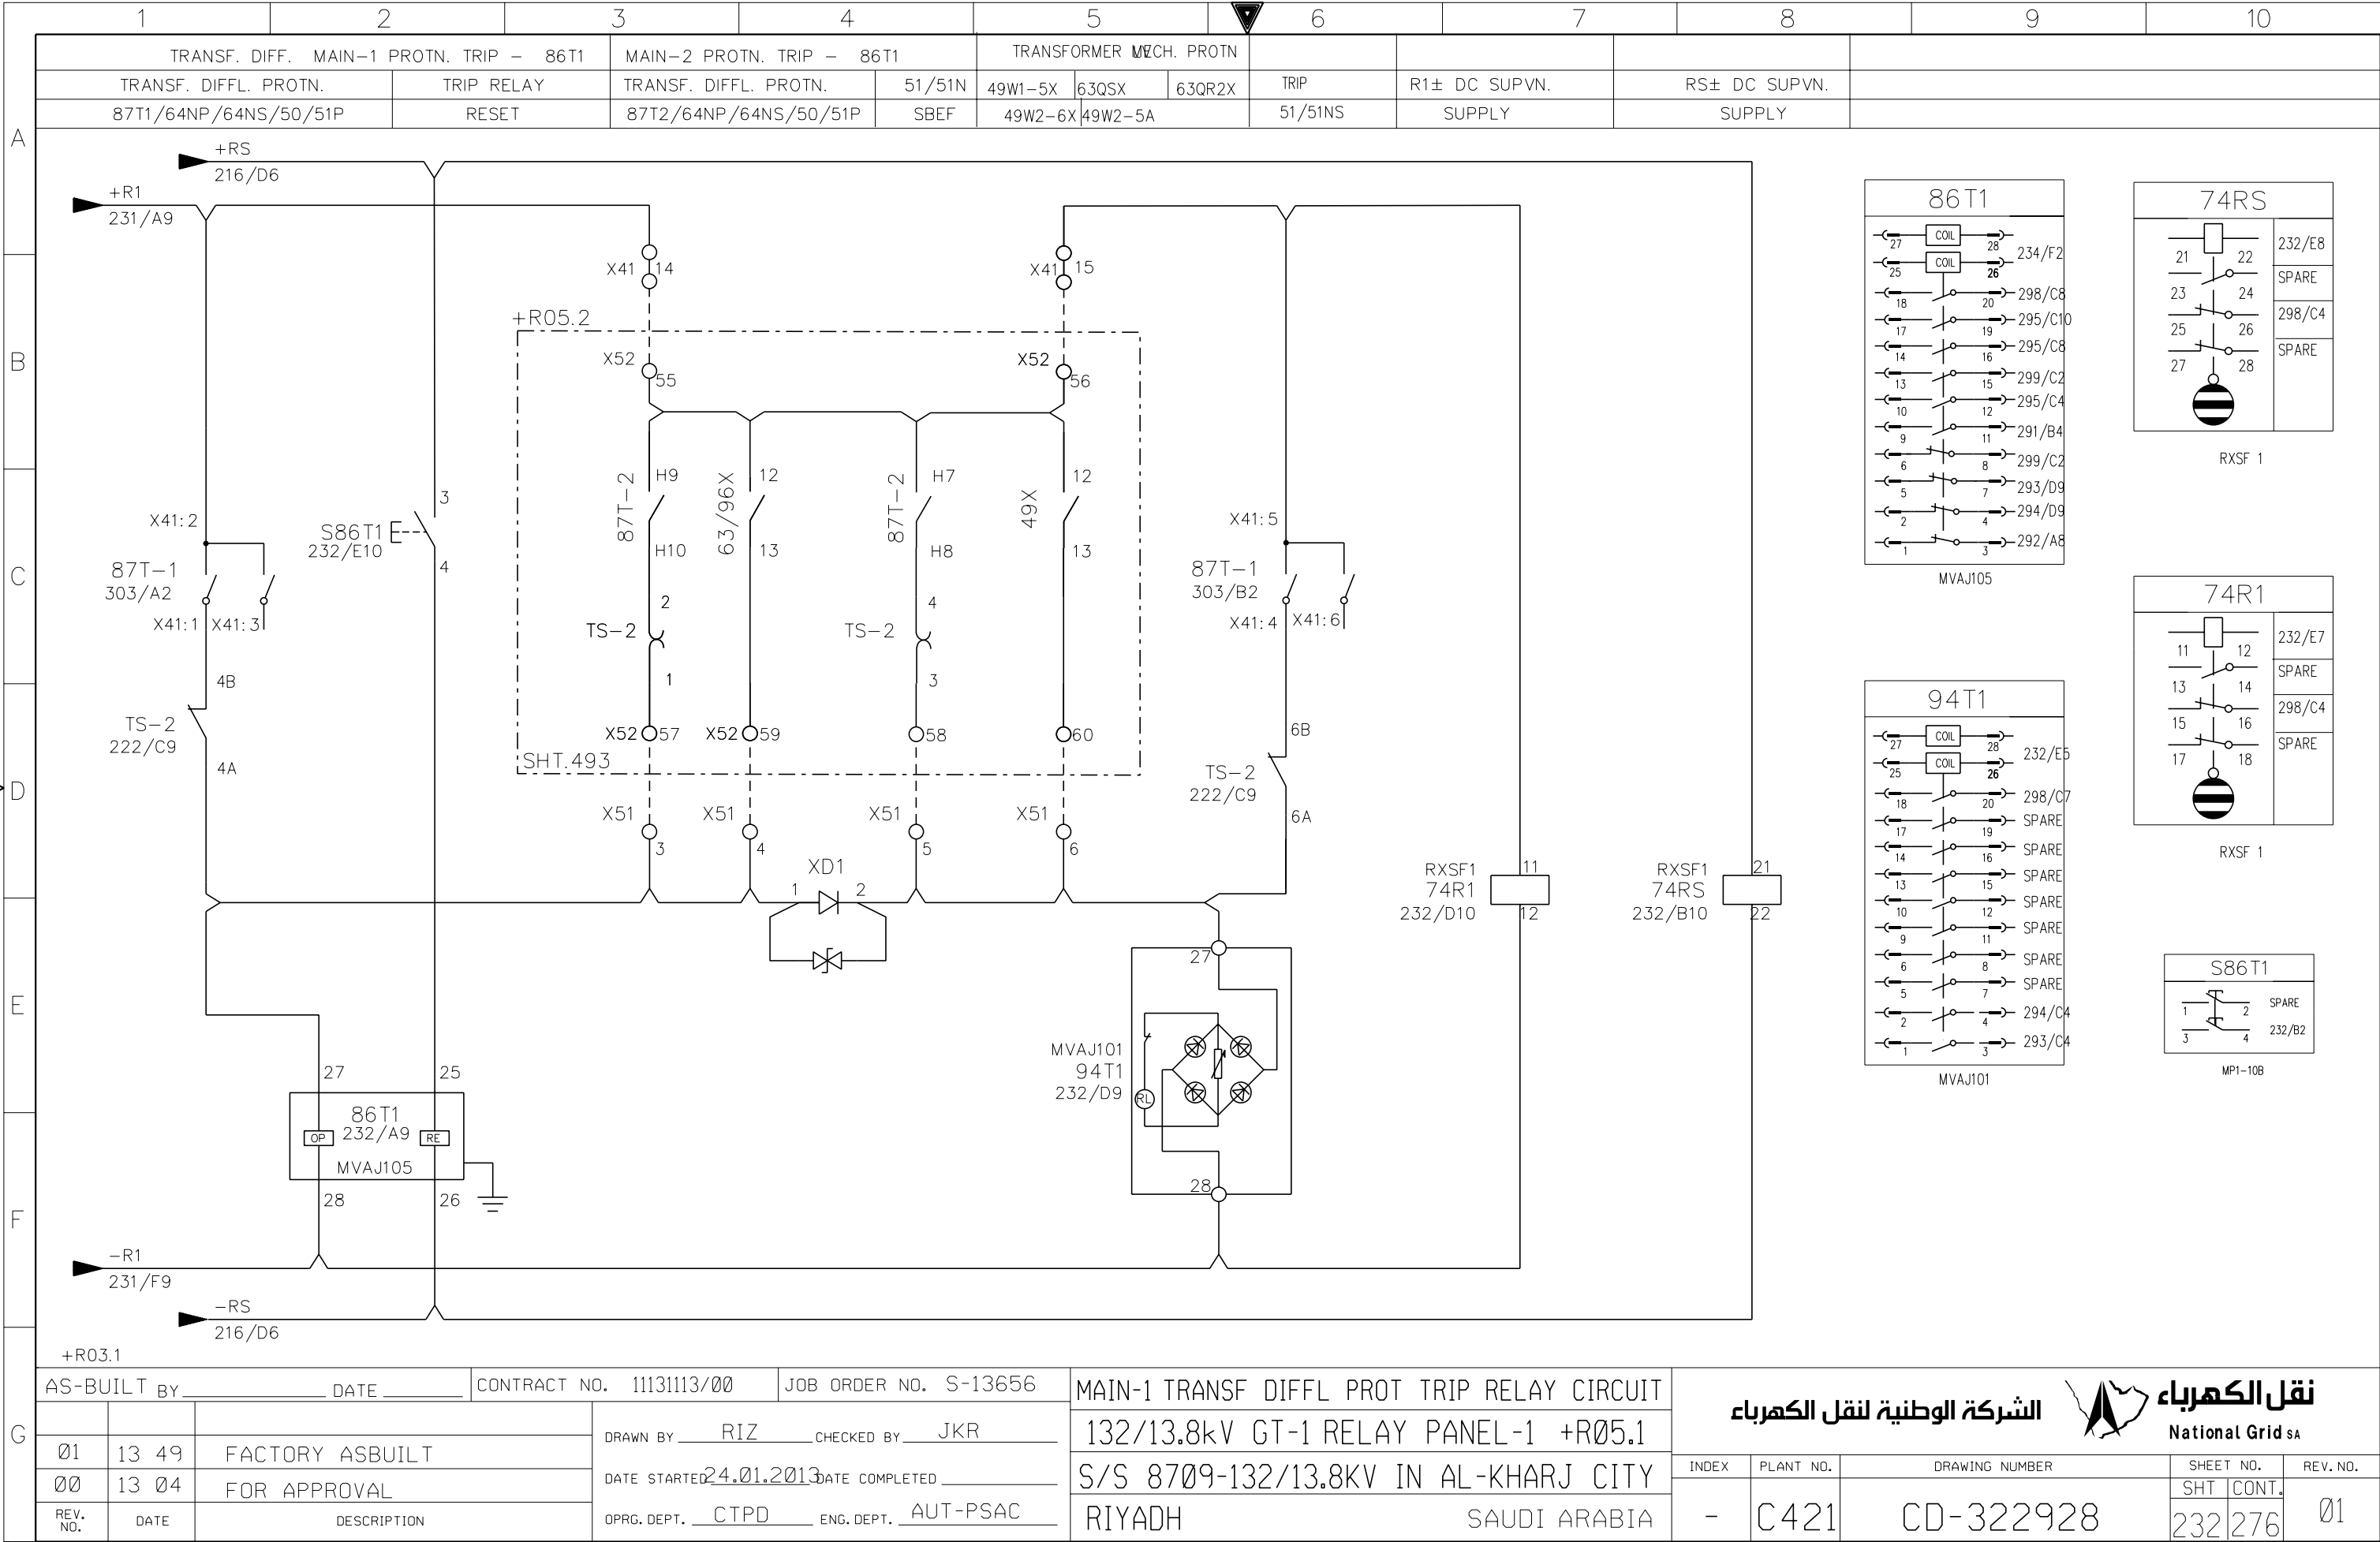






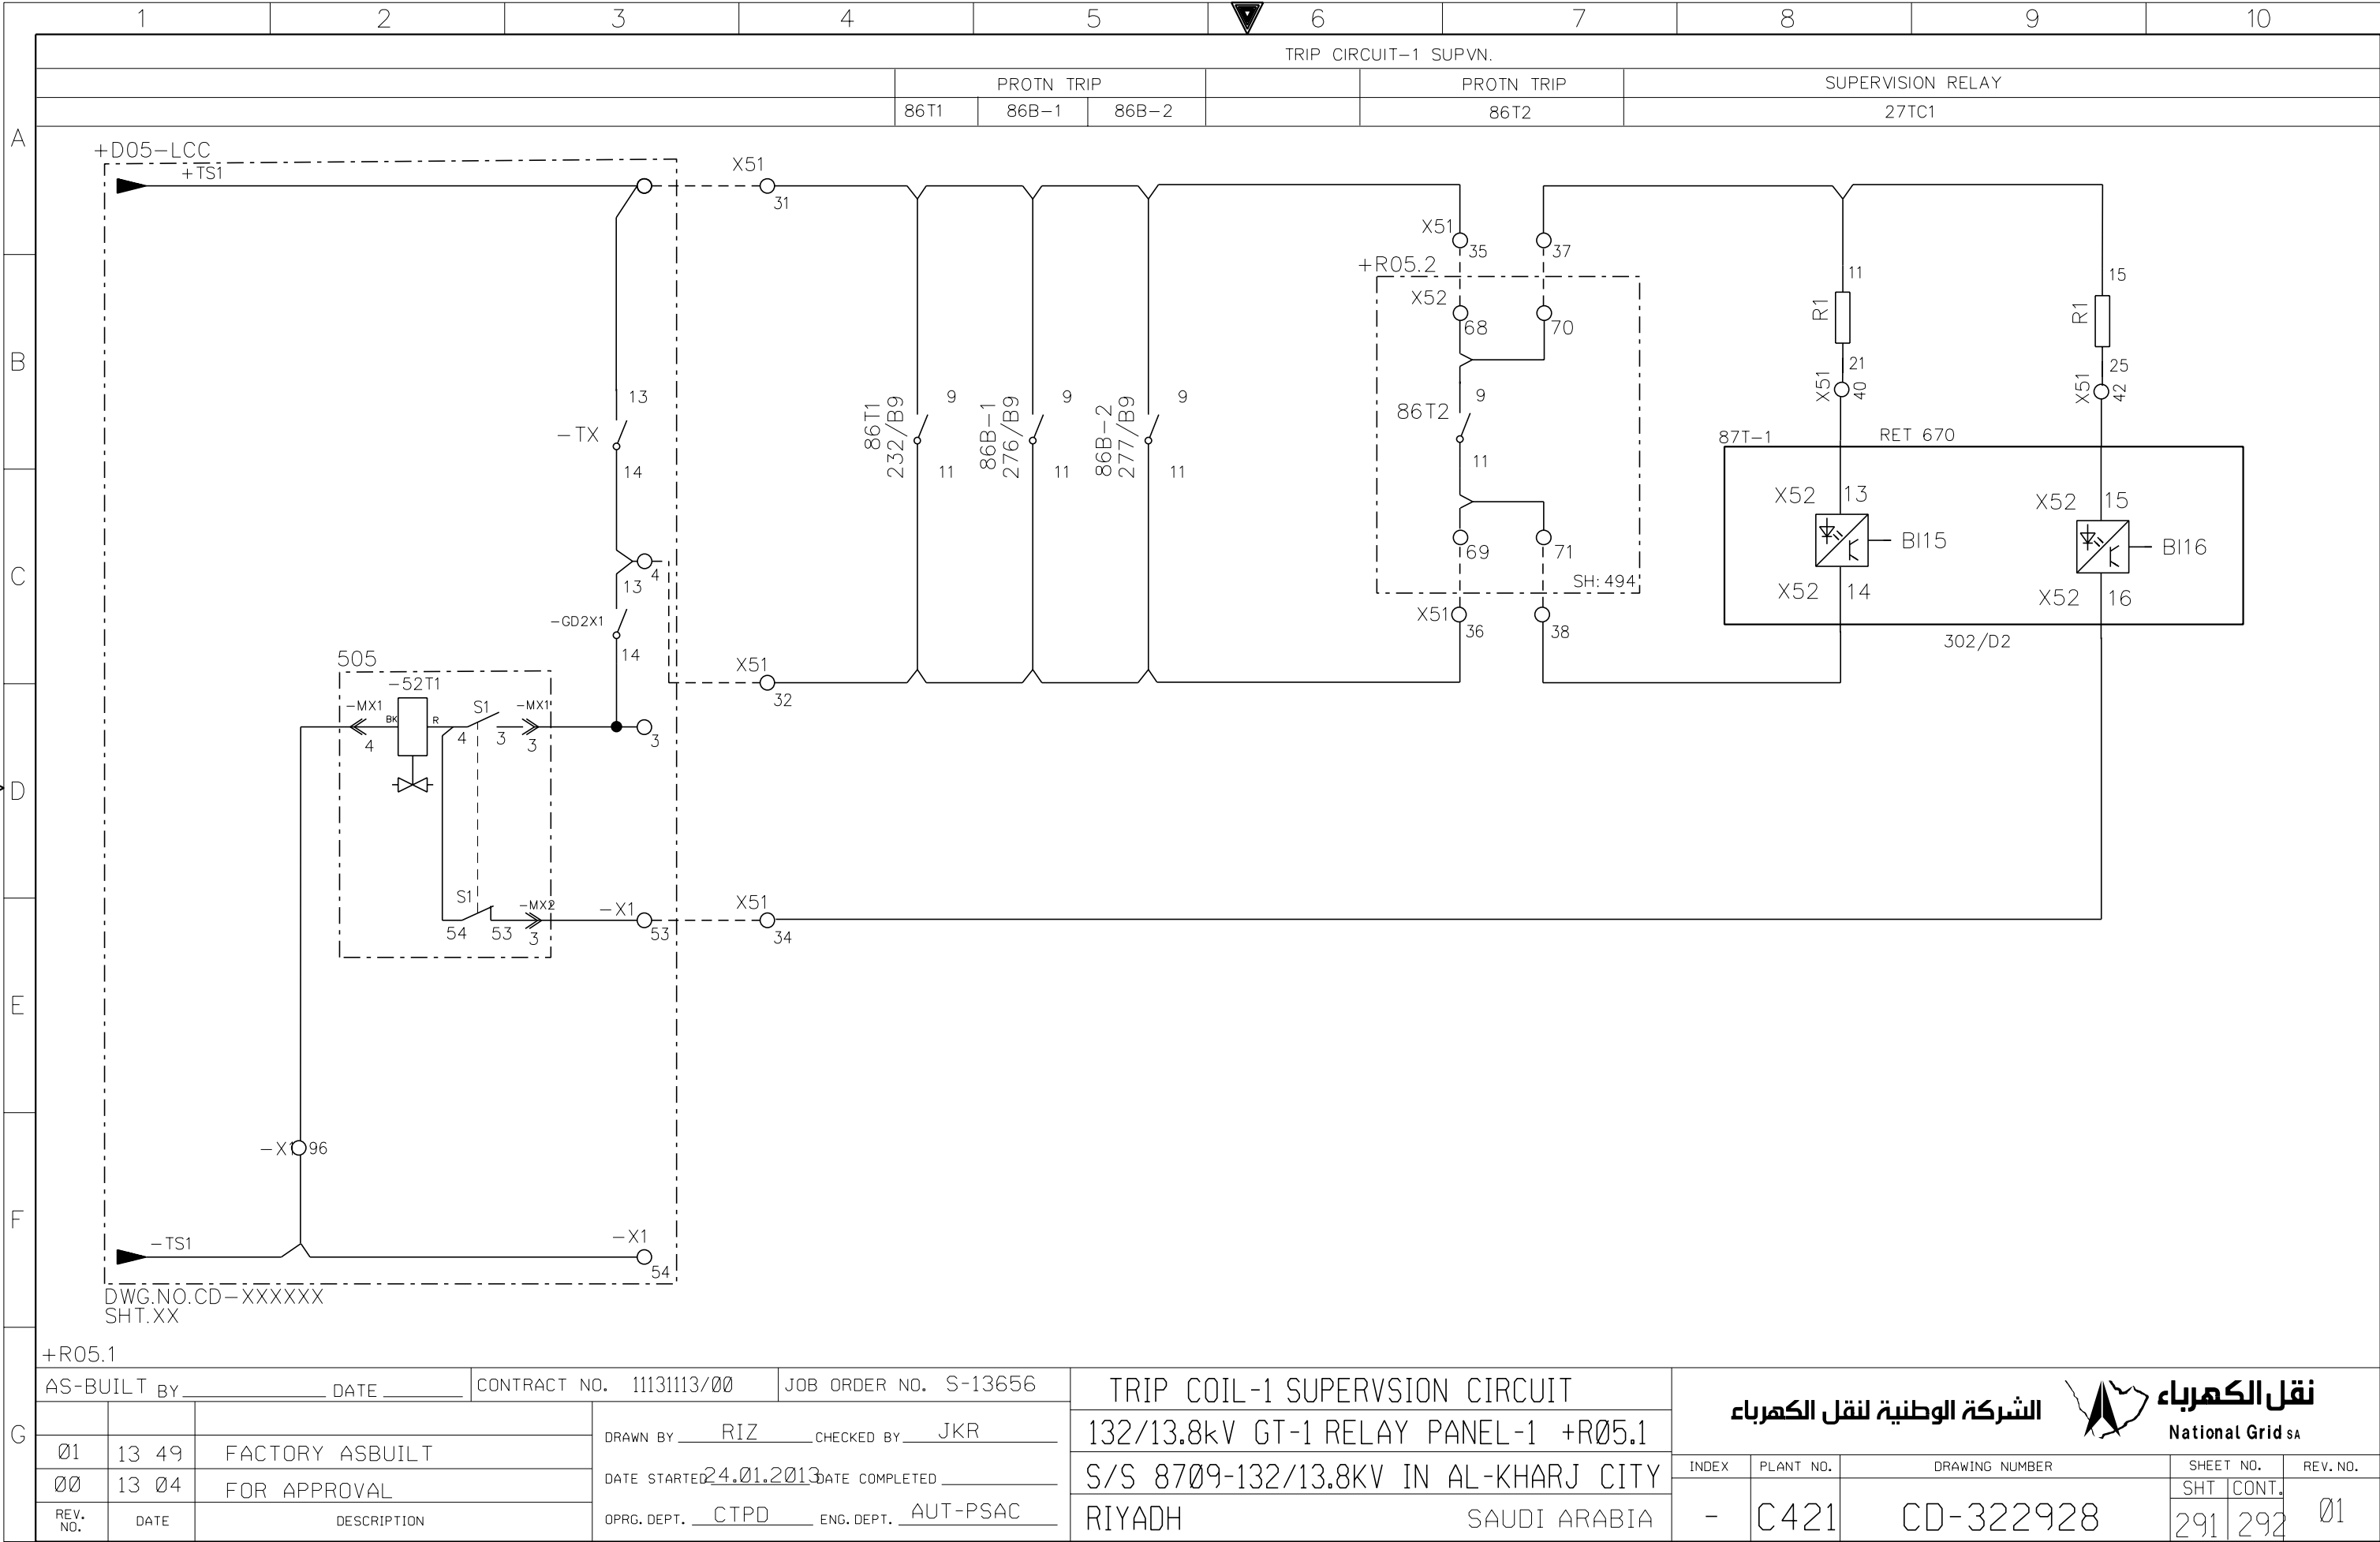


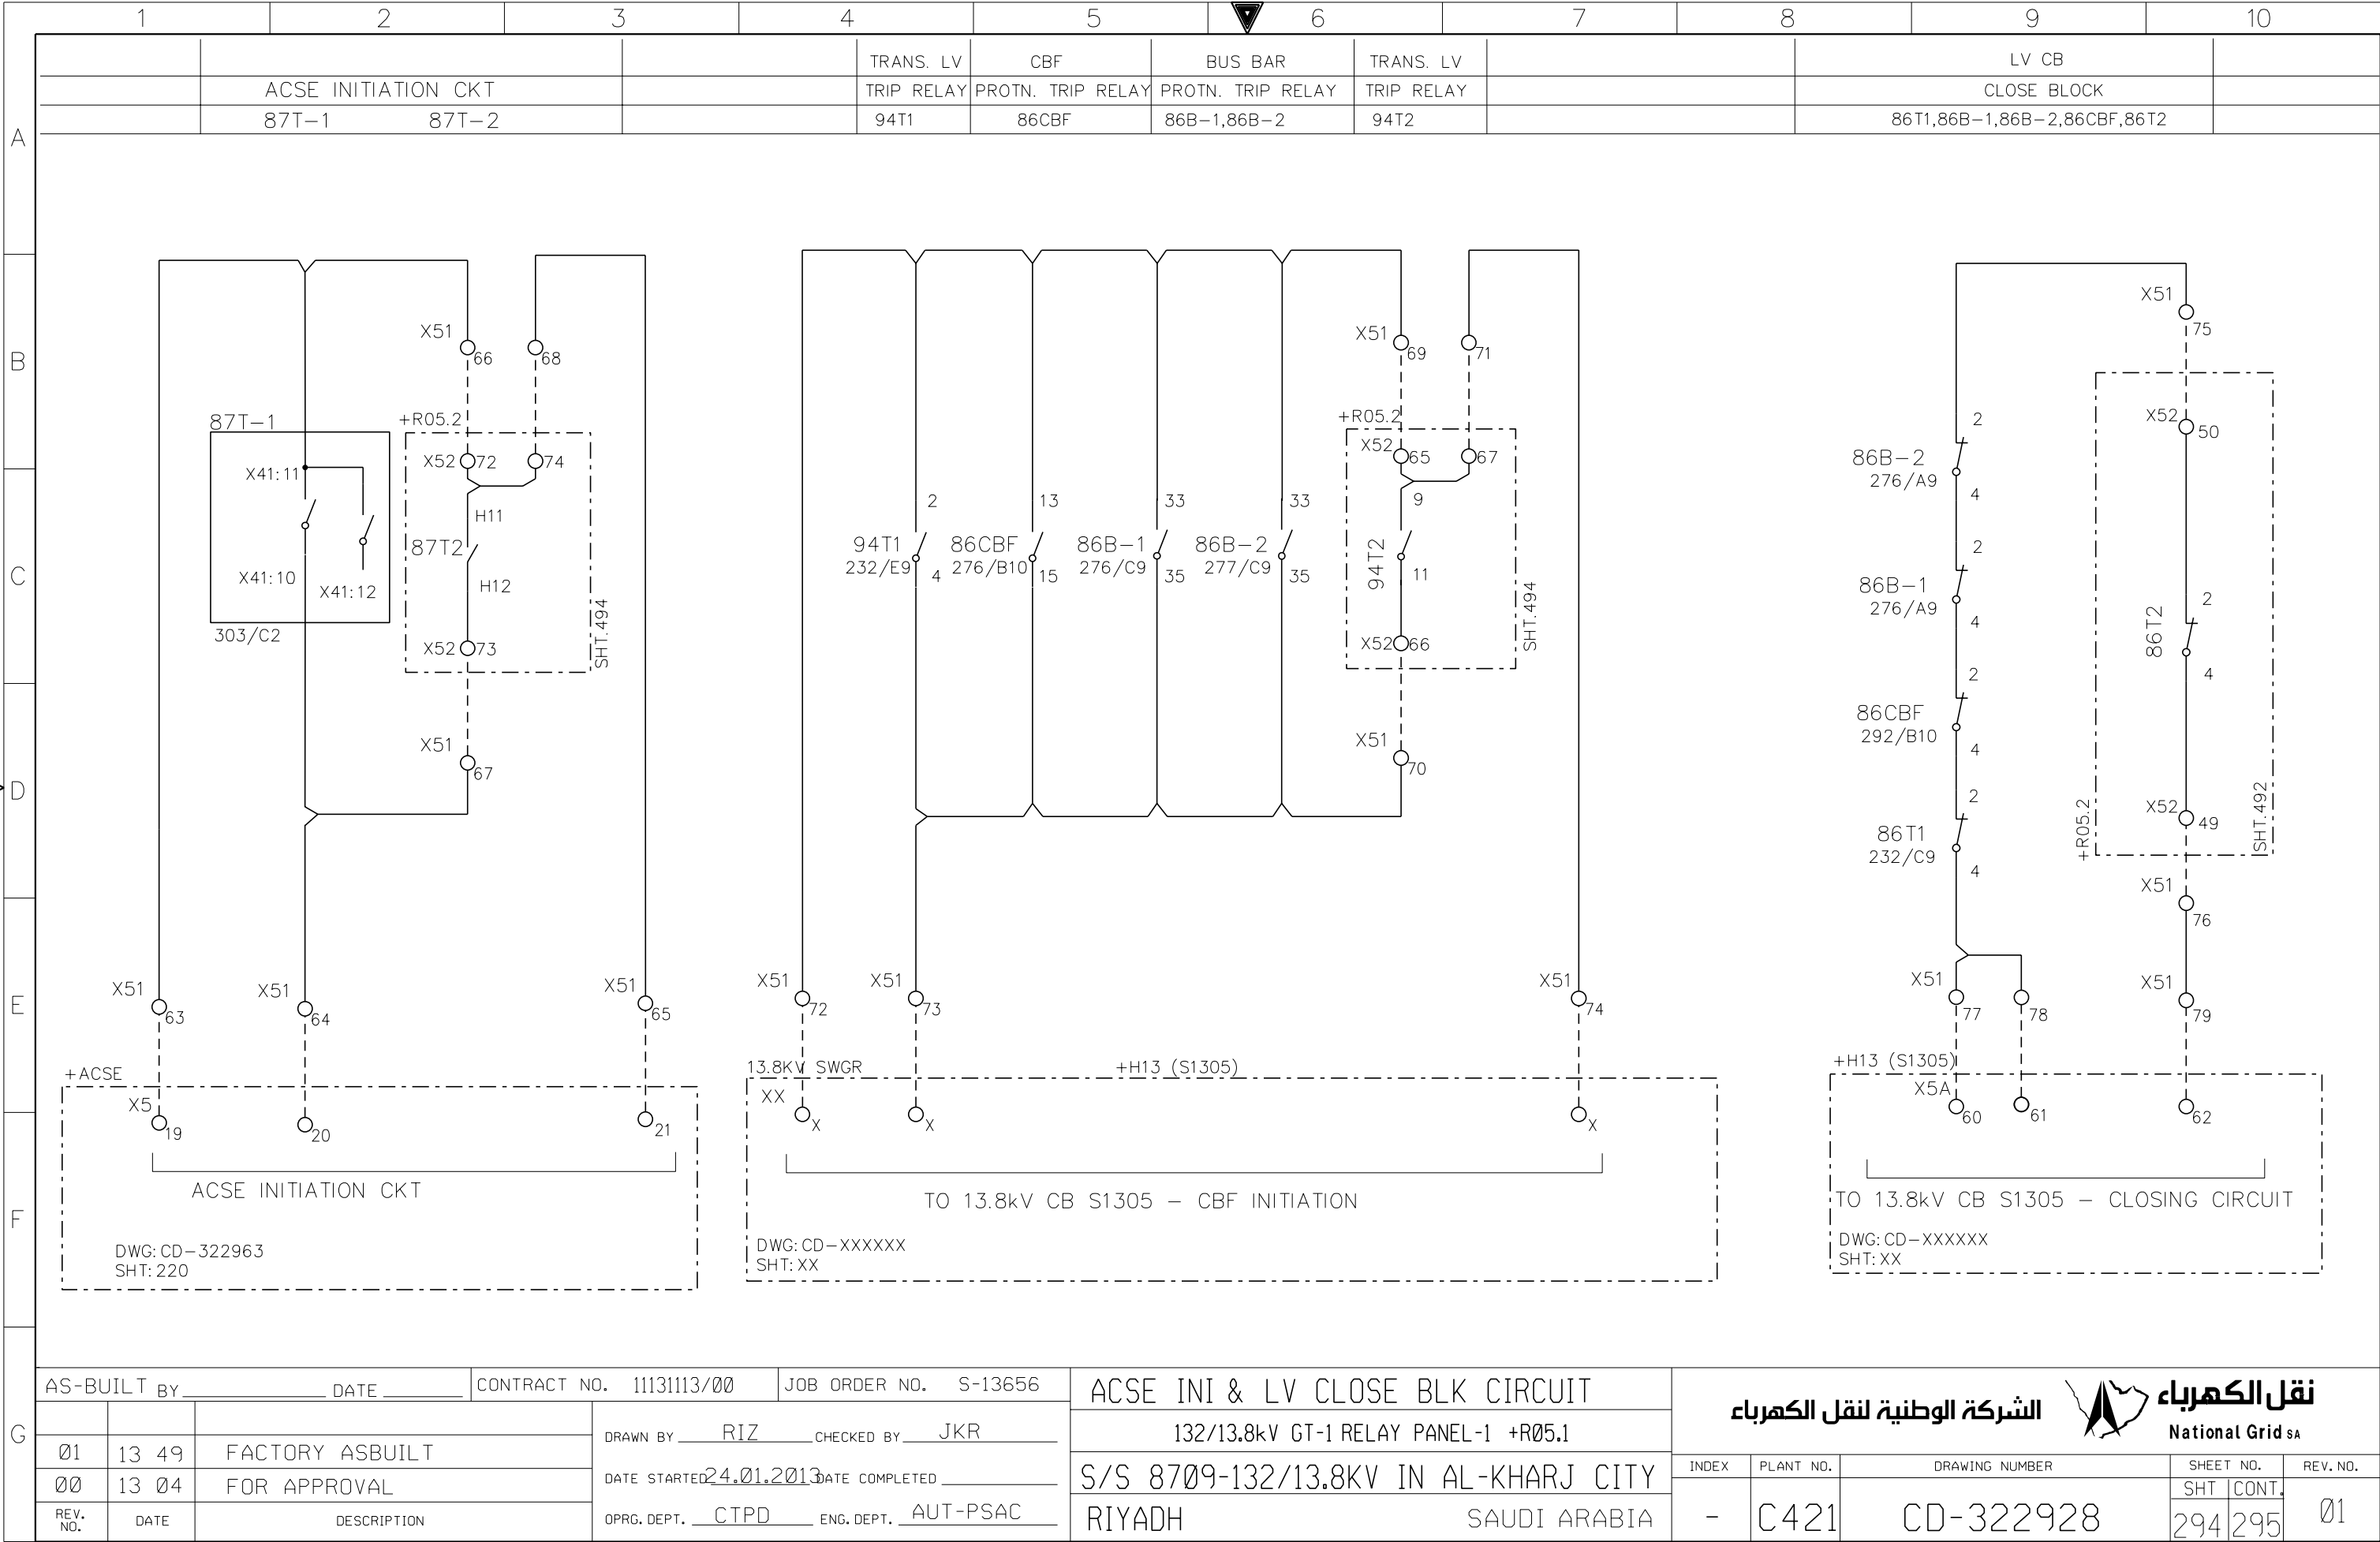
THIS DRAWING AND THE INFORMATION CONTAINED HEREIN ARE THE SOLE PROPERTY OF National Grid SA NO REPRODUCTION IN FULL OR IN PART SHALL BE OBTAINED FROM THIS DOCUMENT WITHOUT THE WRITTEN CONSENT OF ITS OWNER.

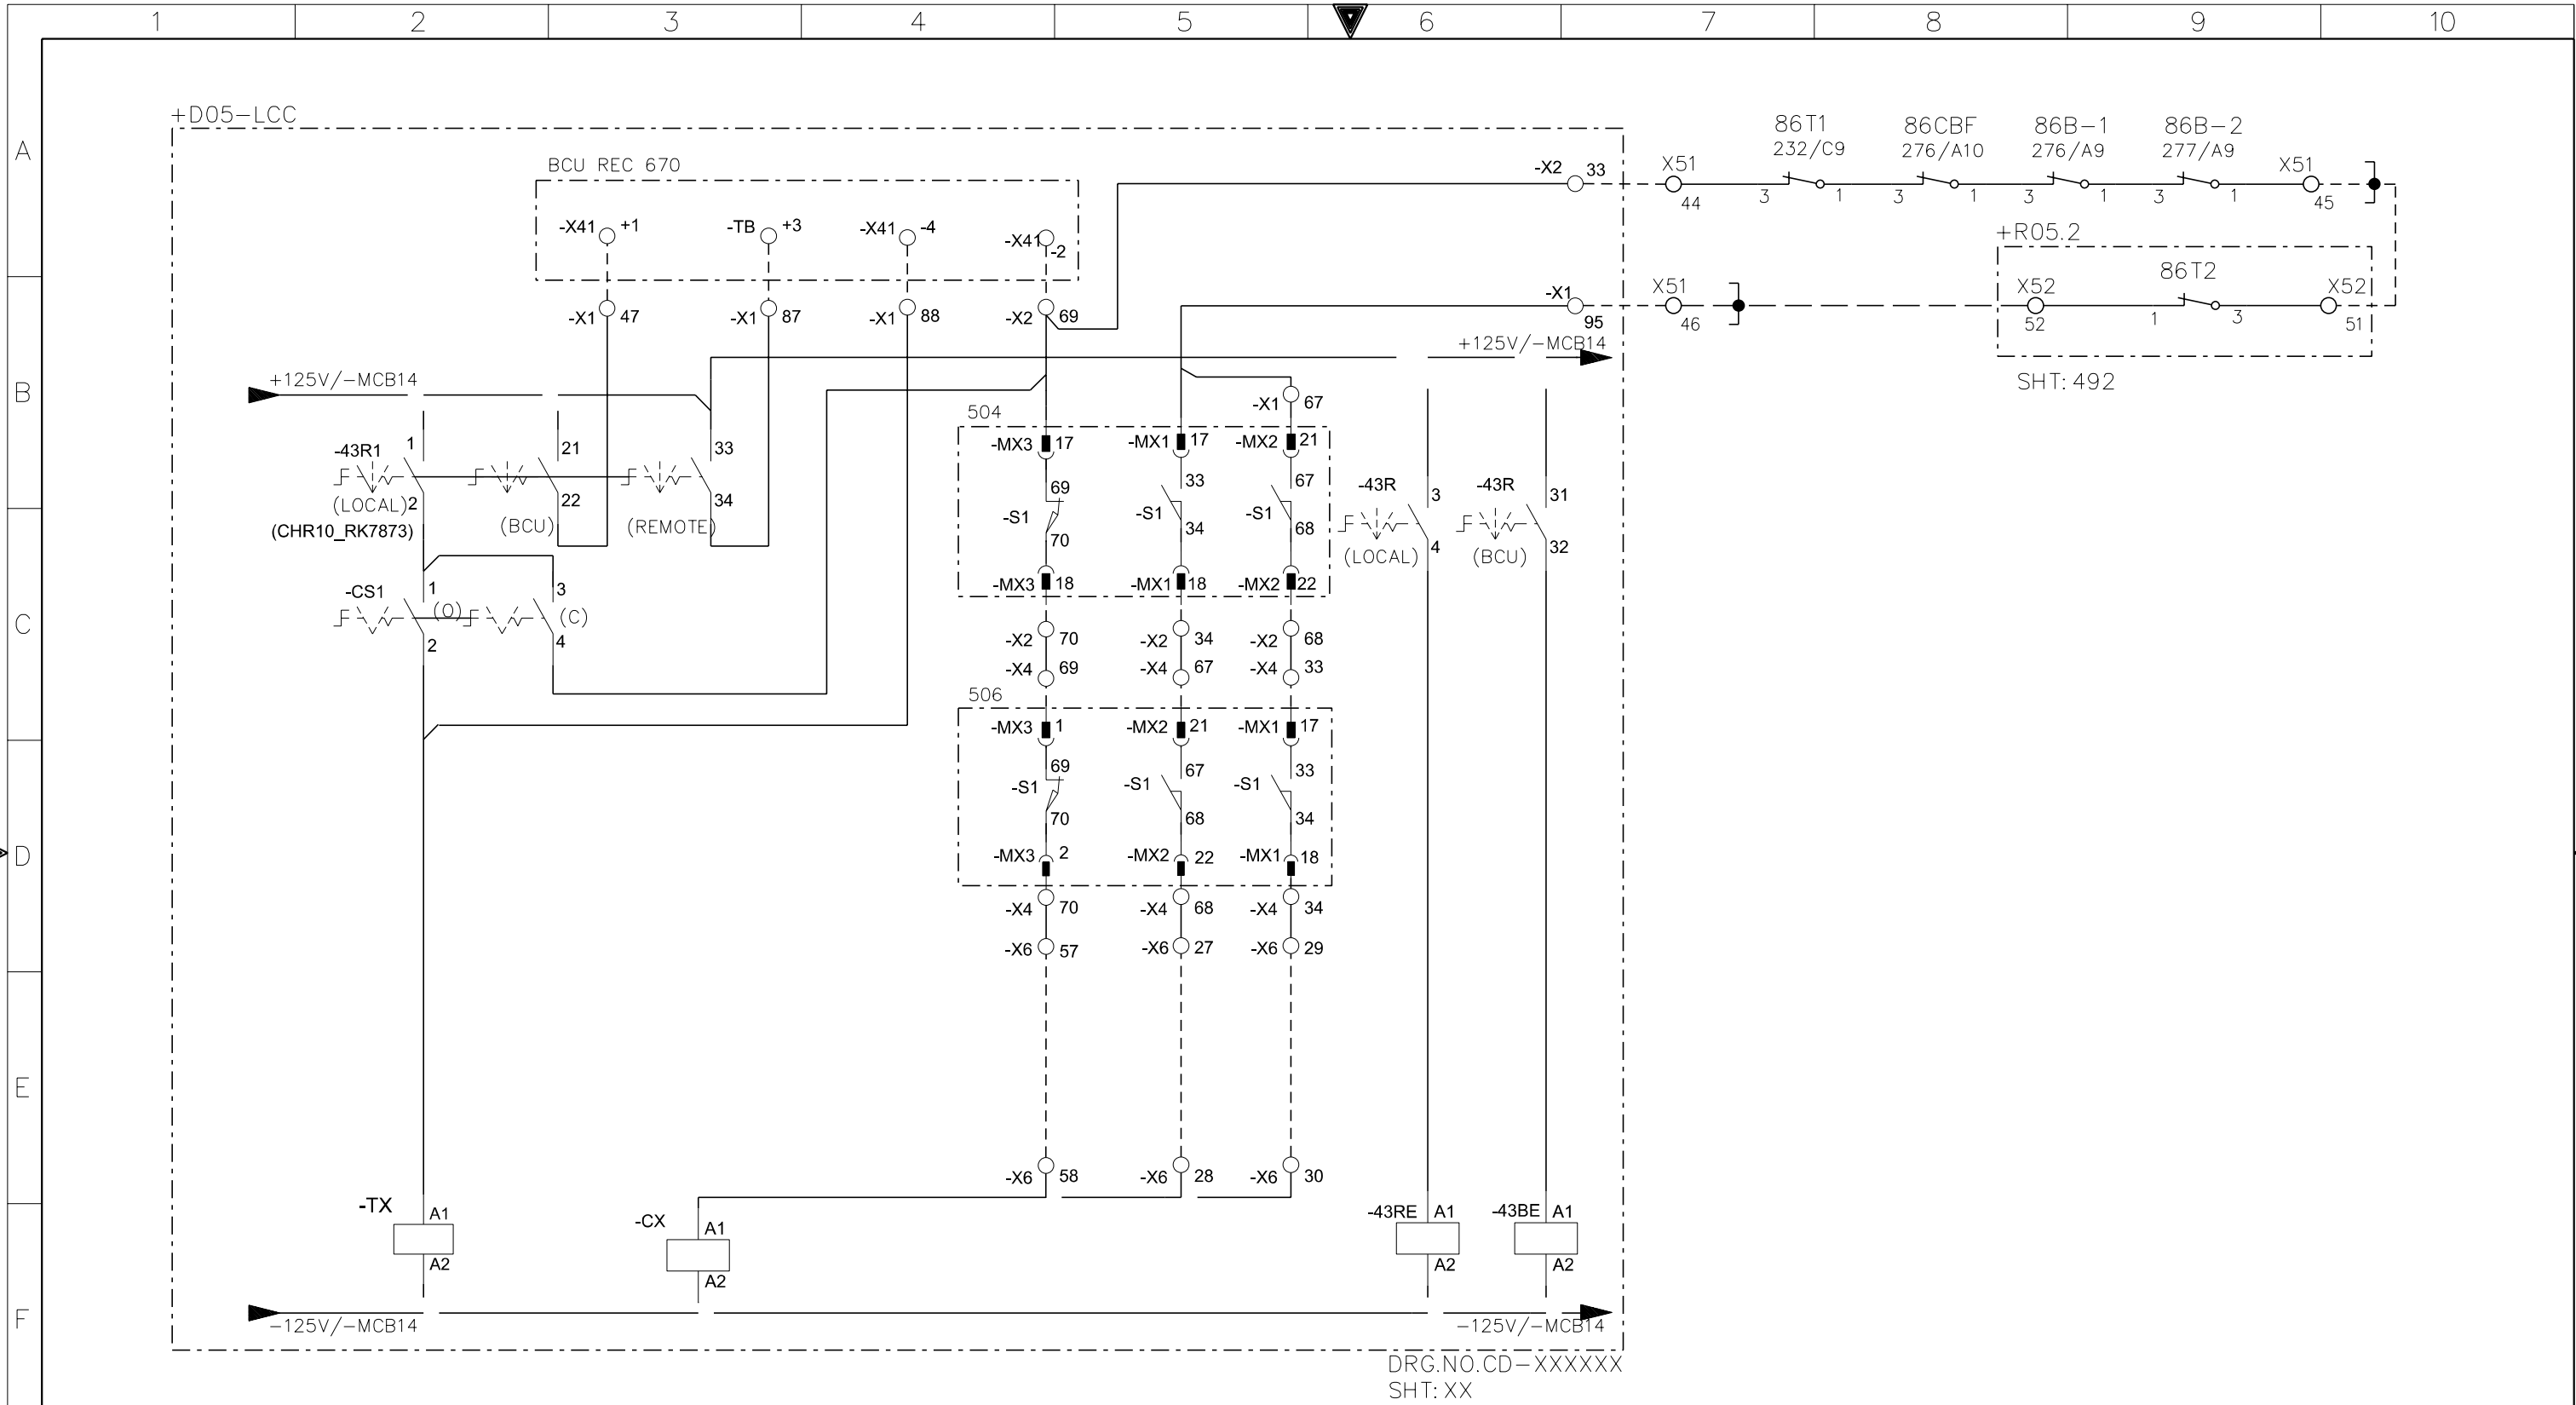


G	AS-BUILT BY _____ DATE _____		CONTRACT NO. 11131113/00		JOB ORDER NO. S-13656		CB K305 CLOSE BLOCK CIRCUIT		<div>الشركة الوطنية لنقل الكهرباء</div> <div>نقل الكهرباء National Grid SA</div>				
				DRAWN BY <u>RIZ</u> CHECKED BY <u>JKR</u>	132/13.8kV GT-1 RELAY PANEL-1 +R05.1								
	01	13 49	FACTORY ASBUILT	DATE STARTED <u>24.01.2013</u> DATE COMPLETED _____		S/S 8709-132/13.8KV IN AL-KHARJ CITY		INDEX	PLANT NO.	DRAWING NUMBER	SHEET NO.	REV. NO.	
	00	13 04	FOR APPROVAL	OPRG. DEPT. <u>CTPD</u> ENG. DEPT. <u>AUT-PSAC</u>		RIYADH SAUDI ARABIA		-	C421	CD-322928	SHT	CONT.	01
	REV. NO.	DATE	DESCRIPTION								292	293	




[illegible]



AS-BUILT BY _____ DATE _____			CONTRACT NO. 11131113/00		JOB ORDER NO. S-13656		ACSE INI & LV CLOSE BLK CIRCUIT		<div>نقل الكهرباء</div> <div>الشركة الوطنية لنقل الكهرباء</div> <div>National Grid sa</div>						
01	13 49	FACTORY ASBUILT	DRAWN BY RIZ		CHECKED BY JKR		132/13.8kv GT-1 RELAY PANEL-1 +R05.1								
00	13 04	FOR APPROVAL	DATE STARTED 24.01.2013		DATE COMPLETED _____		S/S 8709-132/13.8KV IN AL-KHARJ CITY								
REV. NO.	DATE	DESCRIPTION	OPRG. DEPT. CTPD		ENG. DEPT. AUT-PSAC		RIYADH SAUDI ARABIA		INDEX	PLANT NO.	DRAWING NUMBER		SHEET NO.		REV. NO.
									-	C421	CD-322928		SHT 294	CONT. 295	01

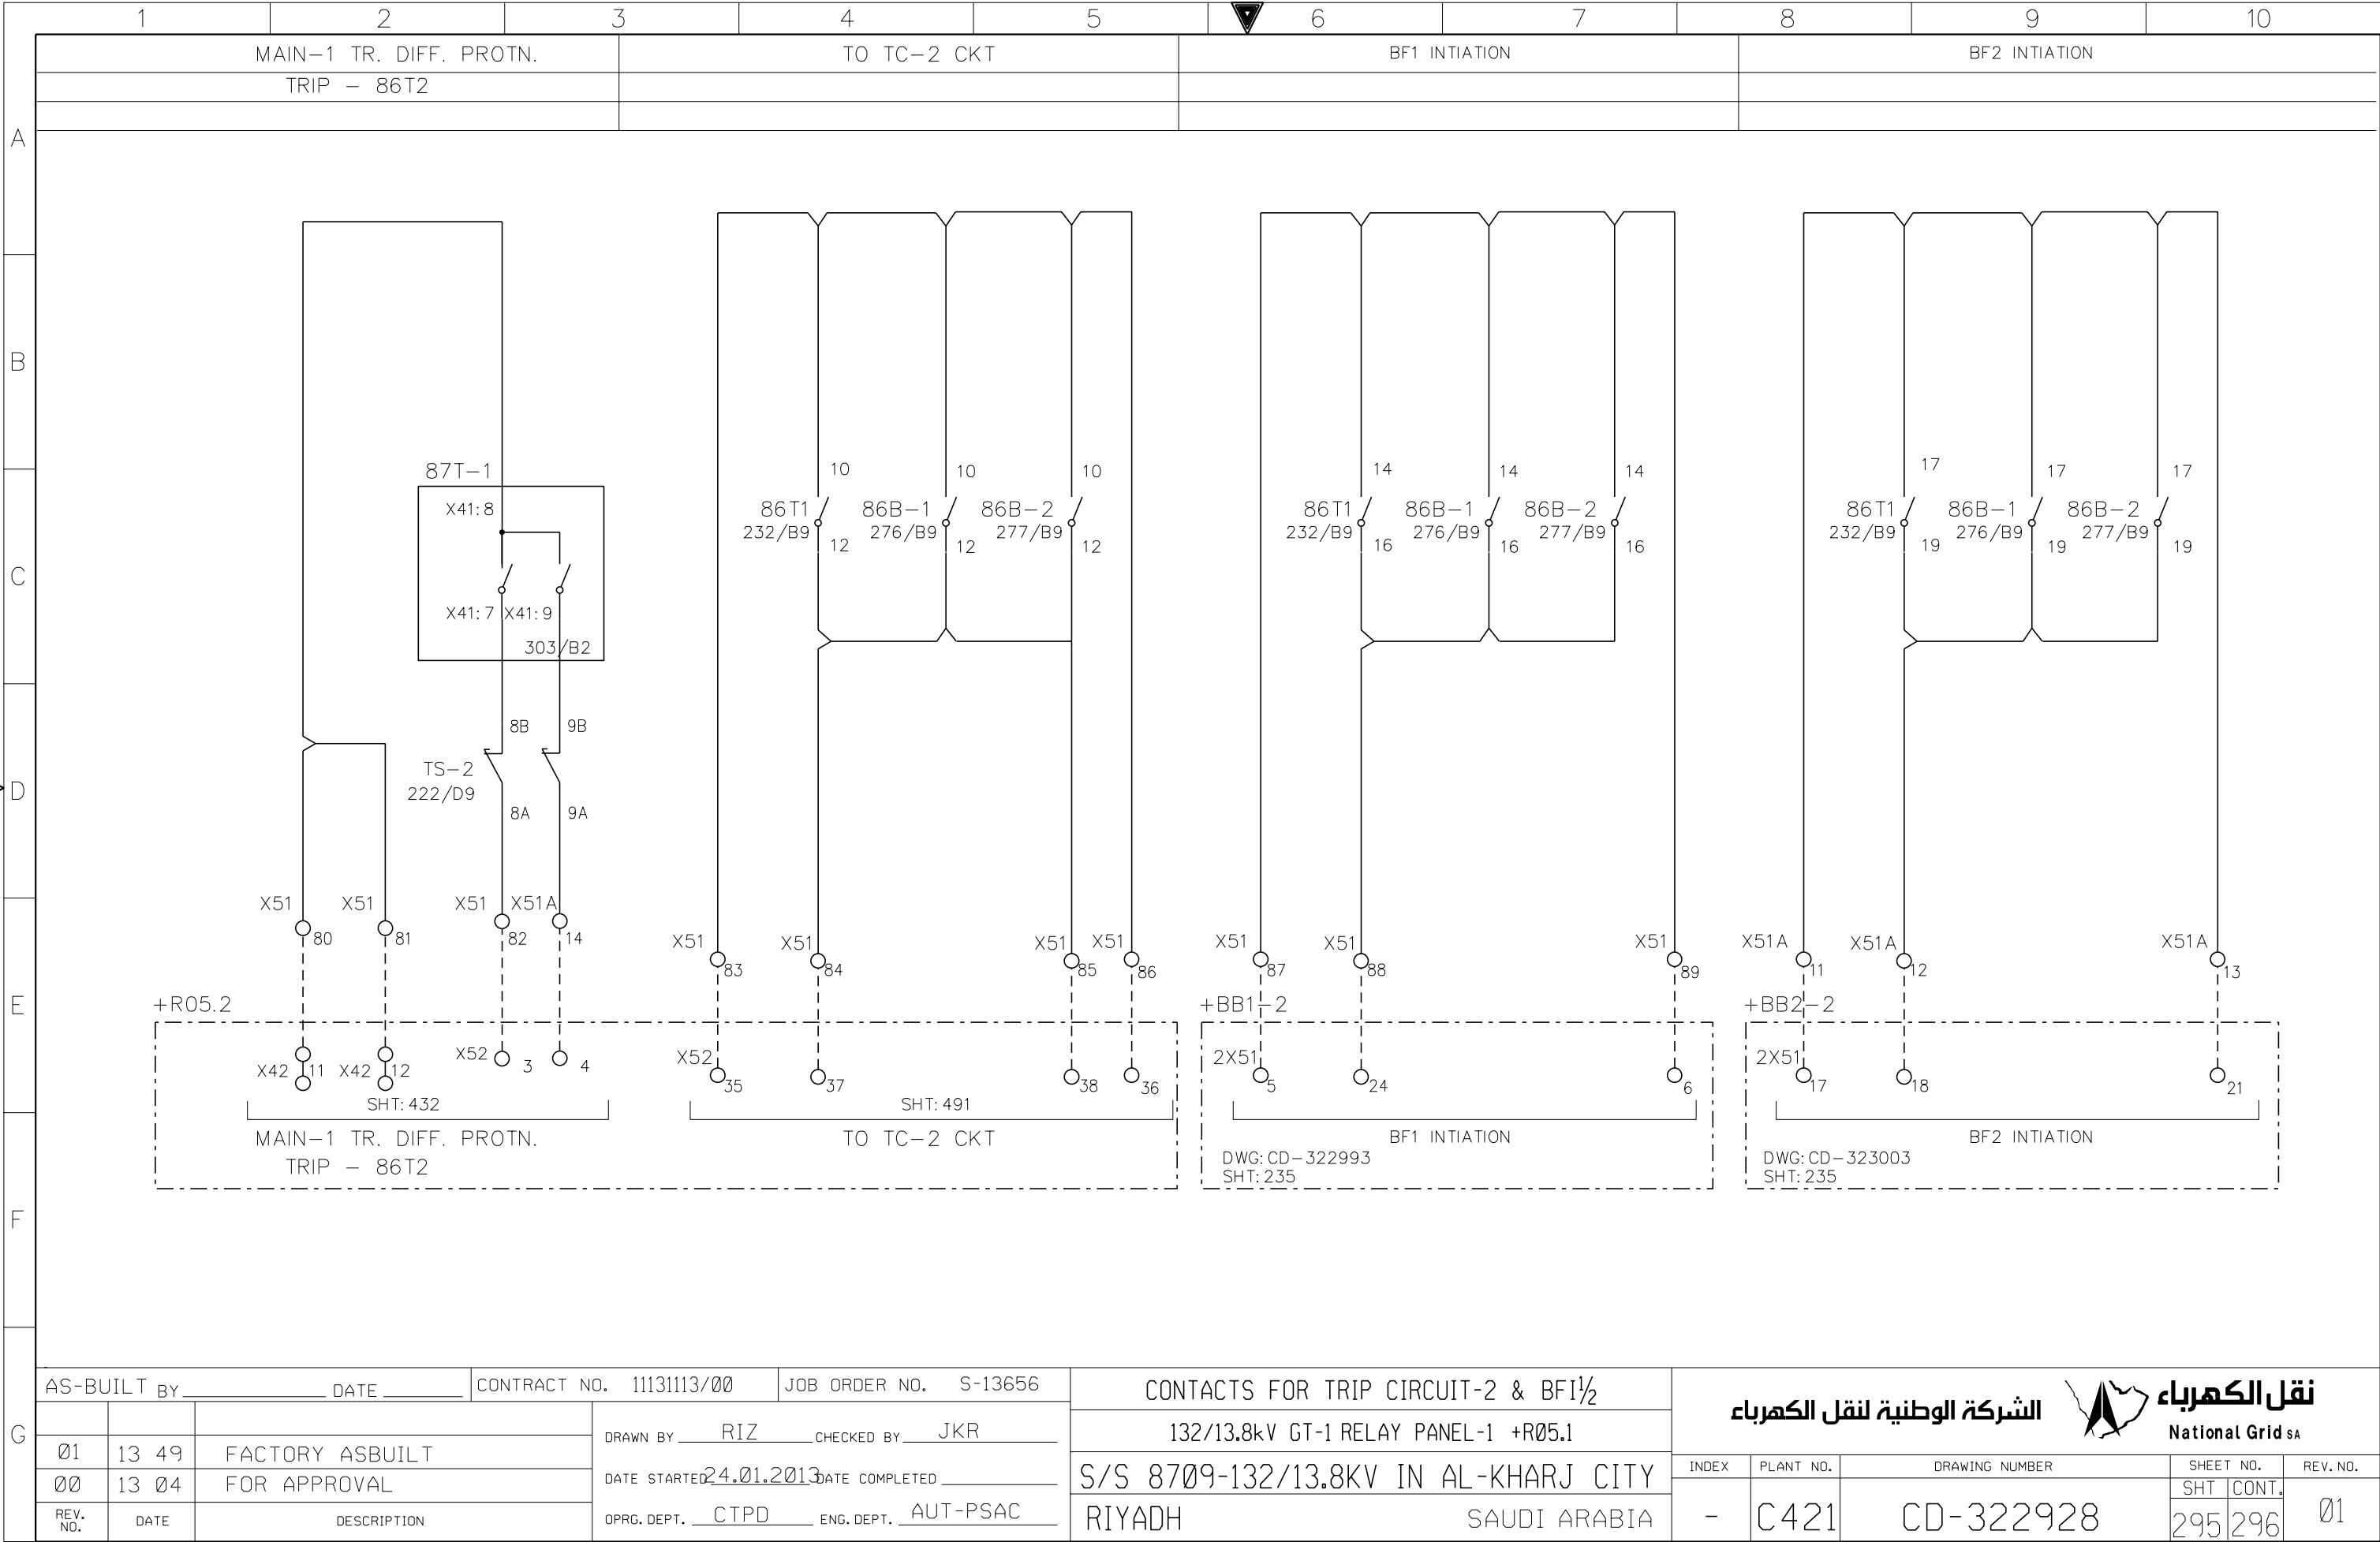

THIS DRAWING AND THE INFORMATION CONTAINED HEREIN ARE THE SOLE PROPERTY OF National Grid SA NO REPRODUCTION IN FULL OR IN PART SHALL BE OBTAINED FROM THIS DOCUMENT WITHOUT THE WRITTEN CONSENT OF ITS OWNER.

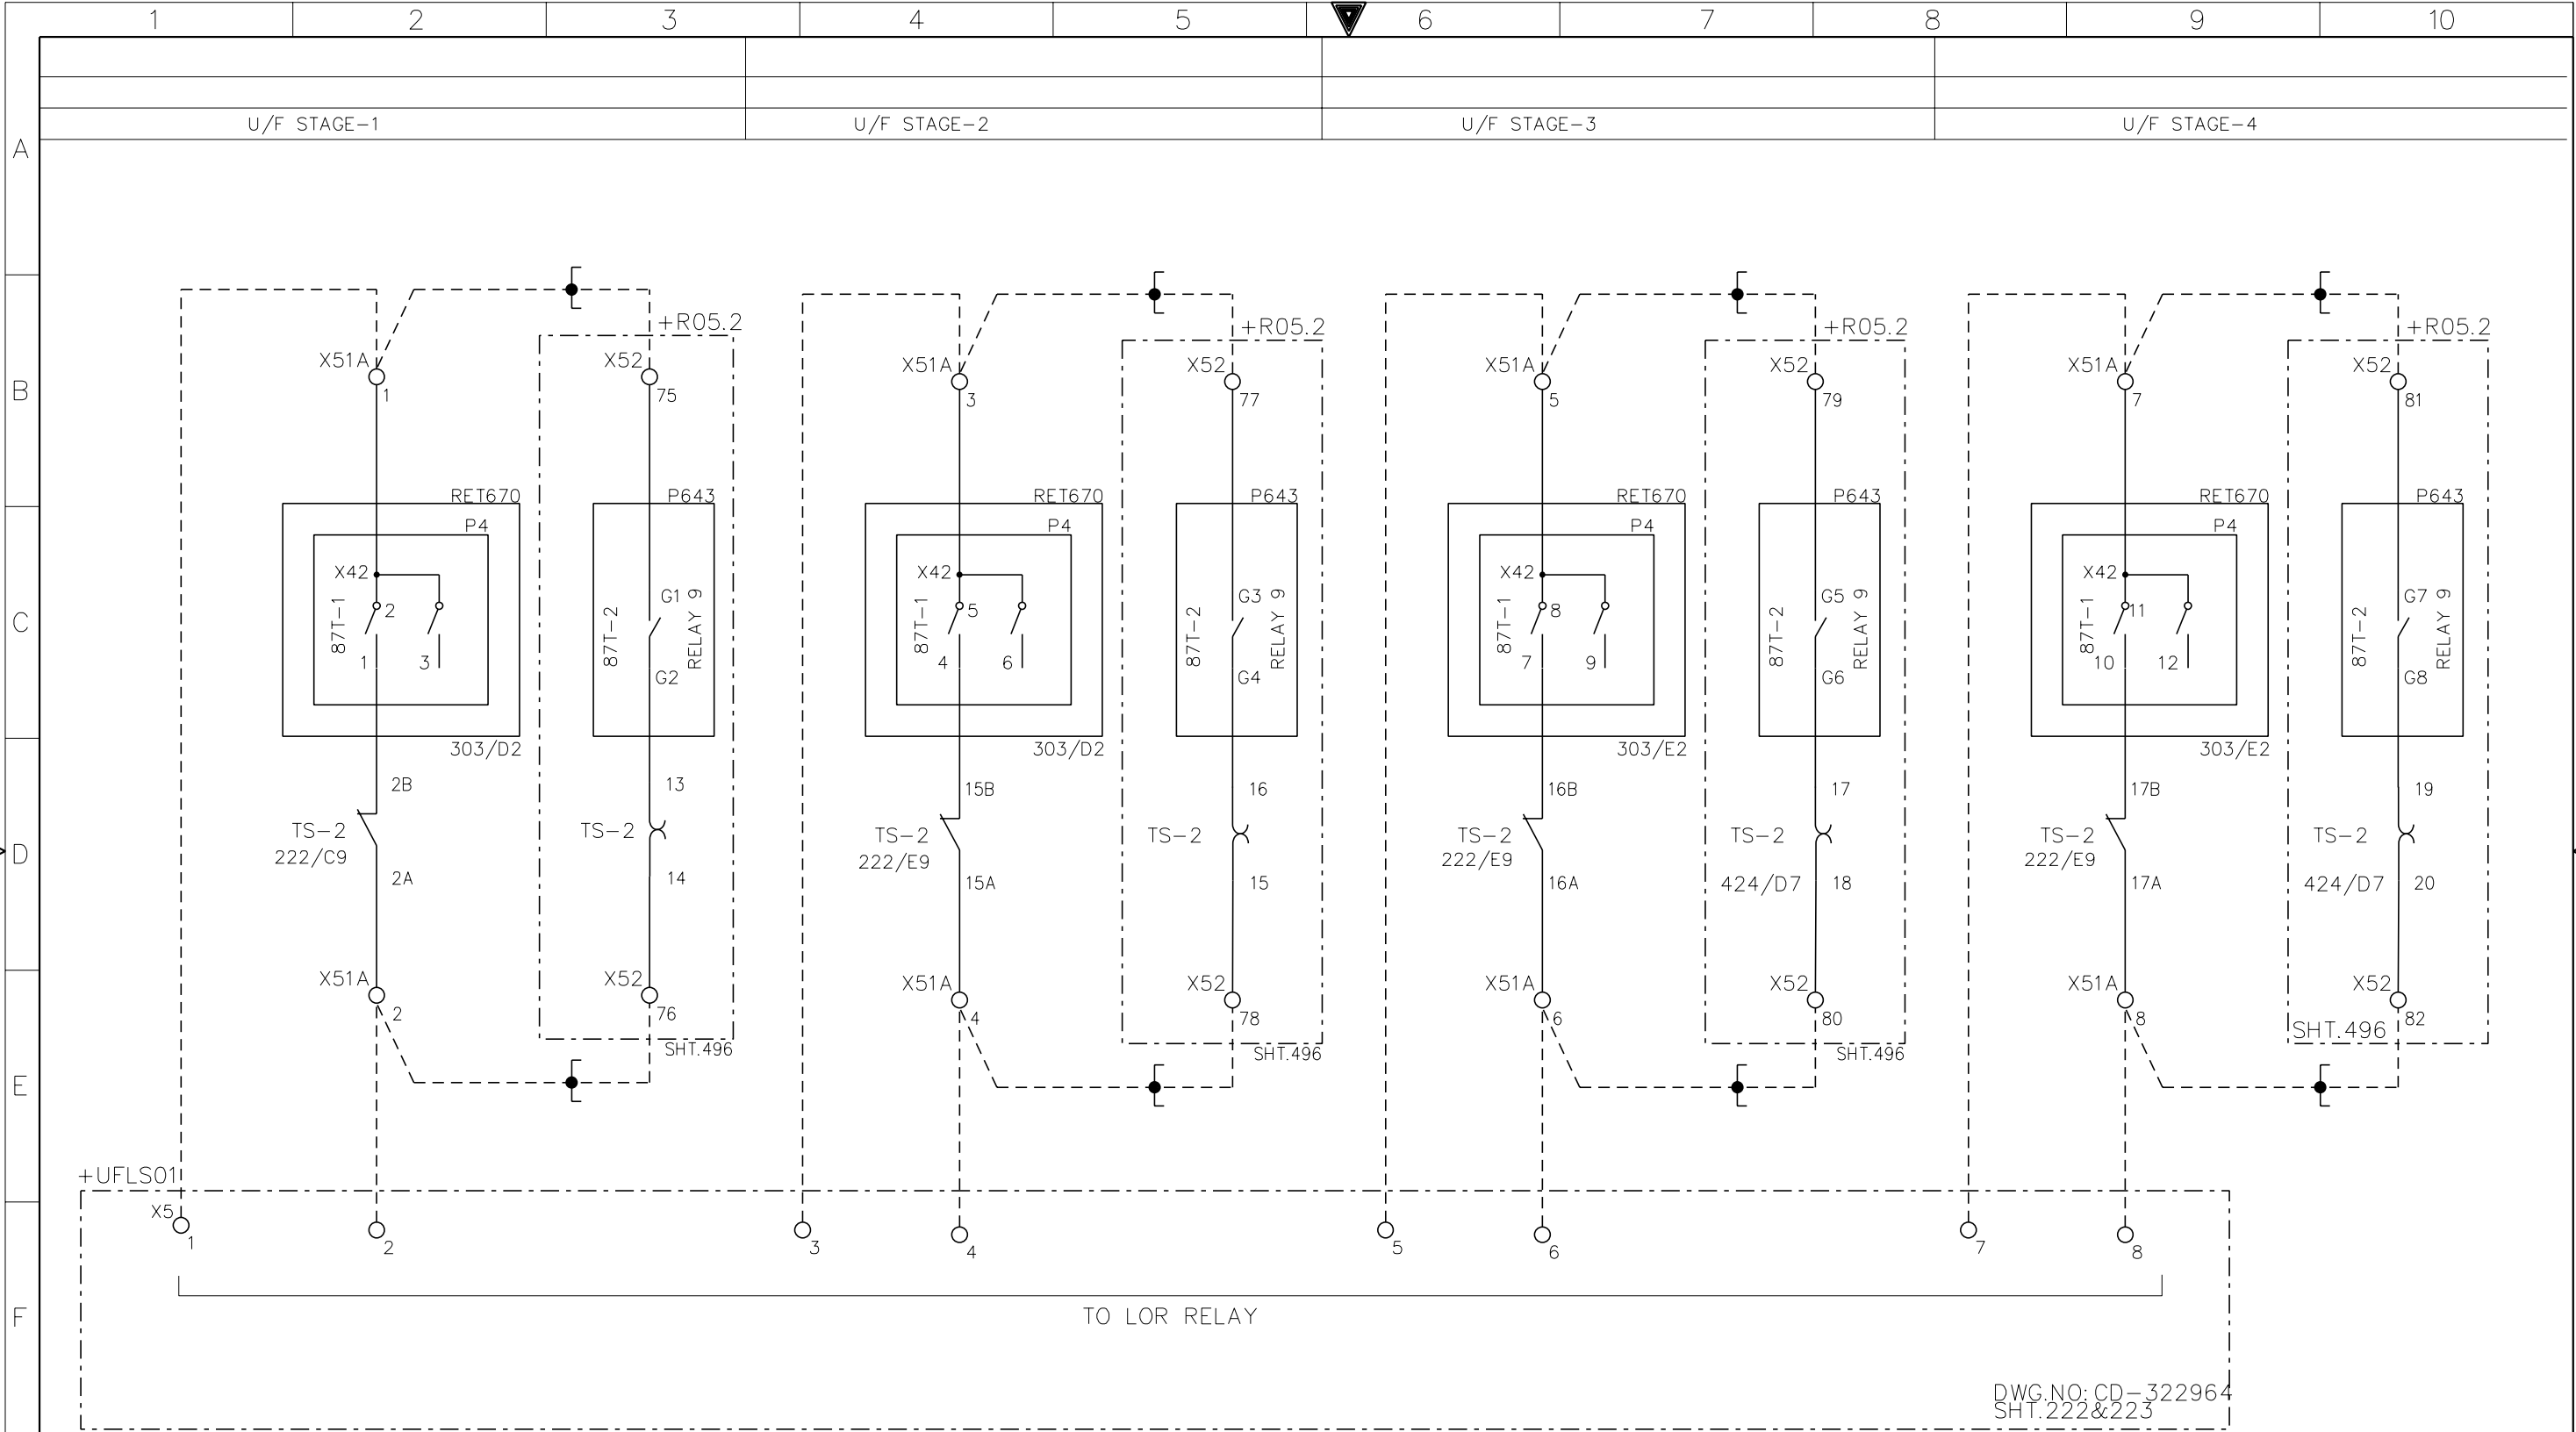


G

AS-BUILT BY _____ DATE _____			CONTRACT NO. 11131113/00		JOB ORDER NO. S-13656	
01	13 49	FACTORY ASBUILT	DRAWN BY RIZ CHECKED BY JKR			
00	13 04	FOR APPROVAL	DATE STARTED 24.01.2013 DATE COMPLETED _____			
REV. NO.	DATE	DESCRIPTION	OPRG. DEPT. CTPD ENG. DEPT. AUT-PSAC			


CONTACTS FOR U/F LOAD SHEDDING					
132/13.8kV GT-1 RELAY PANEL-1 +R05.1					
S/S 8709-132/13.8KV IN AL-KHARJ CITY					
RIYADH SAUDI ARABIA					

الشركة الوطنية لنقل الكهرباء



National Grid SA

INDEX	PLANT NO.	DRAWING NUMBER	SHEET NO.		REV. NO.
-	C421	CD-322928	SHT 296	CONT. 298	01

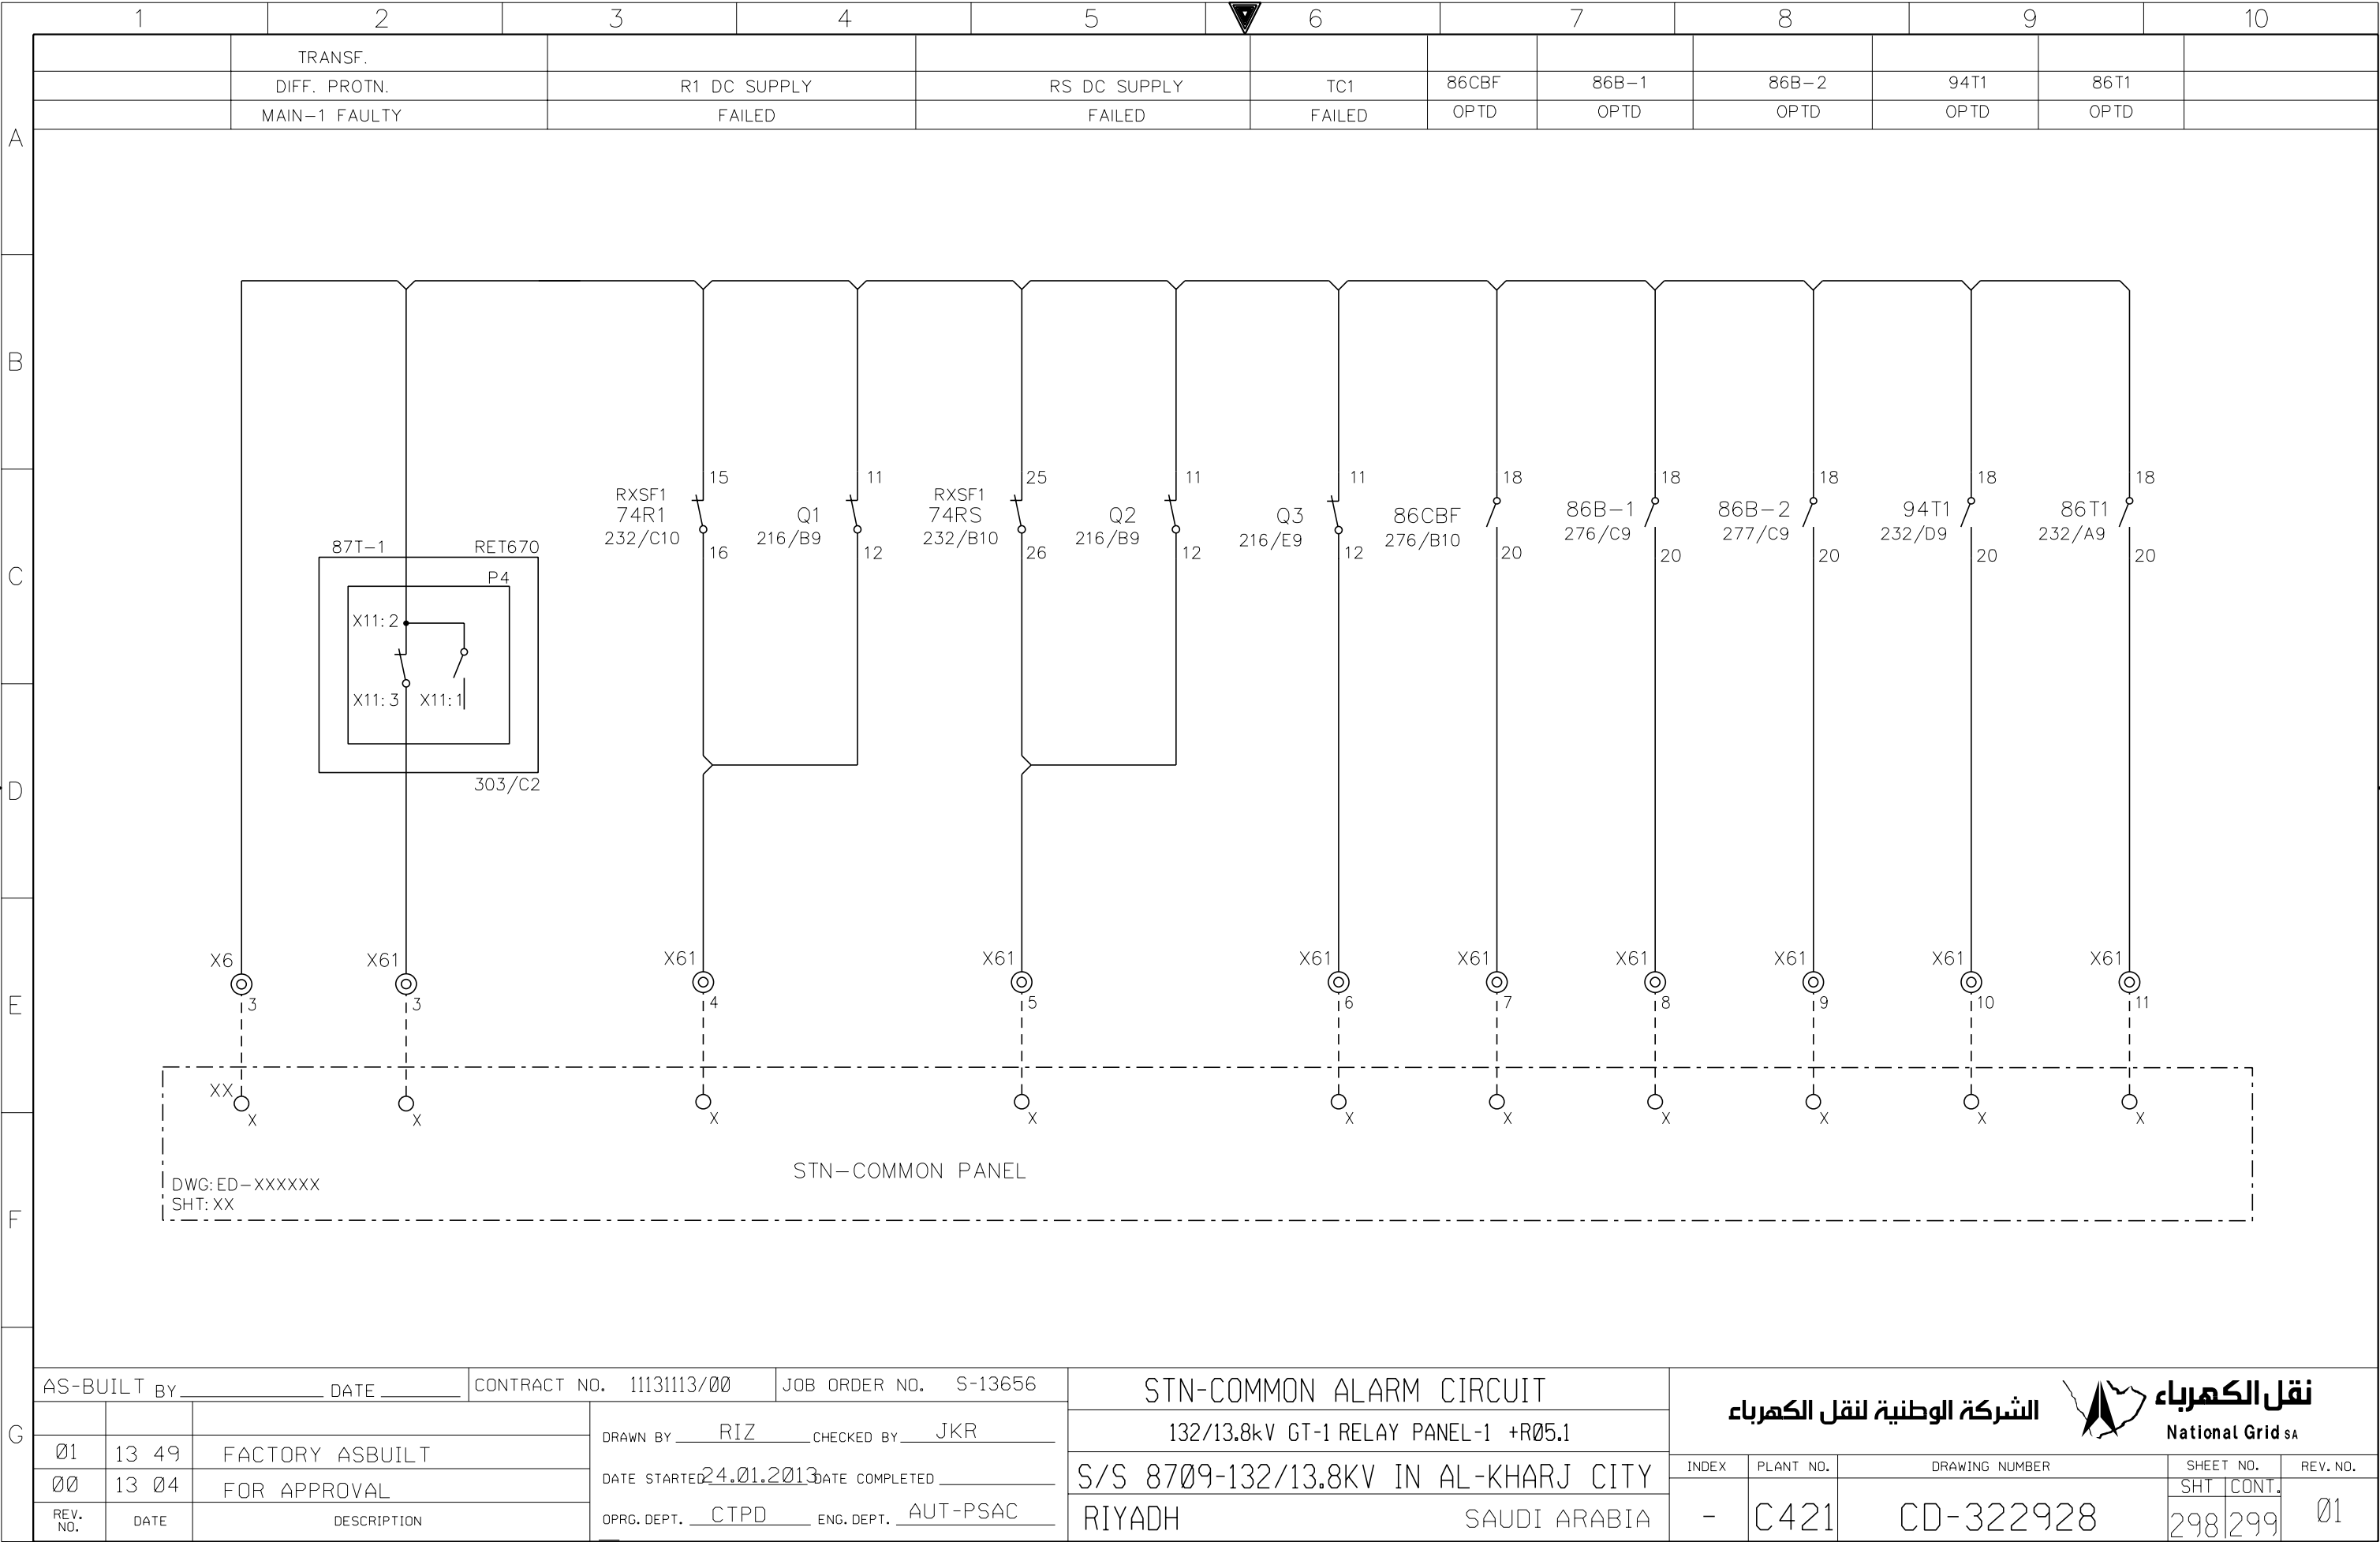


G

AS-BUILT BY _____ DATE _____			CONTRACT NO. 11131113/00		JOB ORDER NO. S-13656	
01	13 49	FACTORY ASBUILT	DRAWN BY RIZ CHECKED BY JKR			
00	13 04	FOR APPROVAL	DATE STARTED 24.01.2013 DATE COMPLETED _____			
REV. NO.	DATE	DESCRIPTION	OPRG. DEPT. CTPD ENG. DEPT. AUT-PSAC			


STN-COMMON ALARM CIRCUIT					
132/13.8kV GT-1 RELAY PANEL-1 +R05.1					
S/S 8709-132/13.8KV IN AL-KHARJ CITY					
RIYADH SAUDI ARABIA					

الشركة الوطنية لنقل الكهرباء

نقل الكهرباء

National Grid SA

INDEX	PLANT NO.	DRAWING NUMBER	SHEET NO.		REV. NO.
-	C421	CD-322928	SHT 298	CONT. 299	01

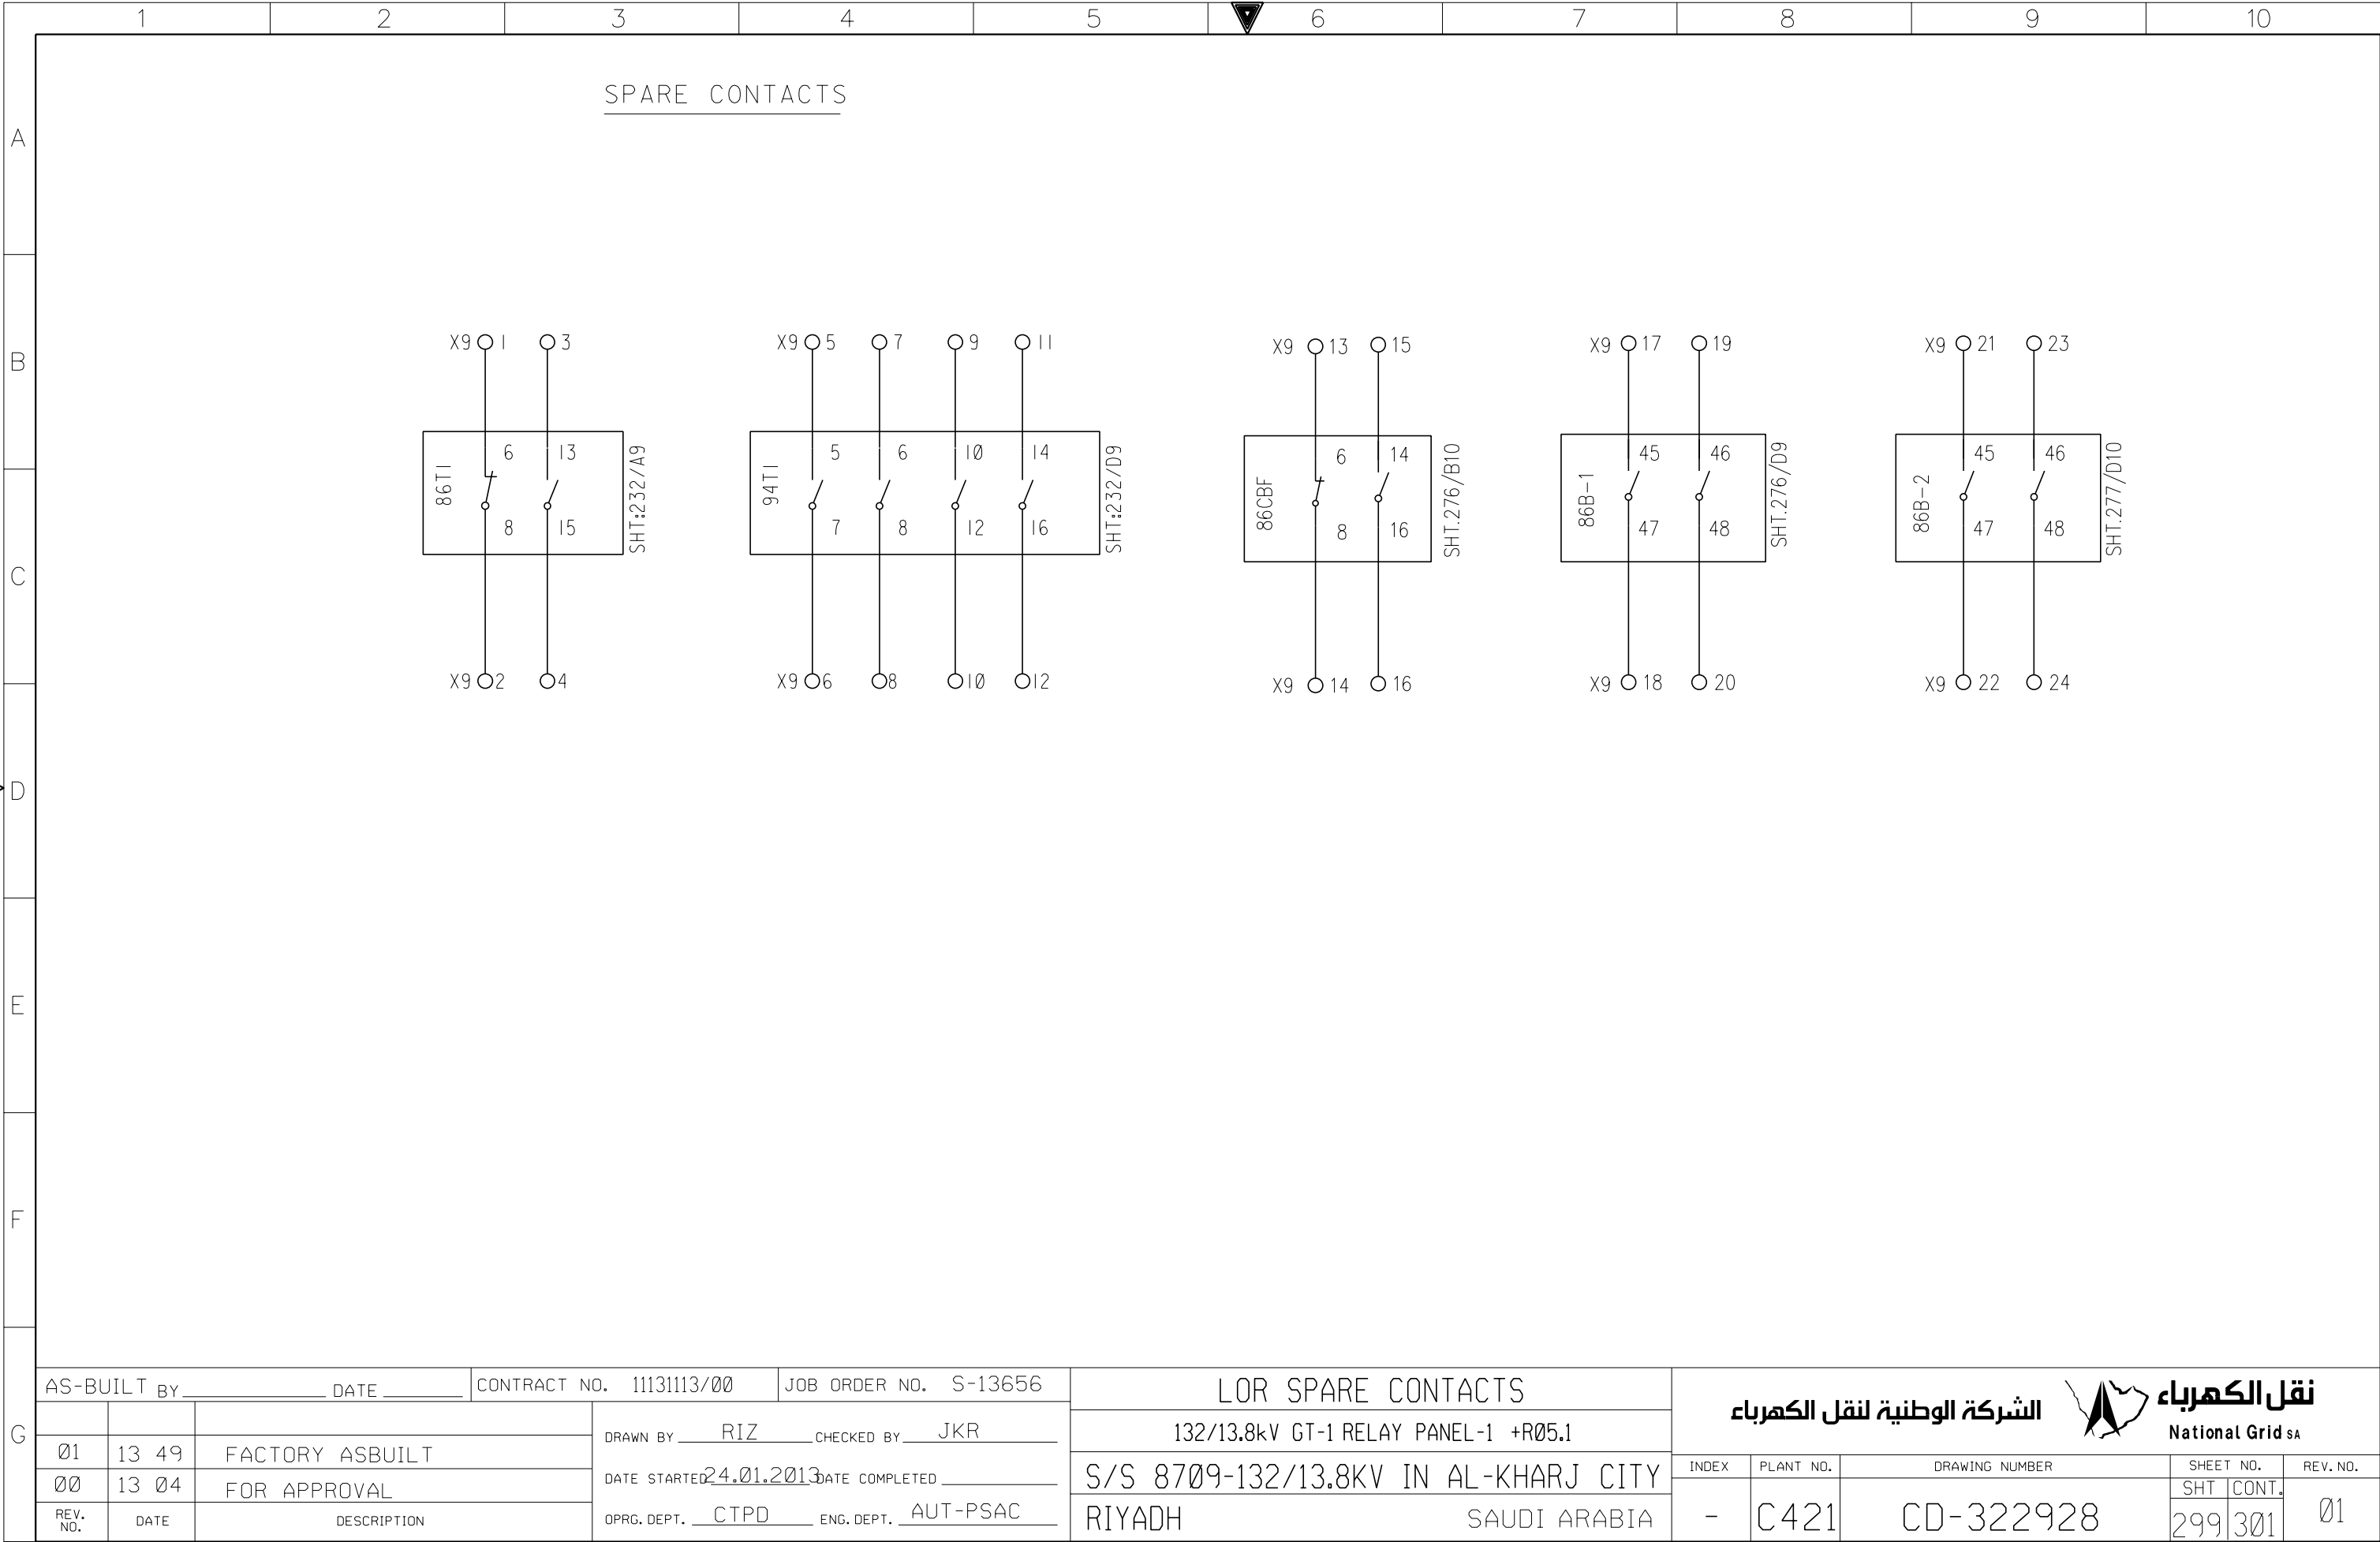

AS-BUILT BY

DATE

CONTRACT NO.

11131113/00

JOB ORDER NO.

S-13656

01

13 49

FACTORY ASBUILT

00

13 04

FOR APPROVAL

REV. NO.

DATE

DESCRIPTION

DRAWN BY

RIZ

CHECKED BY

JKR

DATE STARTED

24.01.2013

DATE COMPLETED

OPRG. DEPT.

CTPD

ENG. DEPT.

AUT-PSAC

LOR SPARE CONTACTS

132/13.8kV GT-1 RELAY PANEL-1 +R05.1

S/S 8709-132/13.8KV IN AL-KHARJ CITY

RIYADH SAUDI ARABIA

الشركة الوطنية لنقل الكهرباء

National Grid sa

INDEX

PLANT NO.

DRAWING NUMBER

SHEET NO.

REV. NO.

-

C421

CD-322928

299/301


01

NG/D2-D (2012/01)

DMS

VECTOR

NGD200

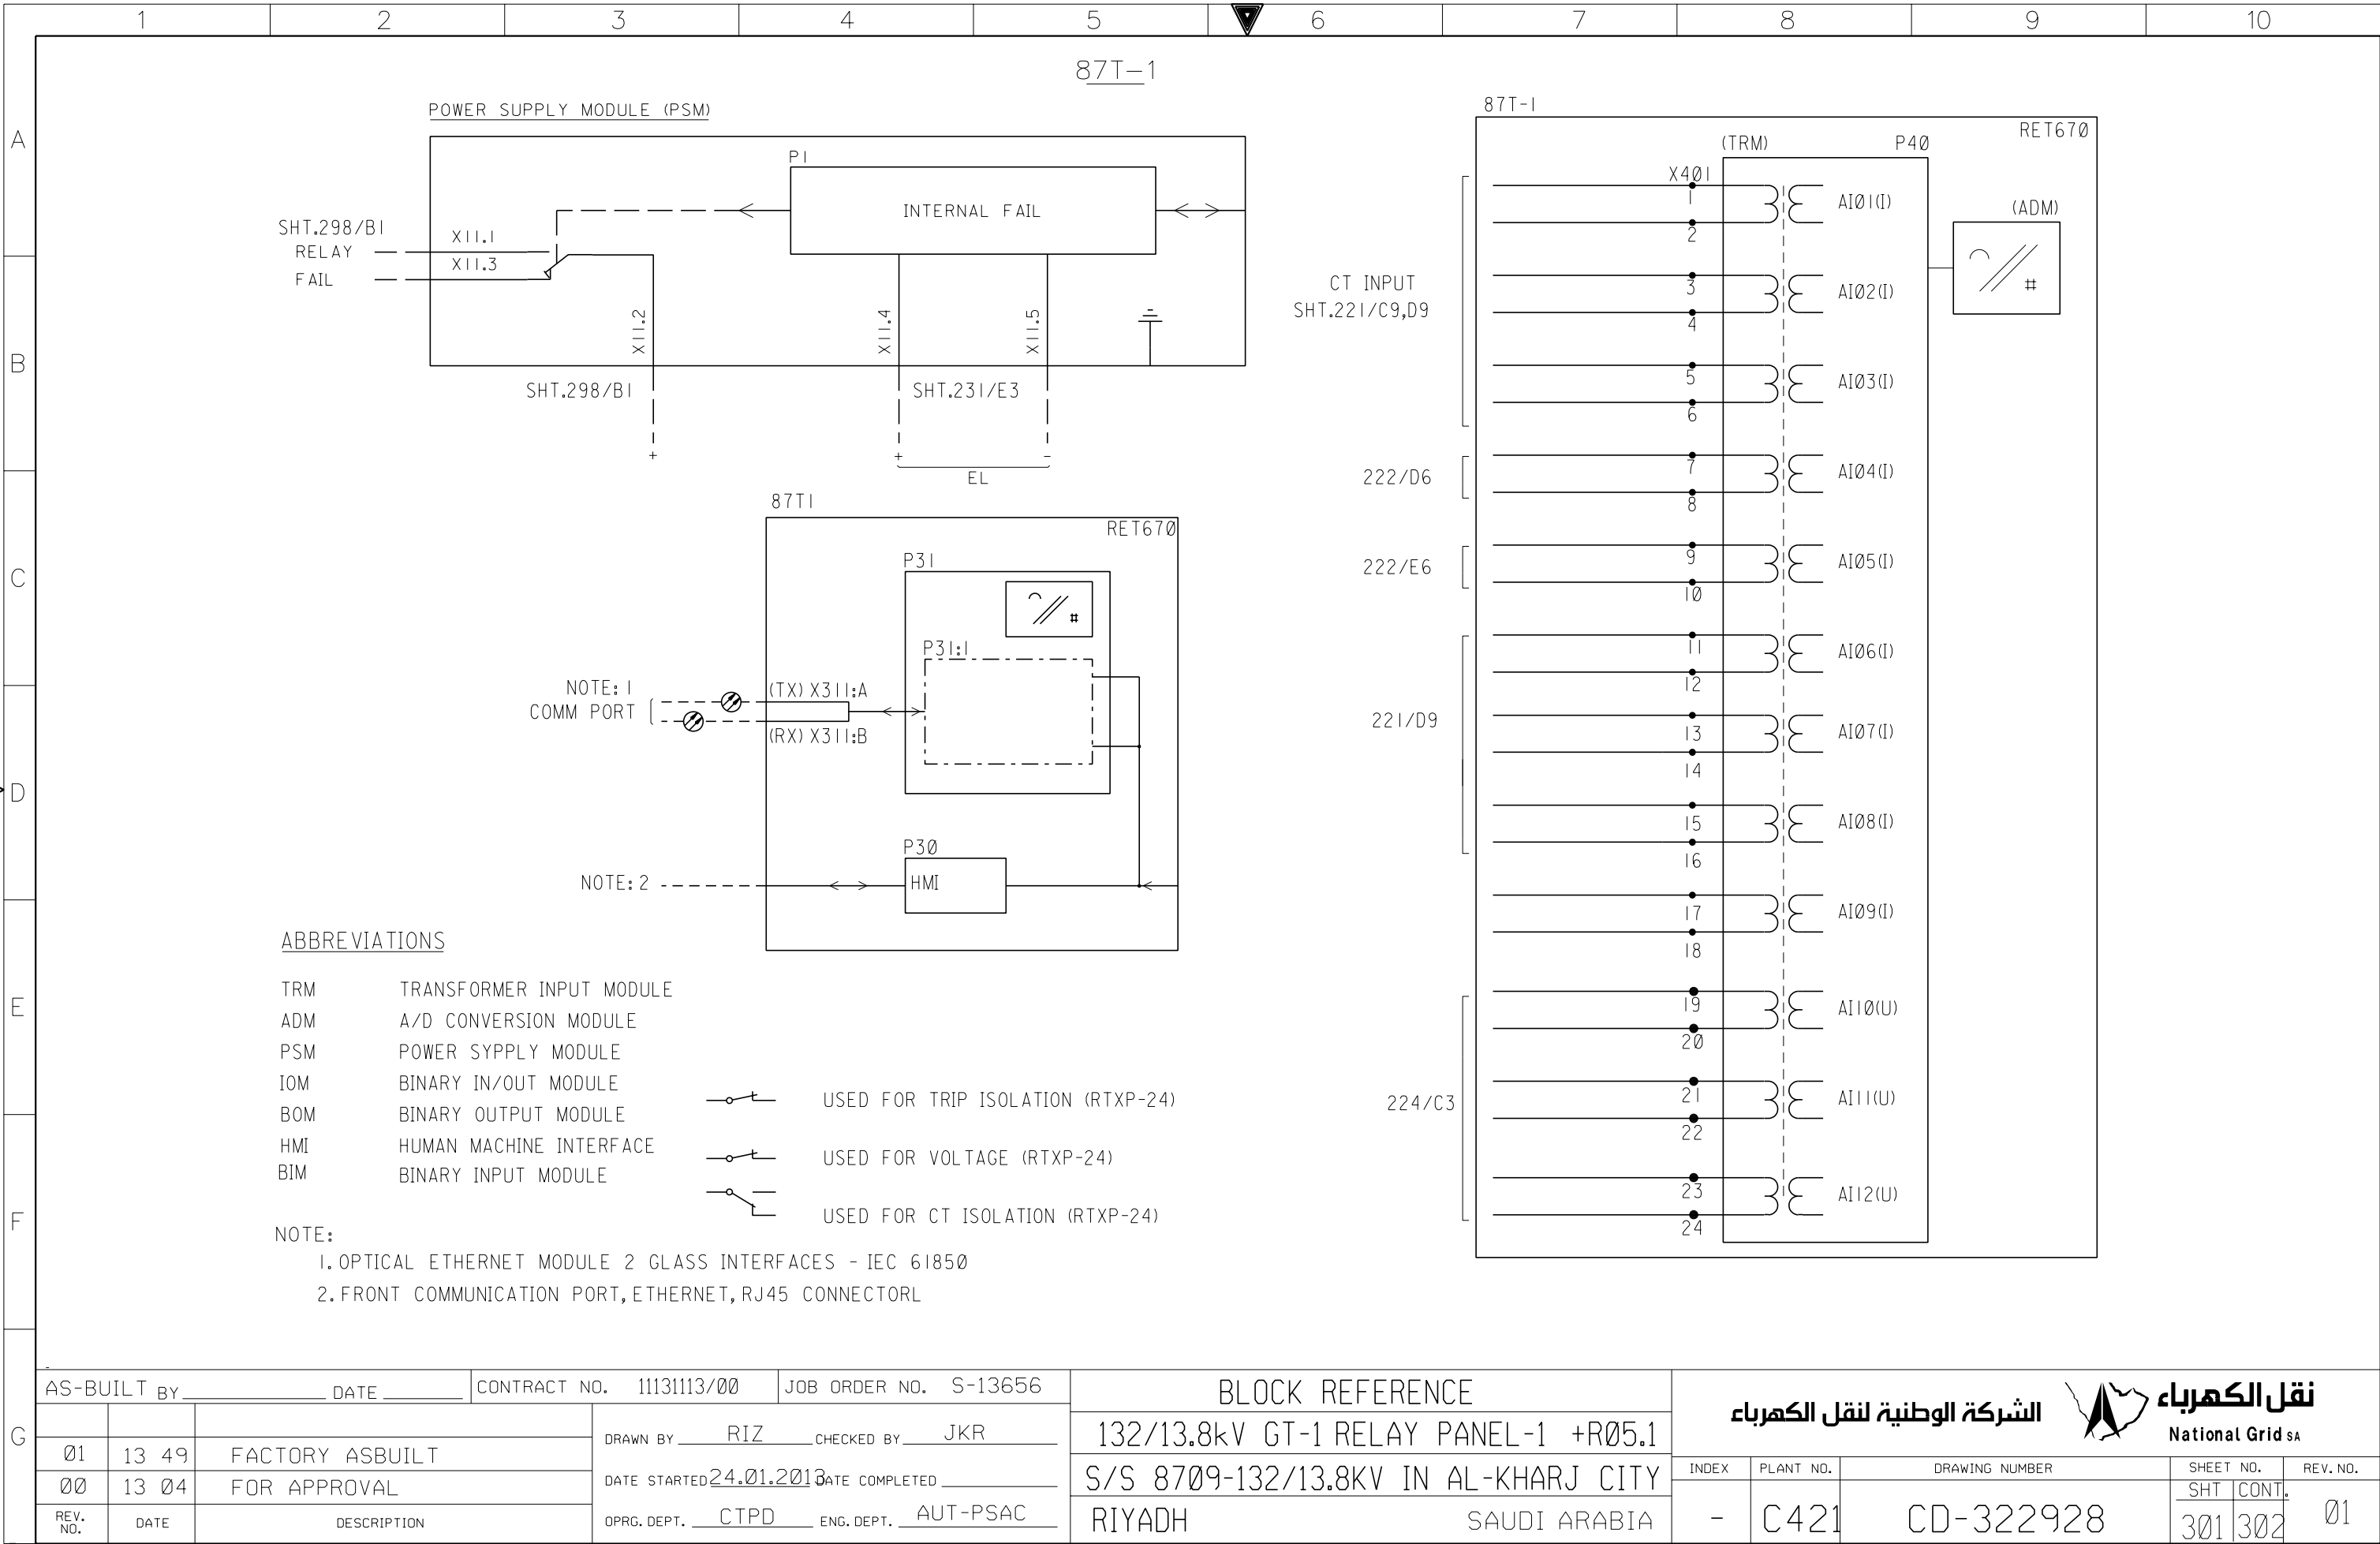

	1	2	3	4	5	6	7	8	9	10
A										
B										
C										
D										
E										
F										
G										
AS-BUILT BY _____ DATE _____		CONTRACT NO. 11131113/00		JOB ORDER NO. S-13656		BLOCK REFERENCE		الشركة الوطنية لنقل الكهرباء		نقل الكهرباء
01 13 49		FACTORY ASBUILT		DRAWN BY RIZ CHECKED BY JKR		132/13.8kV GT-1 RELAY PANEL-1 +R05.1		INDEX		PLANT NO.
00 13 04		FOR APPROVAL		DATE STARTED 24.01.2013 DATE COMPLETED _____		S/S 8709-132/13.8KV IN AL-KHARJ CITY		DRAWING NUMBER		SHEET NO.
REV. NO.		DATE		DESCRIPTION		OPRG. DEPT. CTPD ENG. DEPT. AUT-PSAC		- C421		CD-322928
						RIYADH SAUDI ARABIA		302 303		01

BINARY INPUT CARD


87T-1		BIM P3	
		RET670	
		LOCATION=P3	
		PLANT ADAPTED CONFIGURATION	
SHT.227/E3	+ ---	X31	
	- ---	1	BI.01 // VT MCB FAIL
	+ ---	2	BI.02 // SPARE
	- ---	3	BI.03 // SPARE
	+ ---	4	BI.04 // SPARE
	- ---	5	BI.05 // SPARE
	+ ---	6	BI.06 // SPARE
	- ---	7	BI.07 // CBF I INITIATION
	+ ---	8	BI.08 // SPARE
	- ---	9	BI.09 // SPARE
	+ ---	10	BI.10 // SPARE
	- ---	11	BI.11 // SPARE
	+ ---	12	BI.12 // SPARE
	- ---	13	BI.13 // SPARE
	+ ---	14	BI.14 // SPARE
	- ---	15	BI.15 // SPARE
	- ---	16	BI.16 // SPARE

BINARY INPUT CARD

87T-1		BIM P5	
		RET670	
		LOCATION=P6	
		PLANT ADAPTED CONFIGURATION	
SHT.228/E8	+ ---	X51	
	- ---	1	BI.01 // SPARE
	+ ---	2	BI.02 // SPARE
	- ---	3	BI.03 // SPARE
	+ ---	4	BI.04 // SPARE
	- ---	5	BI.05 // SPARE
	+ ---	6	BI.06 // SPARE
	- ---	7	BI.07 // SPARE
	+ ---	8	BI.08 // SPARE
	- ---	9	BI.09 // SPARE
	+ ---	10	BI.10 // SPARE
	- ---	11	BI.11 // SPARE
	+ ---	12	BI.12 // SPARE
	- ---	13	BI.13 // SPARE
	+ ---	14	BI.14 // SPARE
	- ---	15	BI.15 // SPARE
	- ---	16	BI.16 // SPARE

THIS DRAWING AND THE INFORMATION CONTAINED HEREIN ARE THE SOLE PROPERTY OF National Grid SA NO REPRODUCTION IN FULL OR IN PART SHALL BE OBTAINED FROM THIS DOCUMENT WITHOUT THE WRITTEN CONSENT OF ITS OWNER.



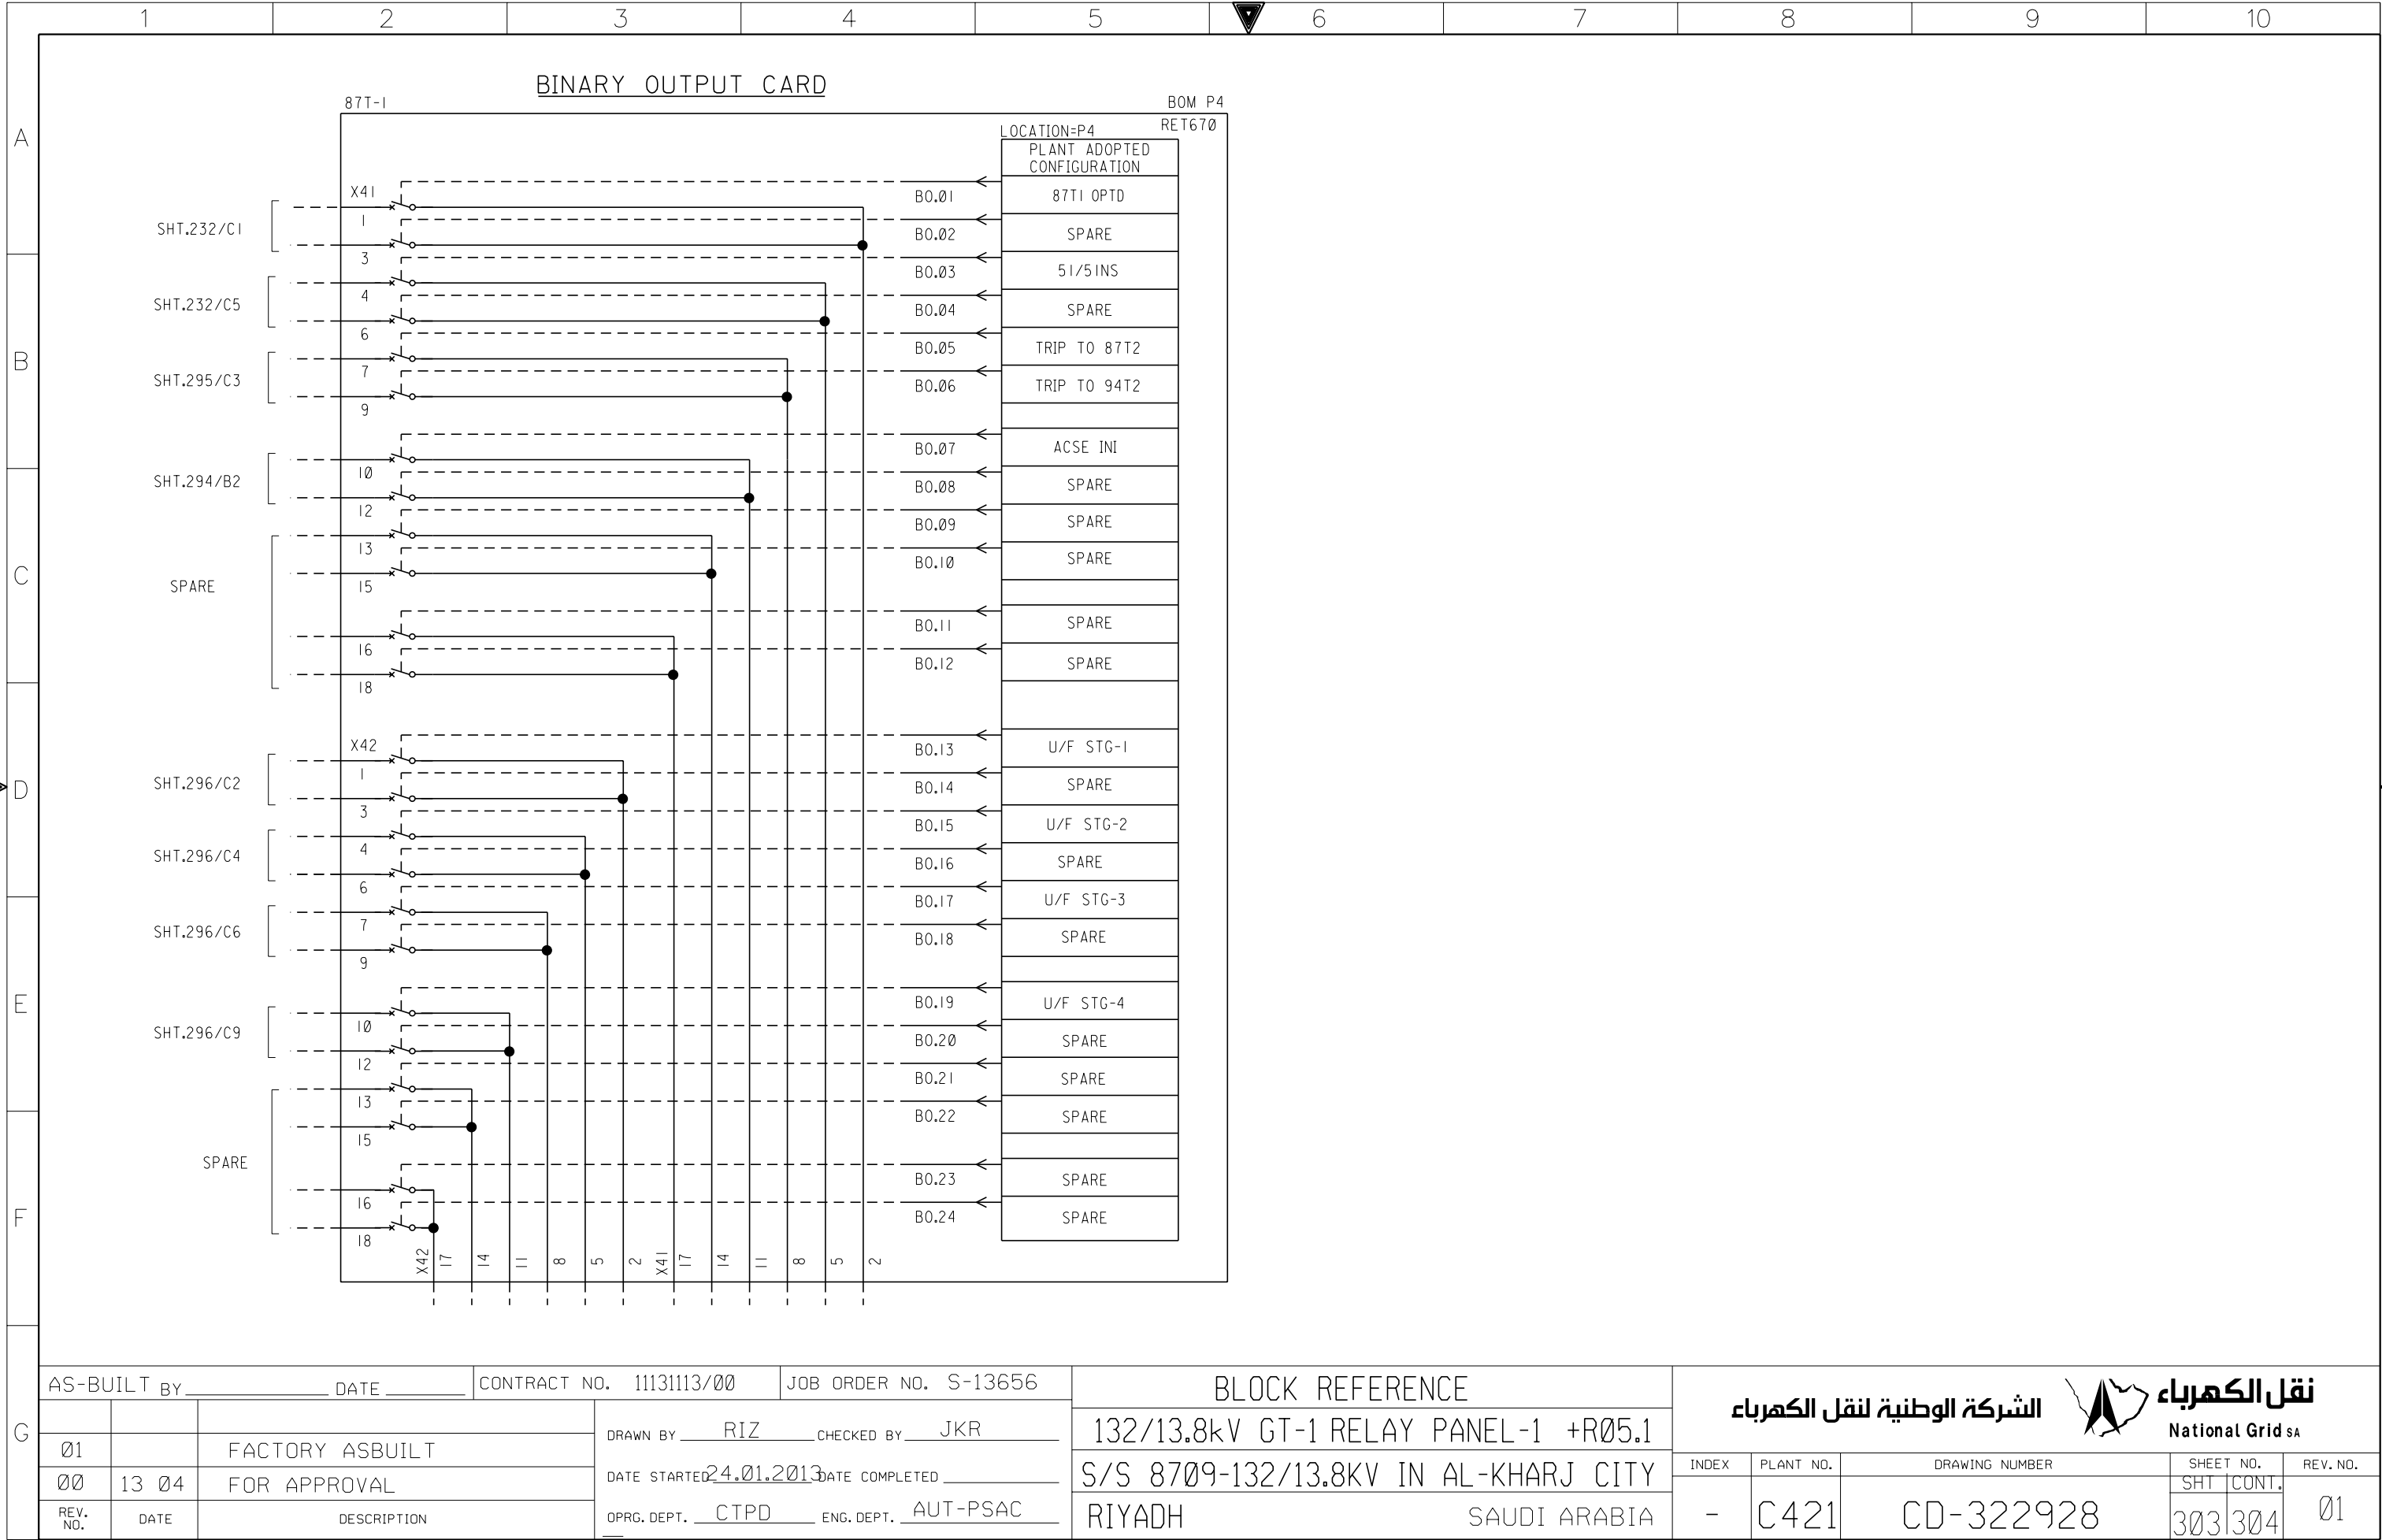

NG/D2-D (2012/01)




DMS


VECTOR

NGD200

THIS DRAWING AND THE INFORMATION CONTAINED HEREIN ARE THE SOLE PROPERTY OF National Grid SA NO REPRODUCTION IN FULL OR IN PART SHALL BE OBTAINED FROM THIS DOCUMENT WITHOUT THE WRITTEN CONSENT OF ITS OWNER.



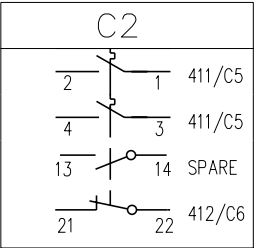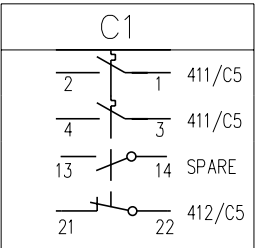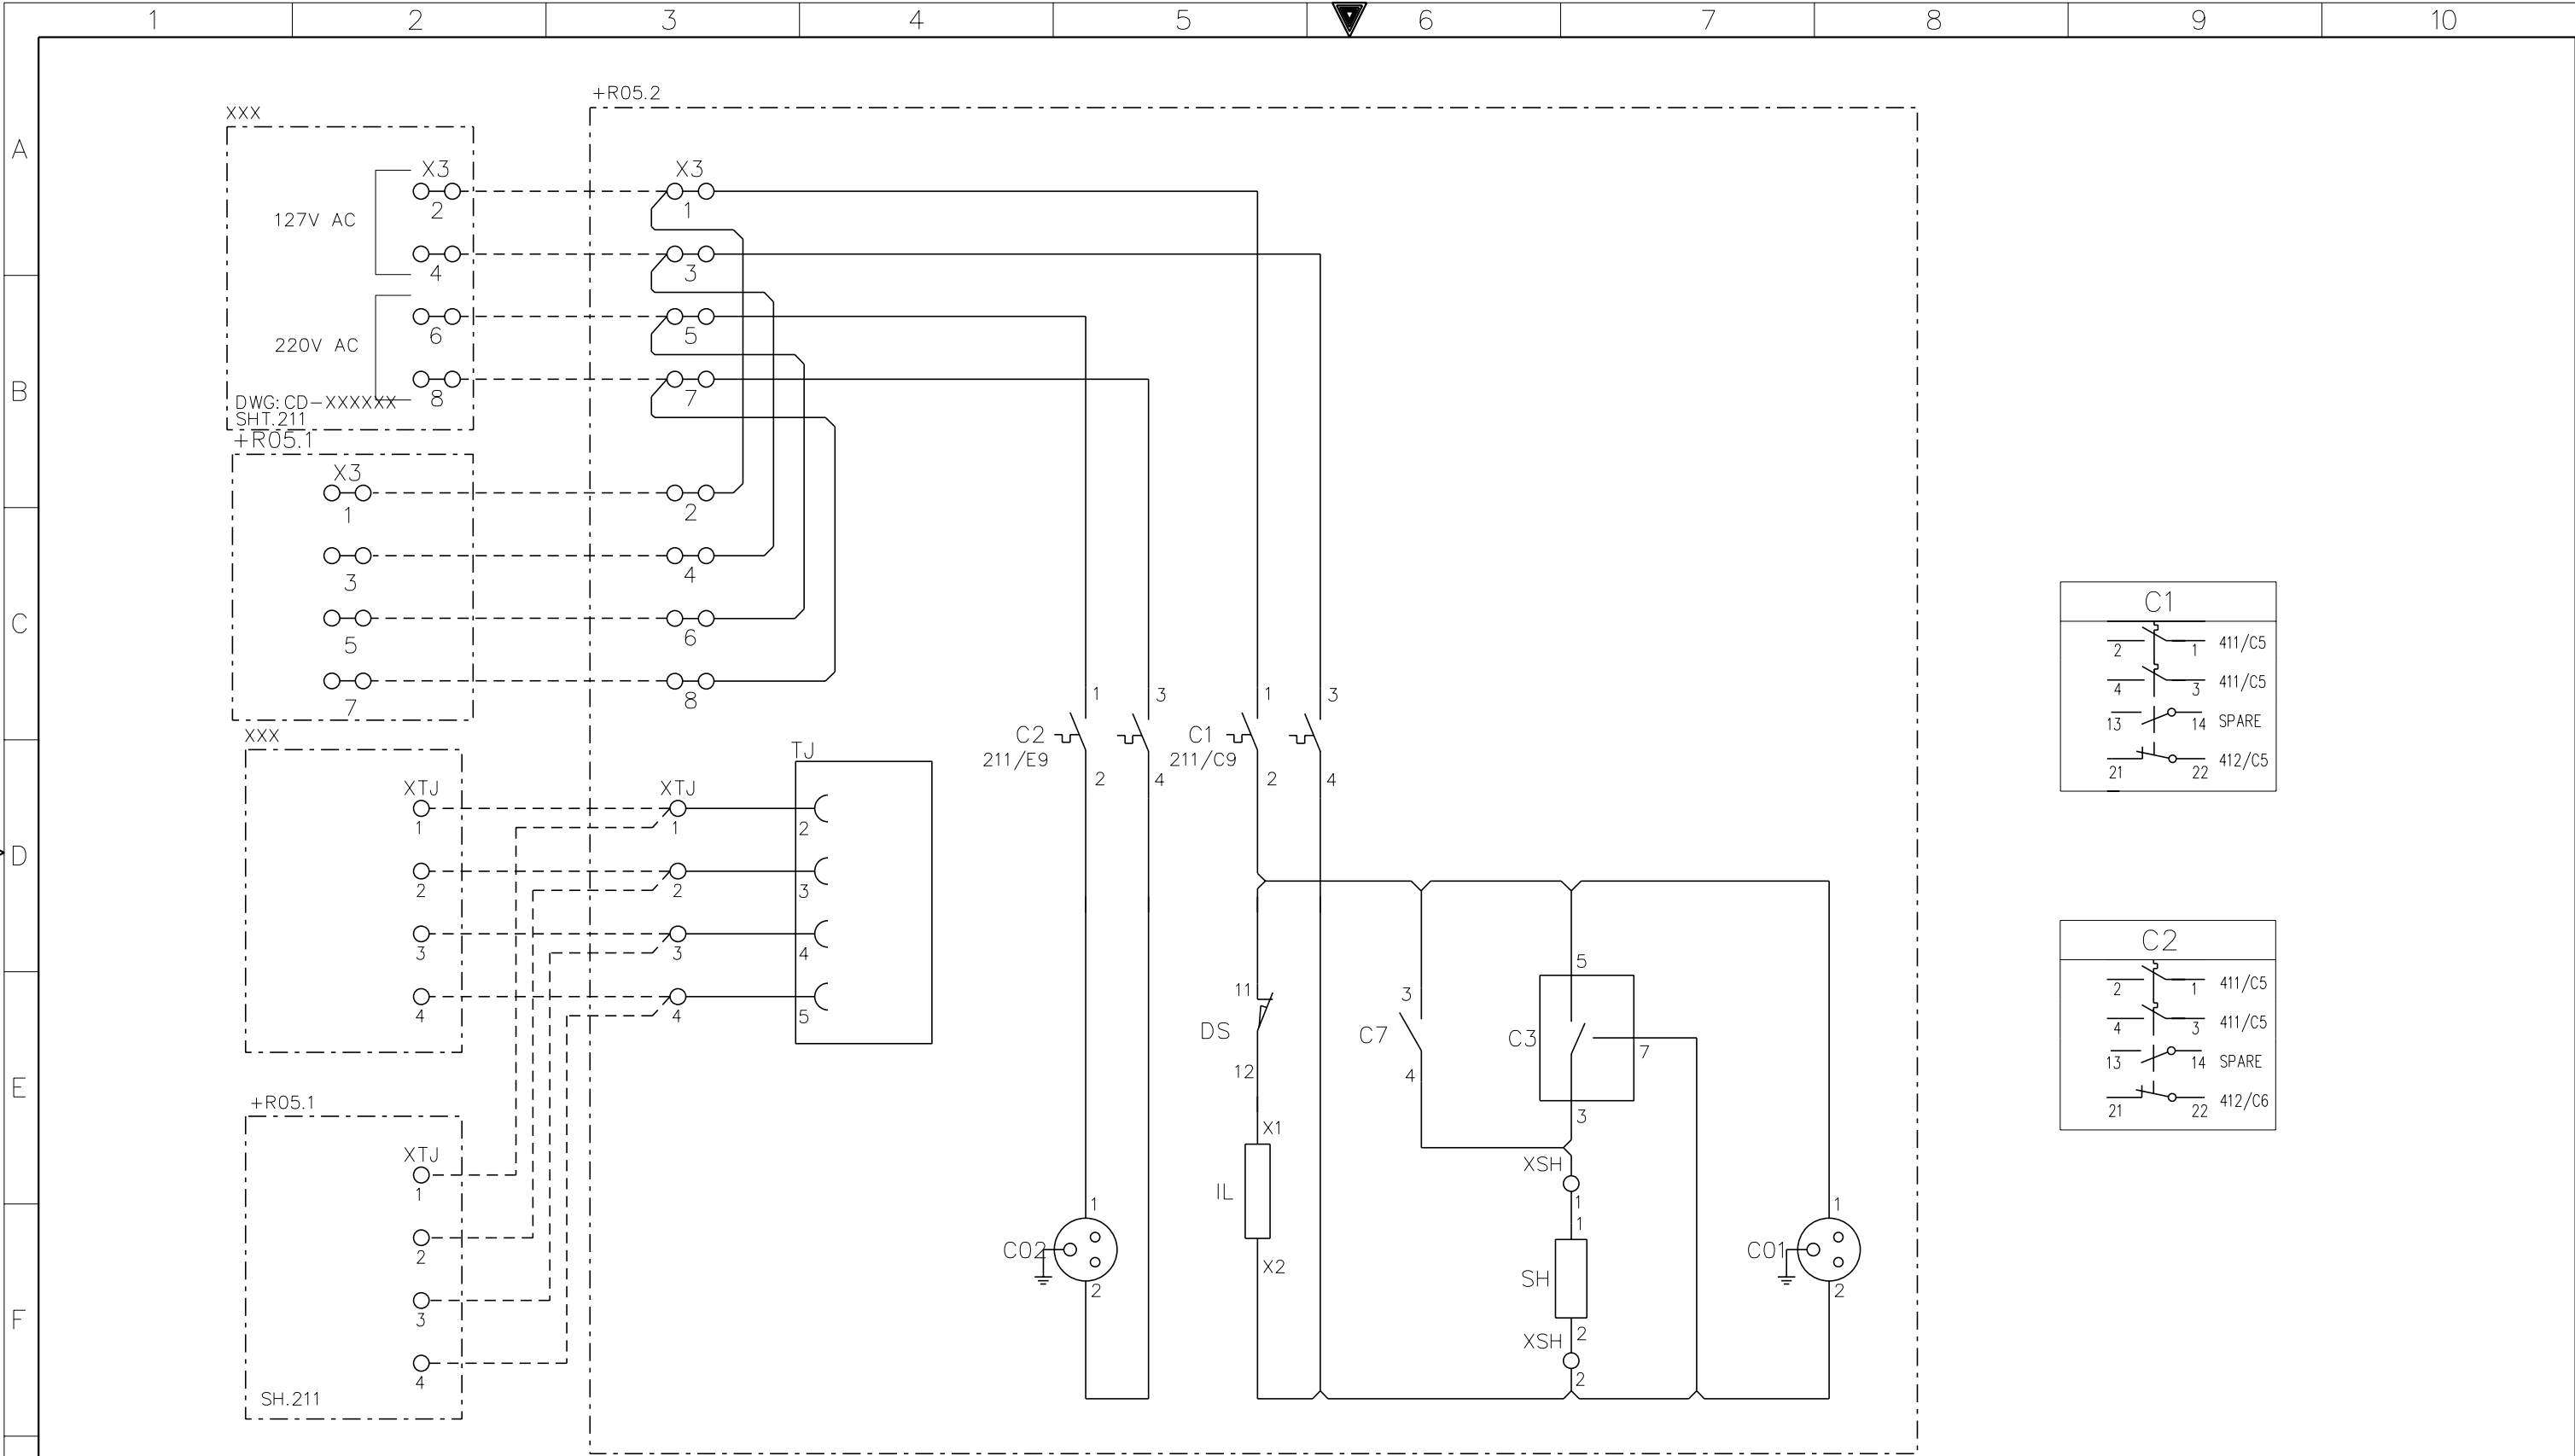


G	AS-BUILT BY _____ DATE _____		CONTRACT NO. 11131113/00		JOB ORDER NO. S-13656		AC SUPPLY FOR ILLUMINATION & POWER SOCKET		<div>الشركة الوطنية لنقل الكهرباء</div> <div>نقل الكهرباء</div> <div>National Grid sa</div>						
	01	13 49	FACTORY ASBUILT		DRAWN BY RIZ CHECKED BY JKR		132/13.8kV GT-1 RELAY PANEL-2 +R05.2		INDEX	PLANT NO.	DRAWING NUMBER		SHEET NO.		REV. NO.
	00	13 04	FOR APPROVAL		DATE STARTED 24.01.2013 DATE COMPLETED _____		S/S 8709-132/13.8KV IN AL-KHARJ CITY		-	C421	CD-322928		SHT	CONT.	01
	REV. NO.	DATE	DESCRIPTION		OPRG. DEPT. CTPD ENG. DEPT. AUT-PSAC		RIYADH SAUDI ARABIA						411	412	



DMS

VECTOR

NGD200

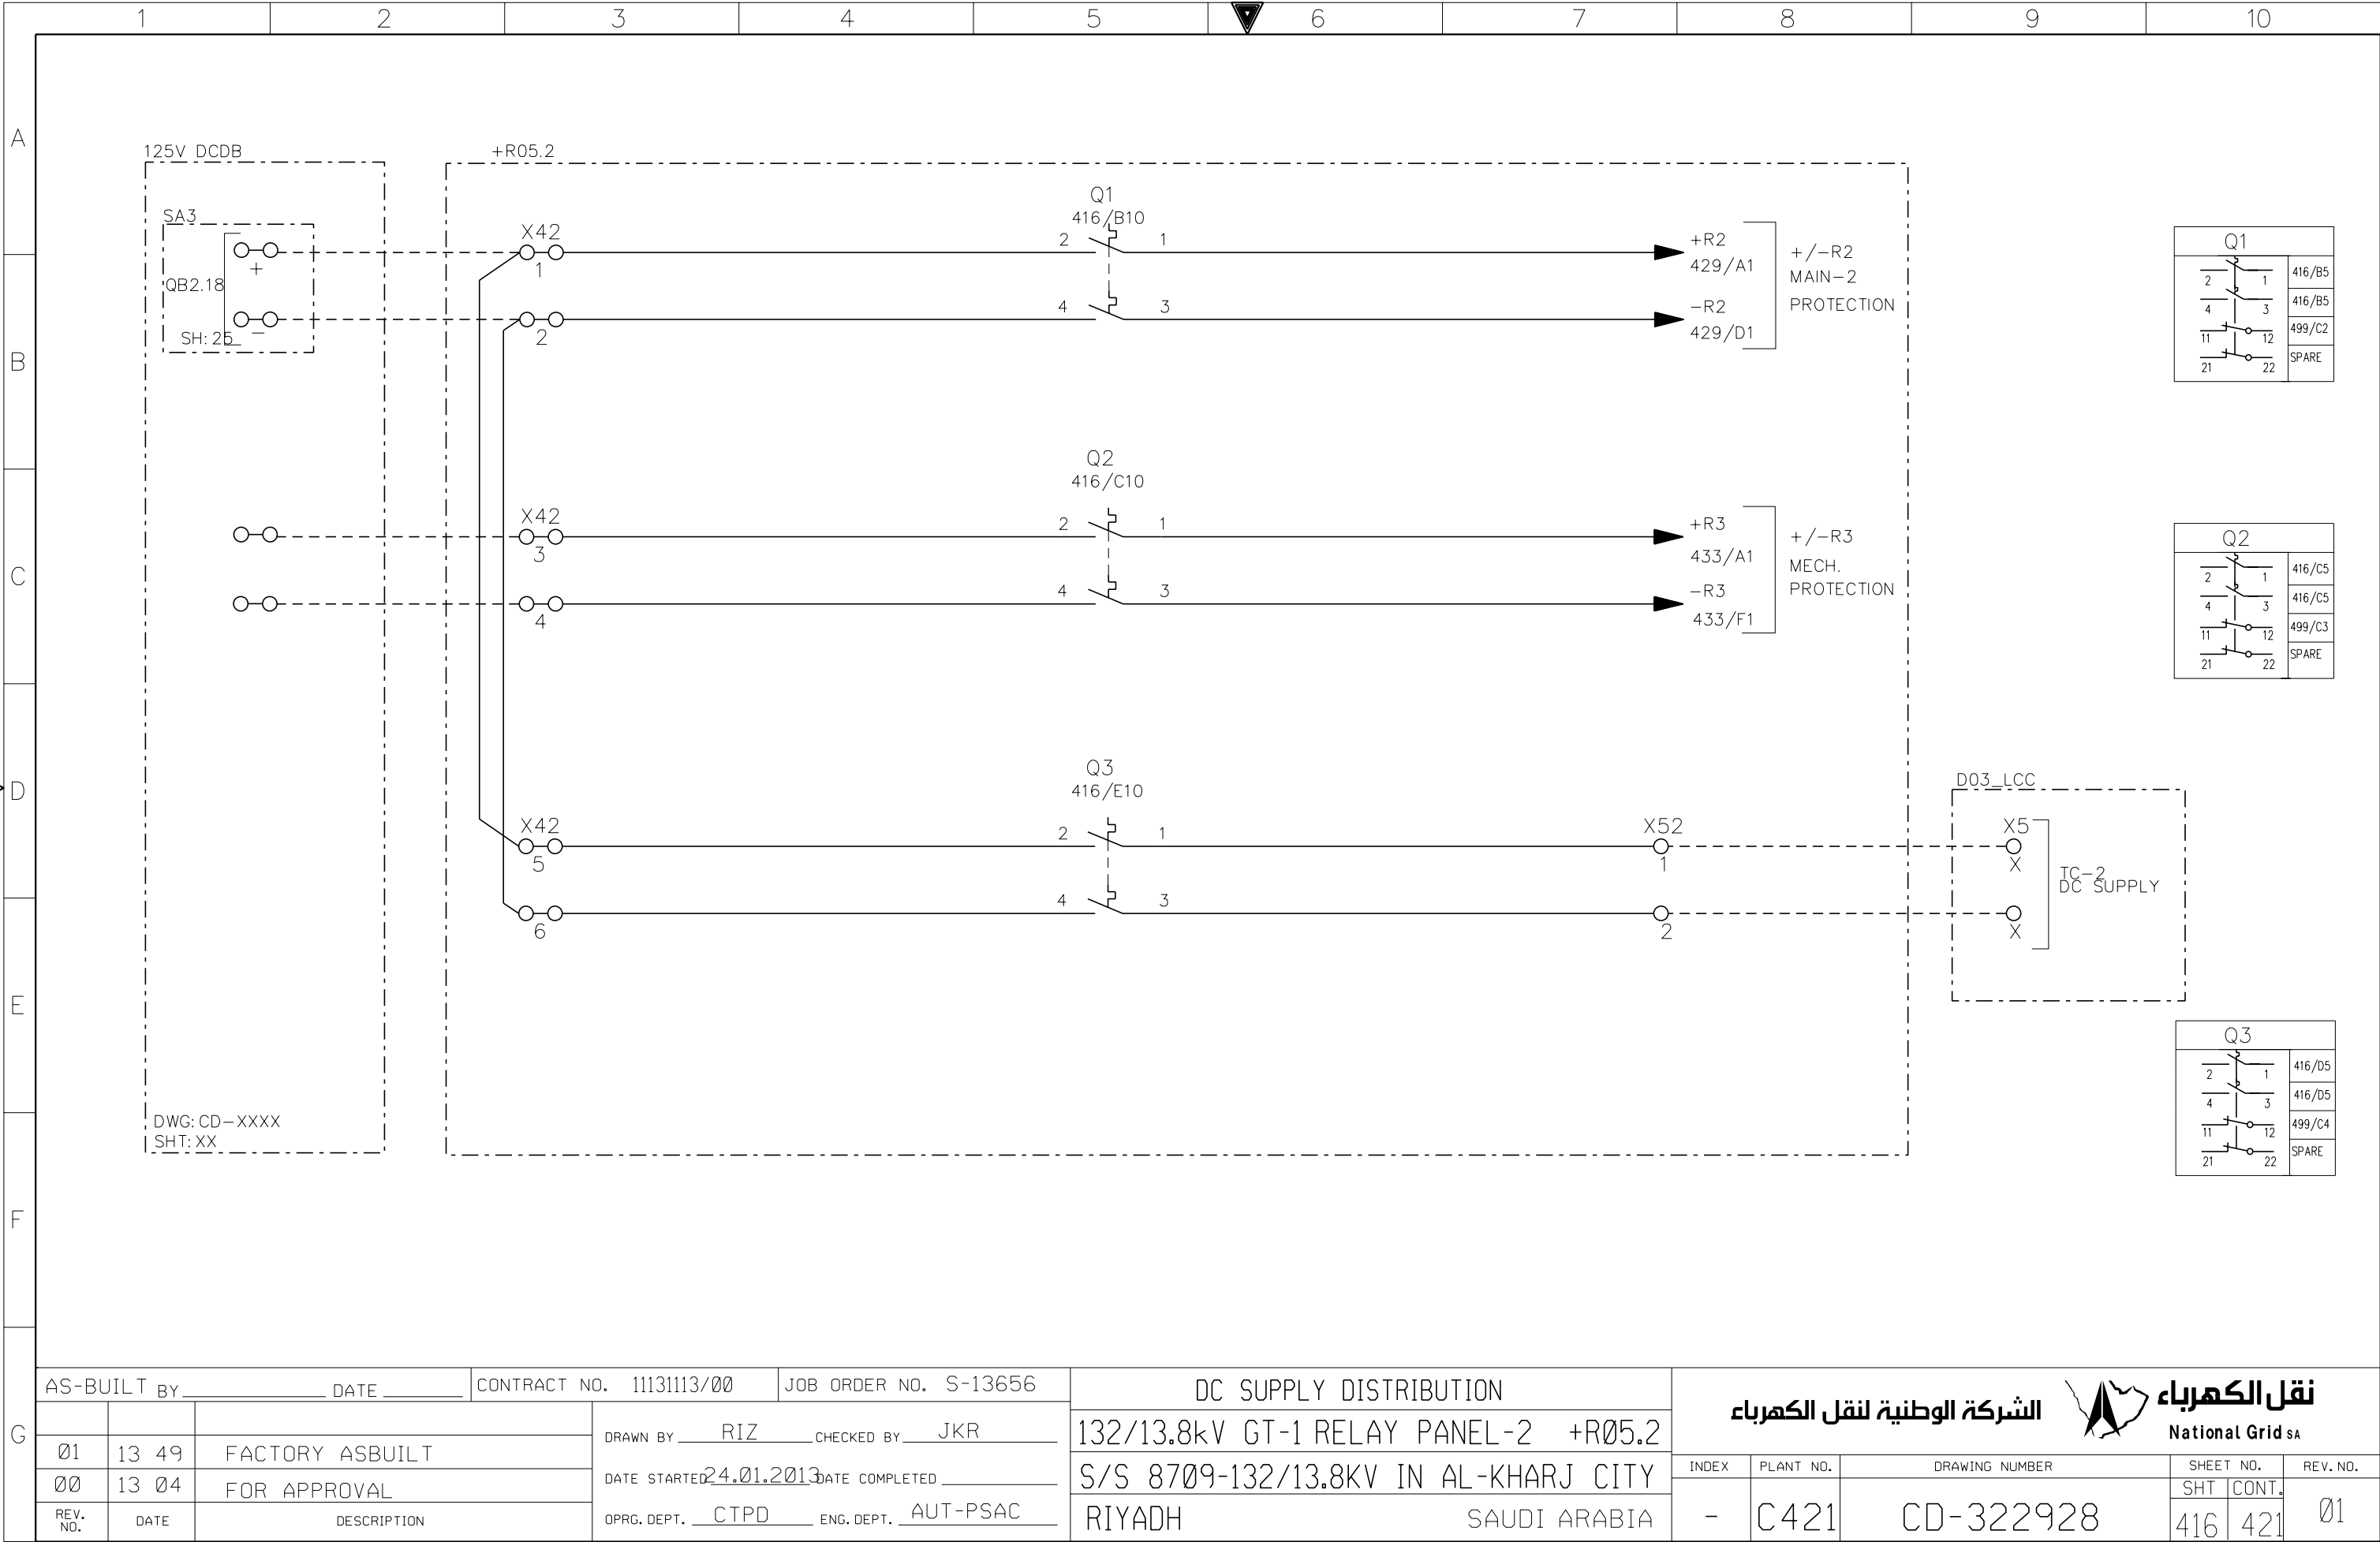

AS-BUILT BY \_\_\_\_\_ DATE \_\_\_\_\_ CONTRACT NO. 11131113/00 JOB ORDER NO. S-13656

01	13 49	FACTORY ASBUILT	DRAWN BY RIZ	CHECKED BY JKR
00	13 04	FOR APPROVAL	DATE STARTED 24.01.2013	DATE COMPLETED
REV. NO.	DATE	DESCRIPTION	OPRG. DEPT. CTPD	ENG. DEPT. AUT-PSAC


DC SUPPLY DISTRIBUTION

132/13.8kV GT-1 RELAY PANEL-2 +R05.2


S/S 8709-132/13.8KV IN AL-KHARJ CITY

RIYADH SAUDI ARABIA

الشركة الوطنية لنقل الكهرباء				
National Grid sa				
INDEX	PLANT NO.	DRAWING NUMBER	SHEET NO.	REV. NO.
-	C421	CD-322928	SHT 416	CONT. 421
				01

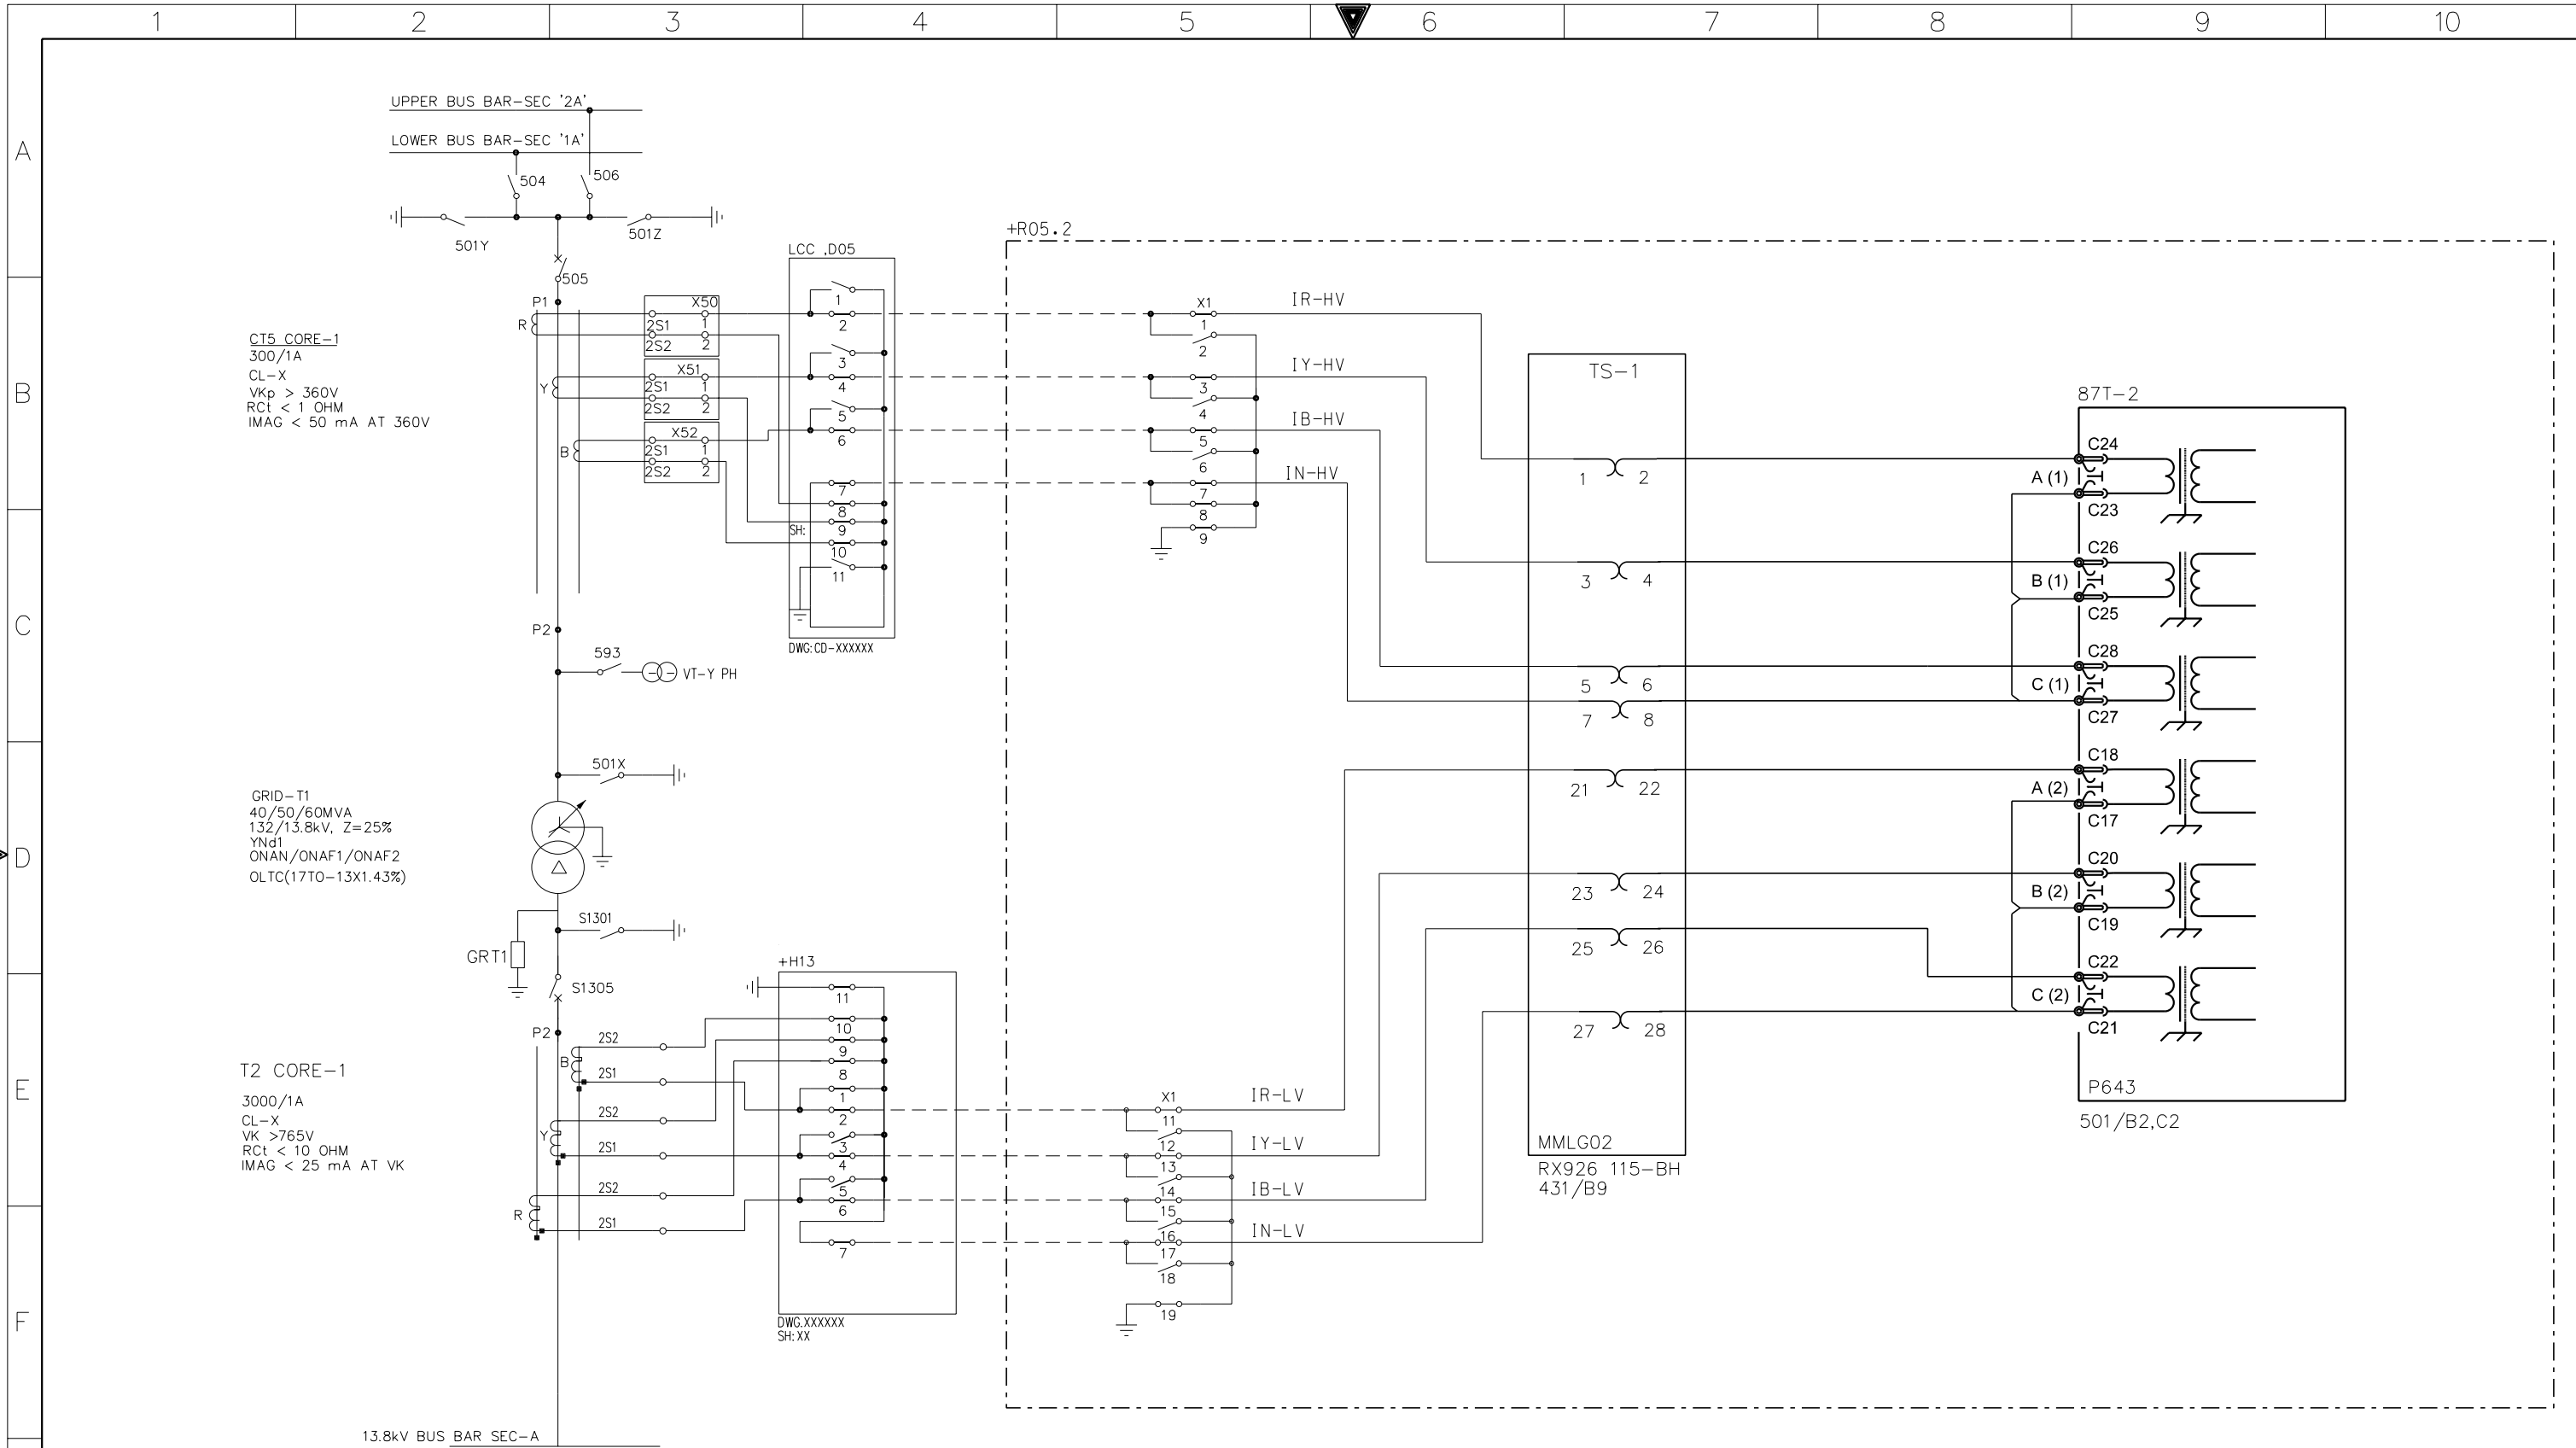

G	AS-BUILT BY _____ DATE _____		CONTRACT NO. 11131113/00		JOB ORDER NO. S-13656		CT CIRCUITS 87T-2 RELAY		<div>الشركة الوطنية لنقل الكهرباء</div> <div>نقل الكهرباء</div> <div>National Grid sa</div>						
				DRAWN BY <u>RIZ</u> CHECKED BY <u>JKR</u>		132/13.8kV GT-1 RELAY PANEL-2 +R05.2									
	01	13 49	FACTORY ASBUILT		DATE STARTED <u>24.01.2013</u> DATE COMPLETED _____		S/S 8709-132/13.8KV IN AL-KHARJ CITY		INDEX	PLANT NO.	DRAWING NUMBER		SHEET NO.		REV. NO.
	00	13 04	FOR APPROVAL		OPRG. DEPT. <u>CTPD</u> ENG. DEPT. <u>AUT-PSAC</u>		RIYADH SAUDI ARABIA		-	C421	CD-322928		SHT	CONT.	01
	REV. NO.	DATE	DESCRIPTION										421	422	

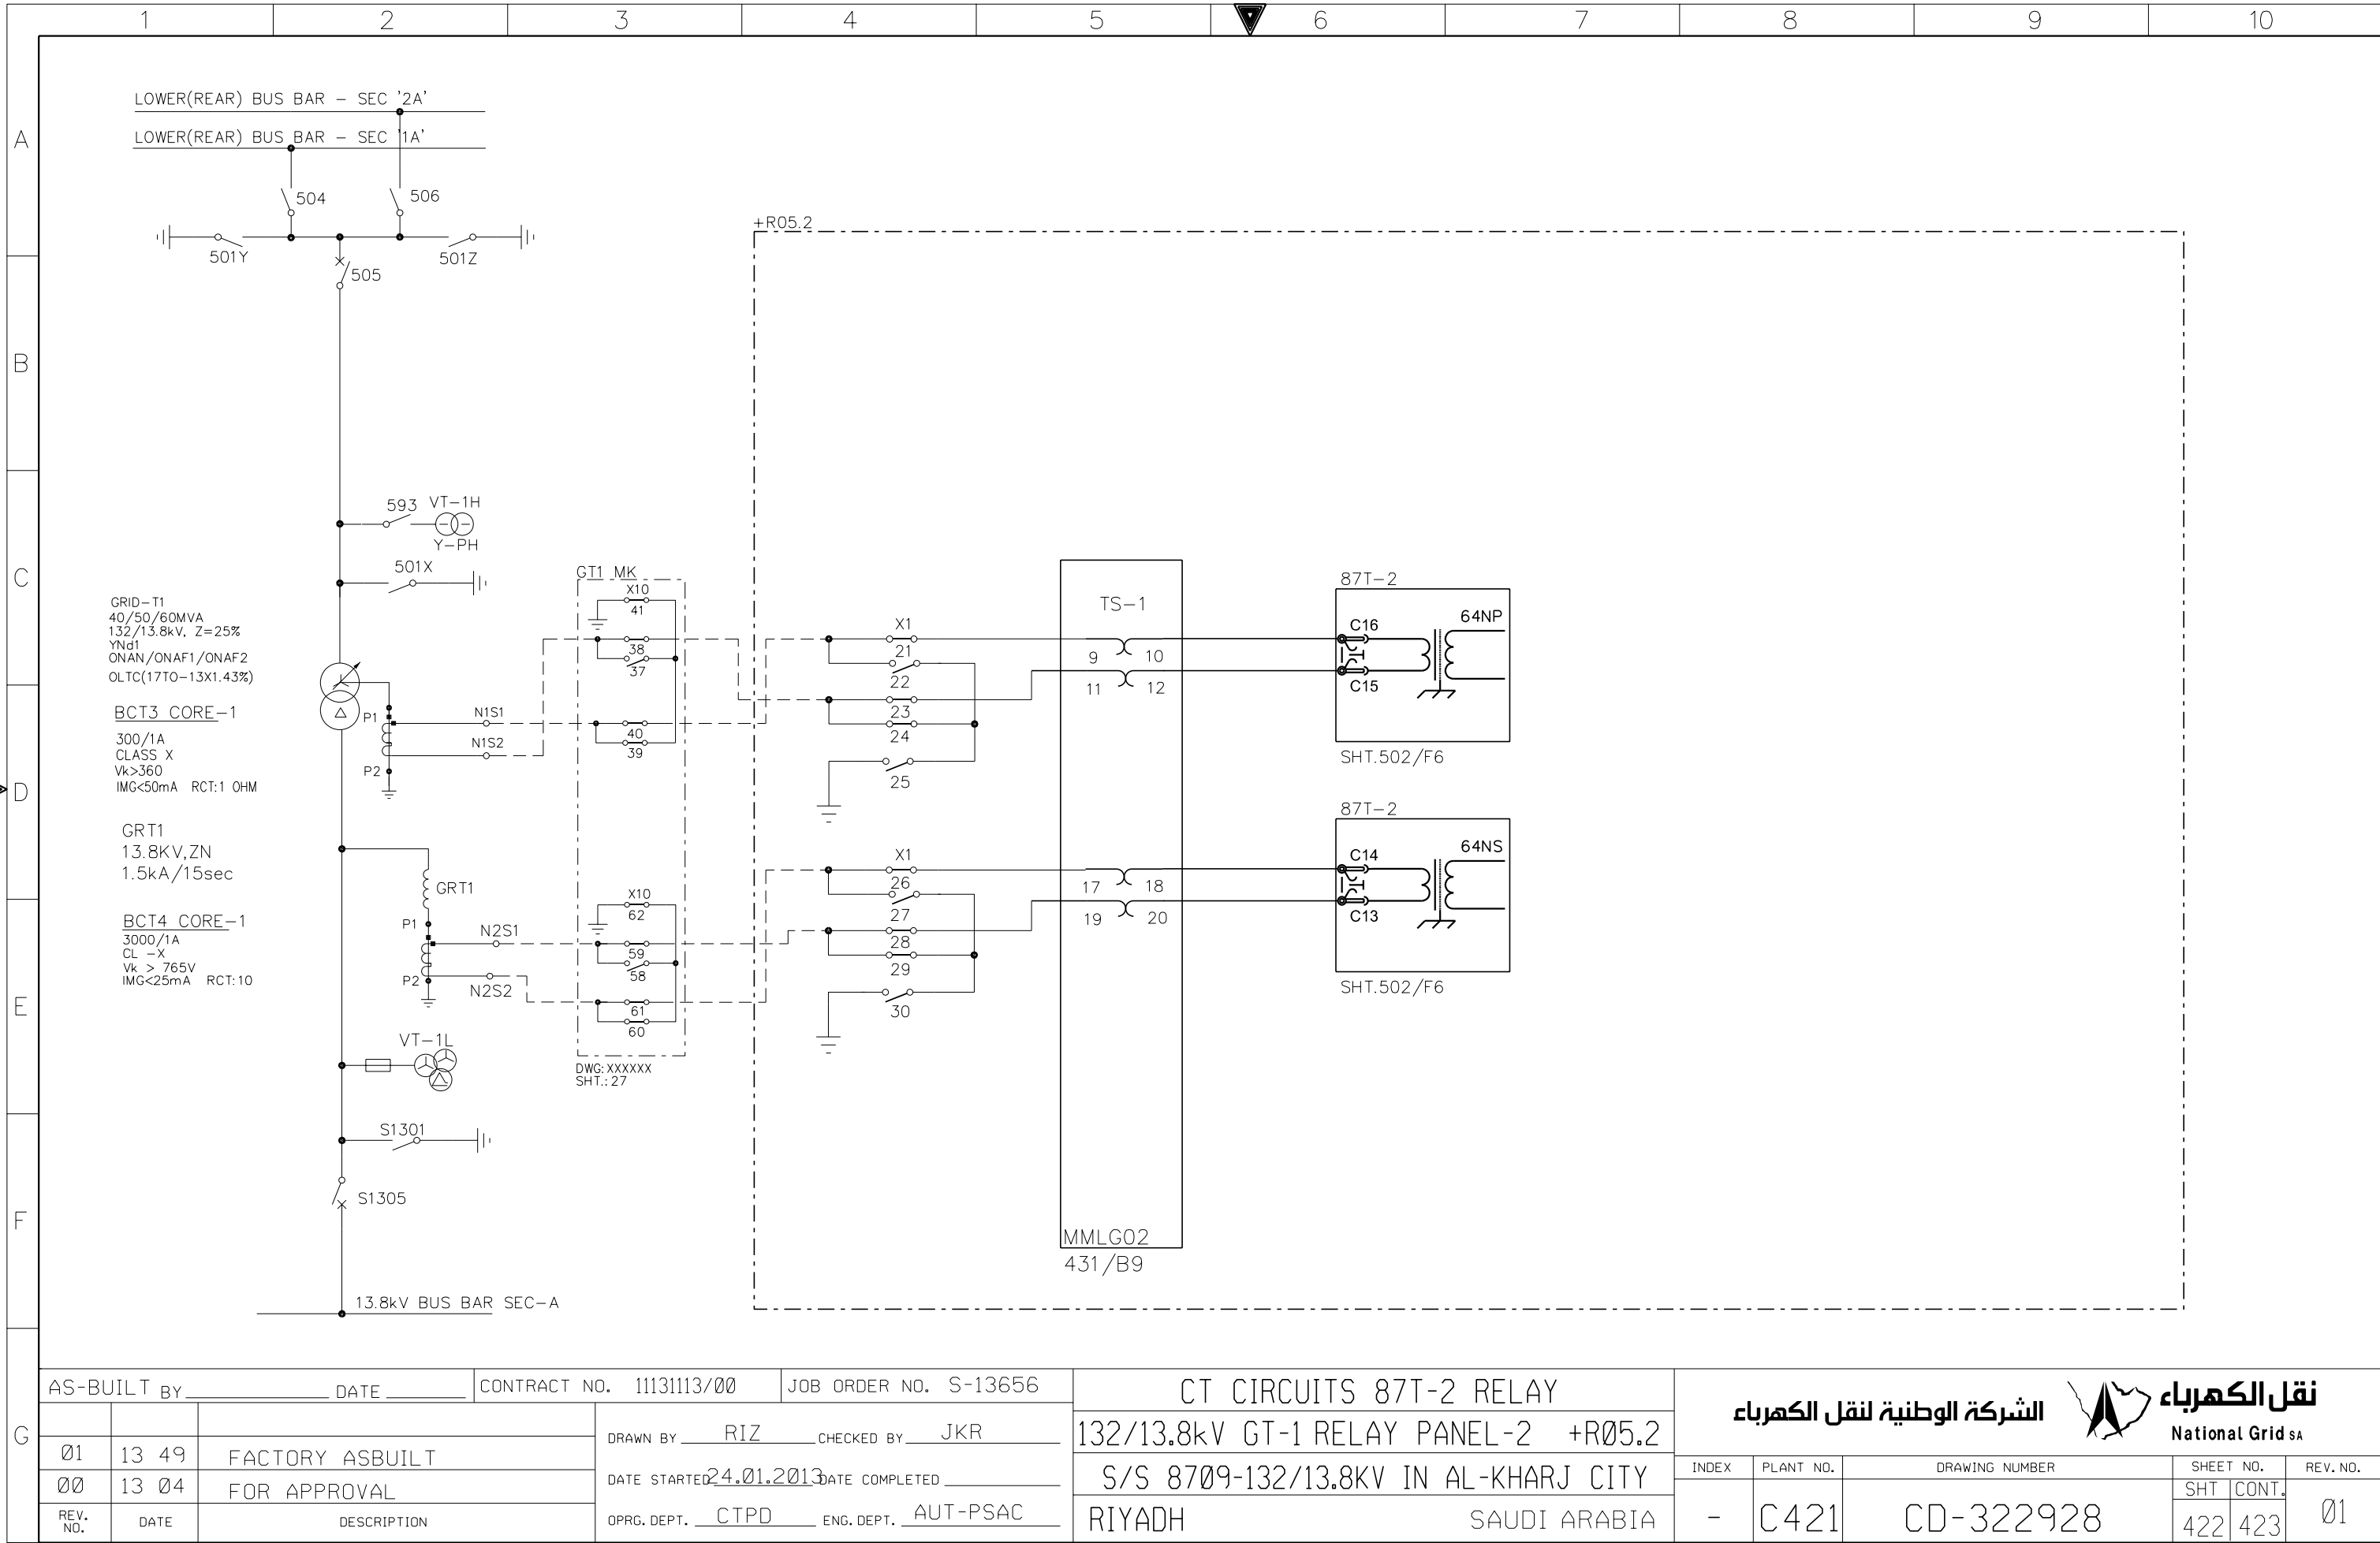

AS-BUILT BY \_\_\_\_\_ DATE \_\_\_\_\_ CONTRACT NO. 11131113/00 JOB ORDER NO. S-13656

01 13 49 FACTORY ASBUILT

00 13 04 FOR APPROVAL

DRAWN BY RIZ CHECKED BY JKR

DATE STARTED 24.01.2013 DATE COMPLETED \_\_\_\_\_

OPRG. DEPT. CTPD ENG. DEPT. AUT-PSAC

CT CIRCUITS 87T-2 RELAY

132/13.8kV GT-1 RELAY PANEL-2 +R05.2

S/S 8709-132/13.8KV IN AL-KHARJ CITY

RIYADH

SAUDI ARABIA

الشركة الوطنية لنقل الكهرباء



نقل الكهرباء  
National Grid sa


INDEX	PLANT NO.	DRAWING NUMBER	SHEET NO.		REV. NO.
			SHT	CONT.	
-	C421	CD-322928	422	423	01

NG/D2-D (2012/01)

DMS

VECTOR

NGD200

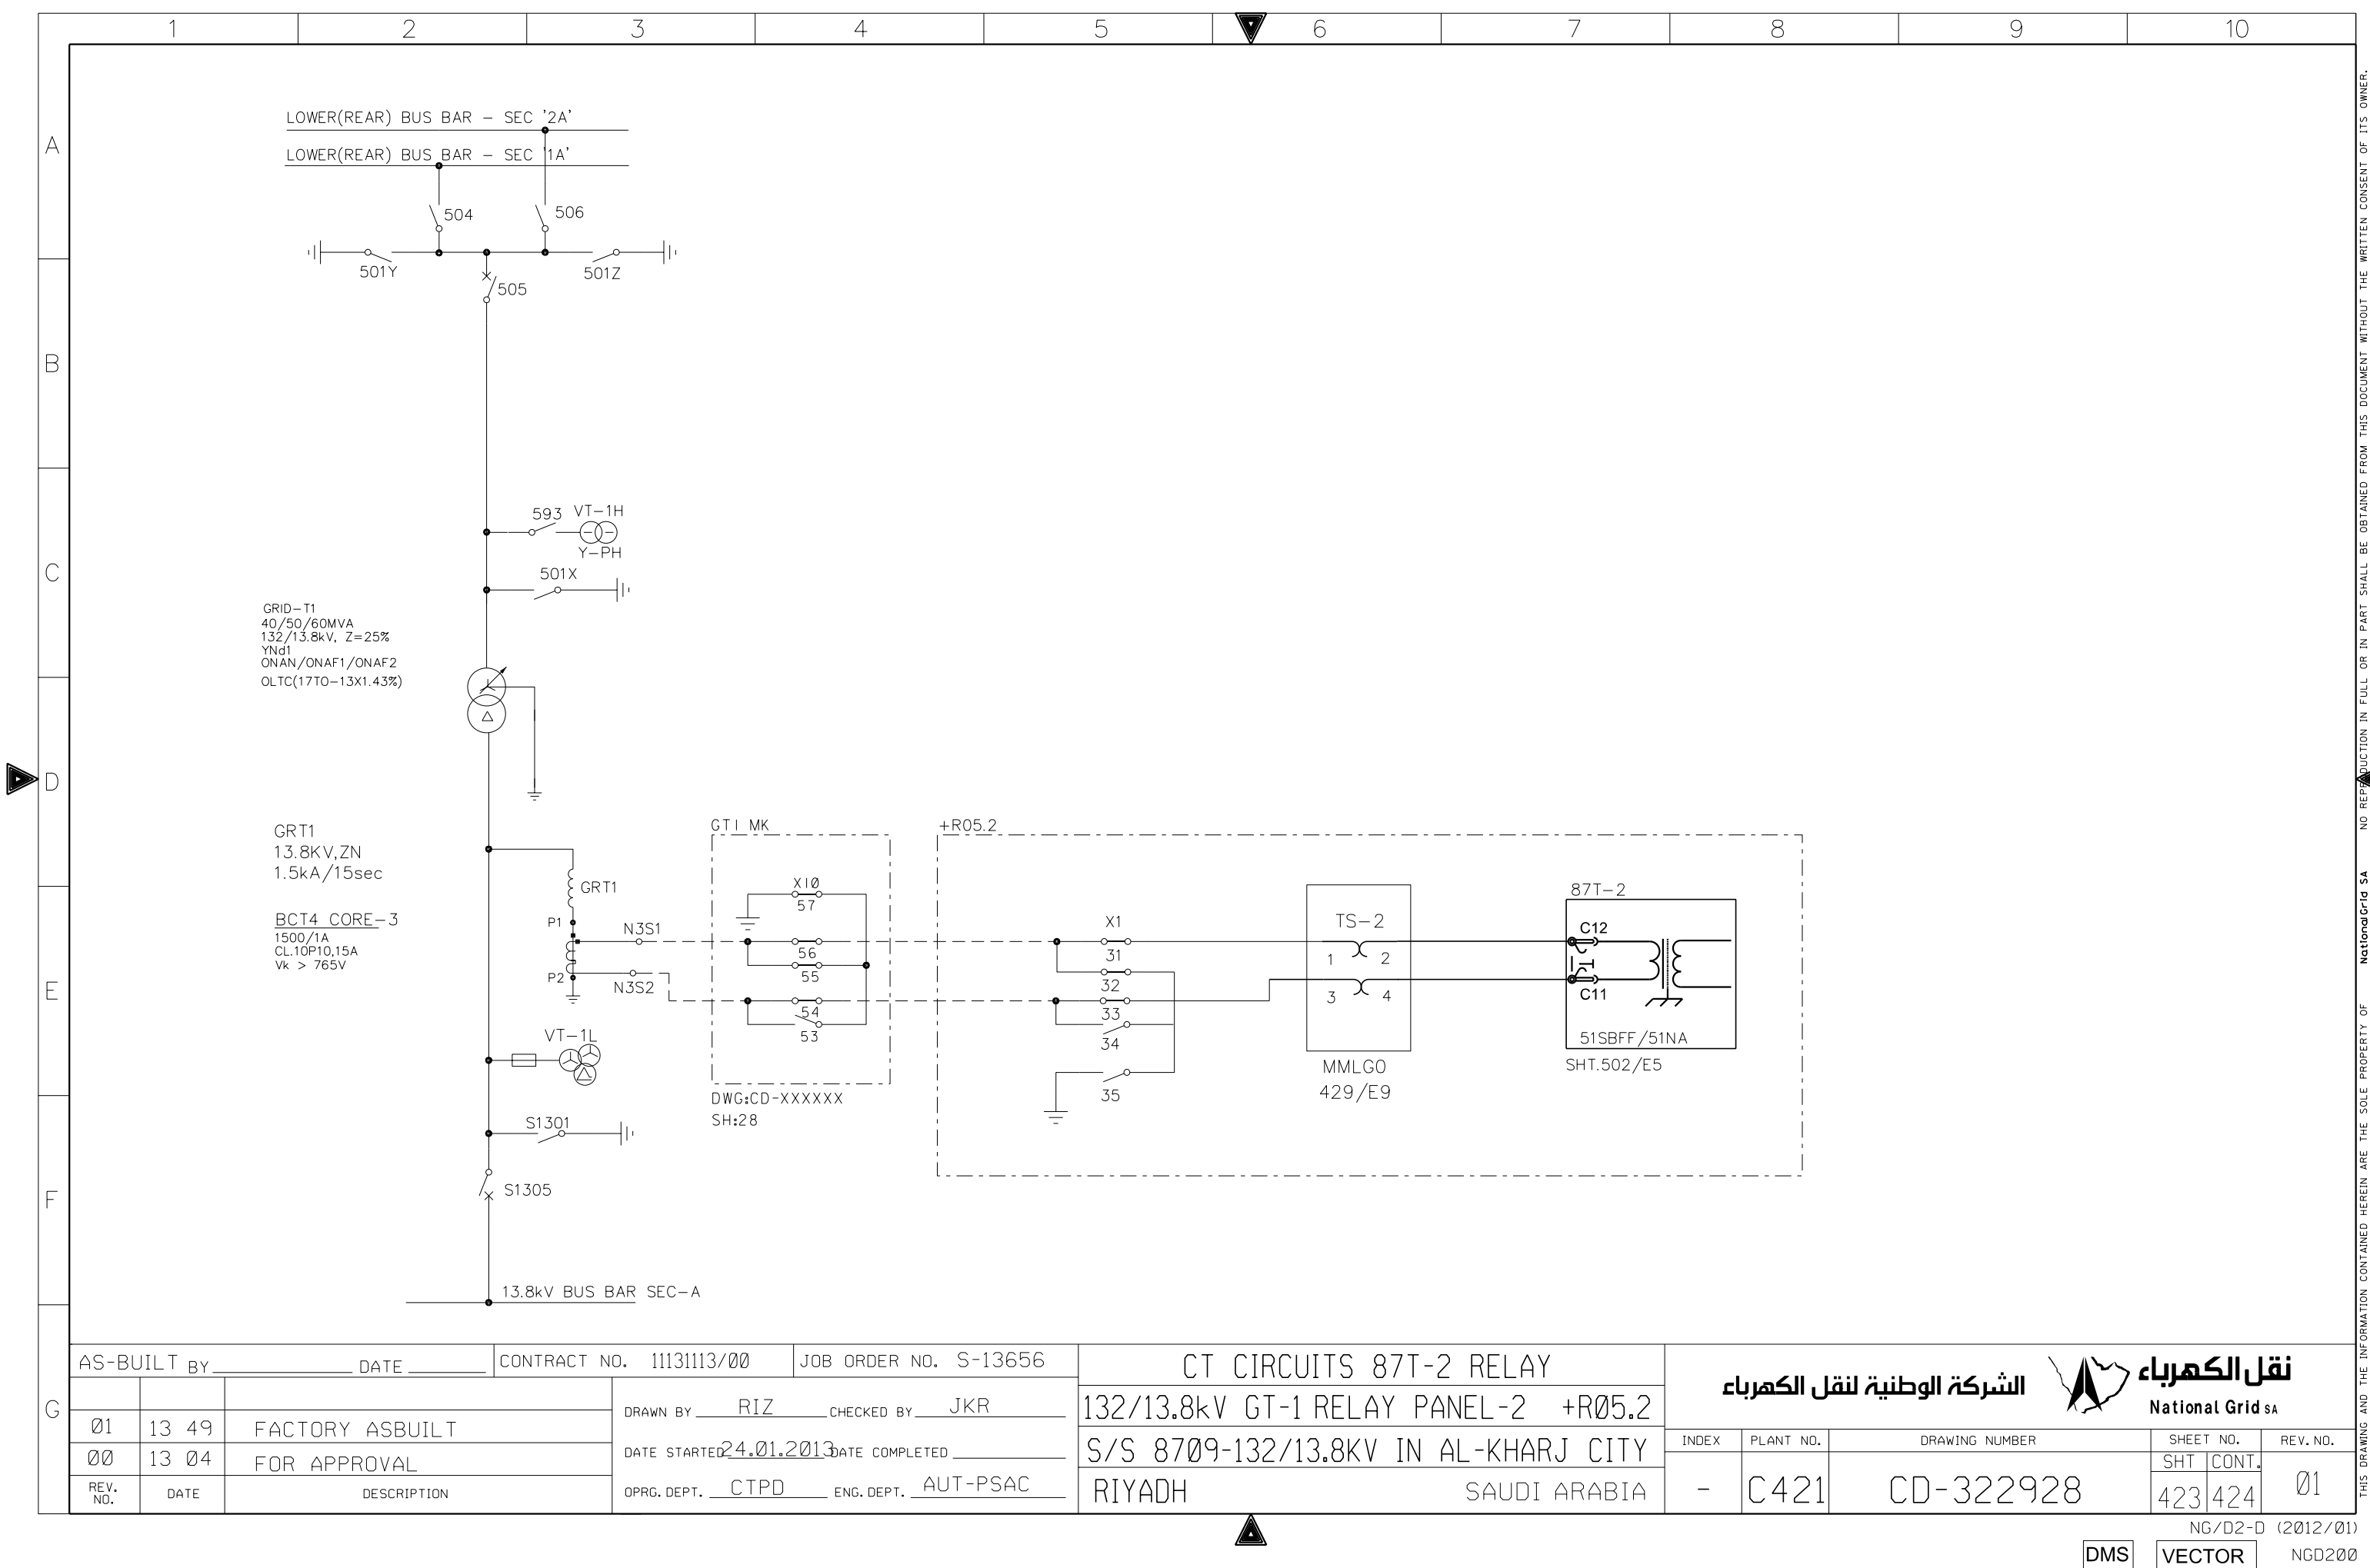


AS-BUILT BY \_\_\_\_\_ DATE \_\_\_\_\_ CONTRACT NO. 11131113/00 JOB ORDER NO. S-13656

01	13 49	FACTORY ASBUILT	DRAWN BY RIZ CHECKED BY JKR
00	13 04	FOR APPROVAL	DATE STARTED 24.01.2013 DATE COMPLETED _____
REV. NO.	DATE	DESCRIPTION	OPRG. DEPT. CTPD ENG. DEPT. AUT-PSAC

CT CIRCUITS 87T-2 RELAY  
132/13.8kV GT-1 RELAY PANEL-2 +R05.2  
S/S 8709-132/13.8KV IN AL-KHARJ CITY  
RIYADH SAUDI ARABIA

الشركة الوطنية لنقل الكهرباء National Grid sa				
INDEX	PLANT NO.	DRAWING NUMBER	SHEET NO.	
-	C421	CD-322928	SHT	CONT.
-	C421	CD-322928	423	424
				REV. NO. 01



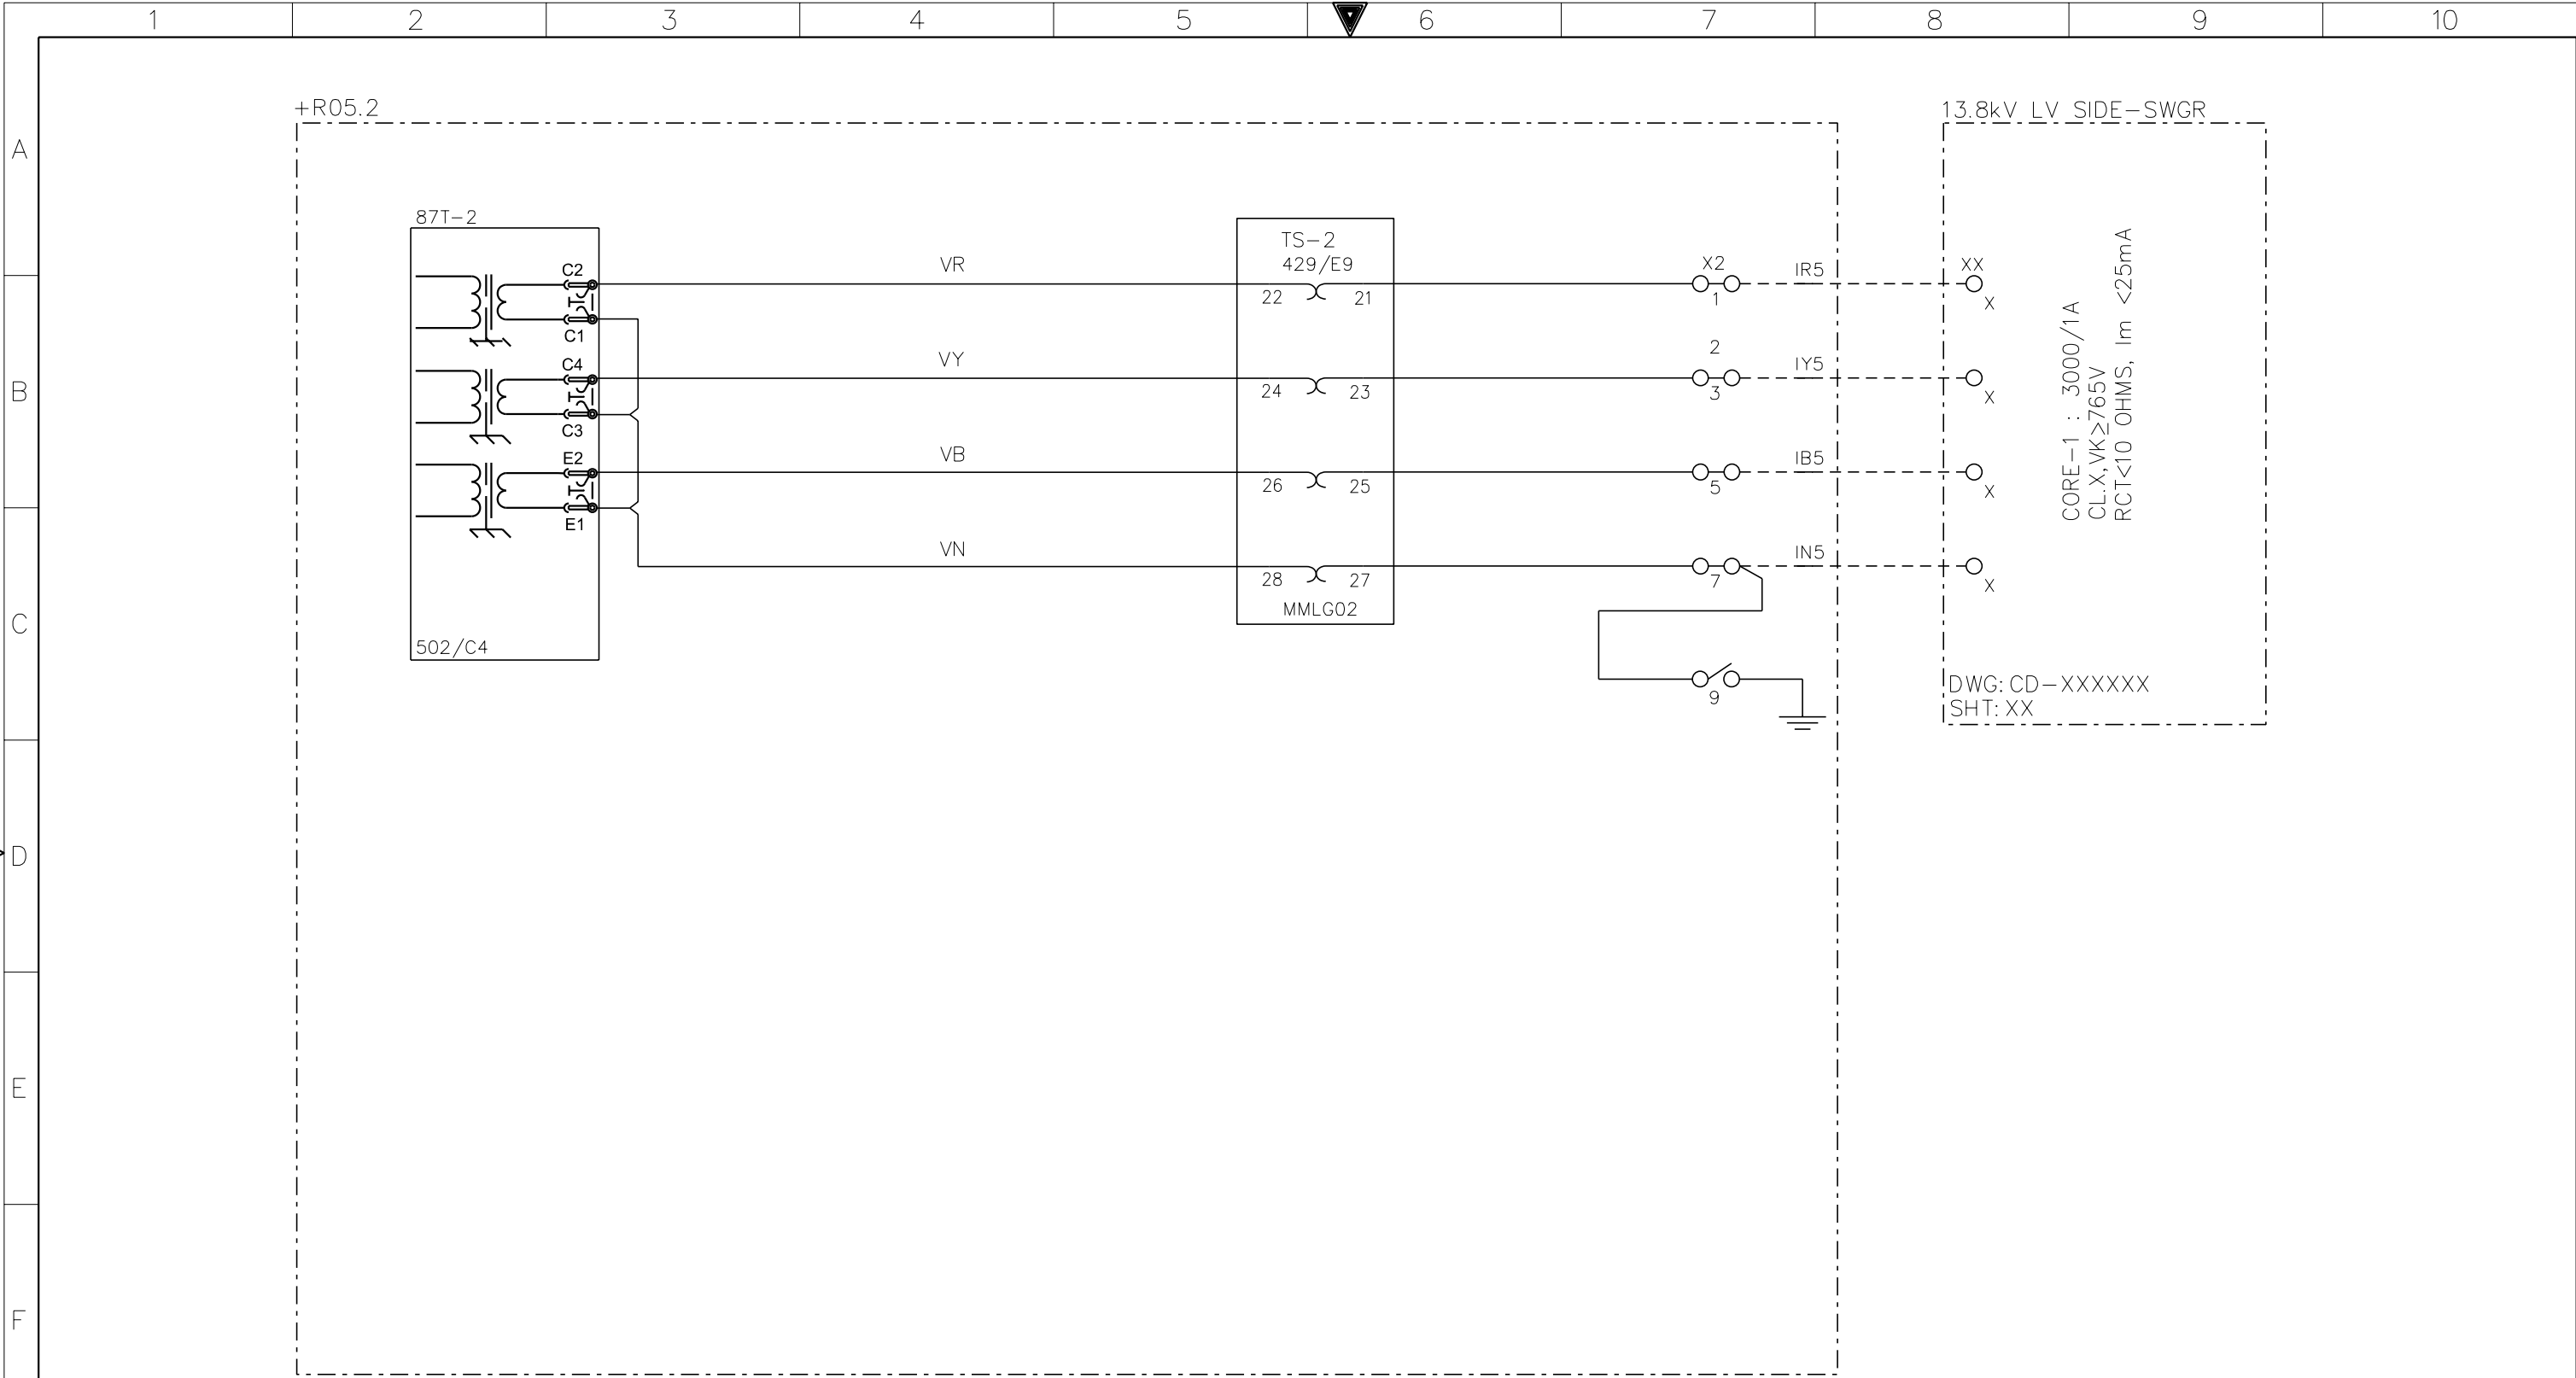

AS-BUILT BY \_\_\_\_\_ DATE \_\_\_\_\_ CONTRACT NO. 11131113/00 JOB ORDER NO. S-13656

01	13 49	FACTORY ASBUILT
00	13 04	FOR APPROVAL
REV. NO.	DATE	DESCRIPTION


DRAWN BY RIZ	CHECKED BY JKR
DATE STARTED 24.01.2013	DATE COMPLETED
OPRG. DEPT. CTPD	ENG. DEPT. AUT-PSAC

CT & VT CIRCUITS 87T-2 RELAY
132/13.8kV GT-1 RELAY PANEL-2 +R05.2
S/S 8709-132/13.8KV IN AL-KHARJ CITY
RIYADH SAUDI ARABIA

الشركة الوطنية لنقل الكهرباء		نقل الكهرباء		National Grid sa	
INDEX	PLANT NO.	DRAWING NUMBER	SHEET NO.		REV. NO.
-	C421	CD-322928	SHT	CONT.	01
			424	429	





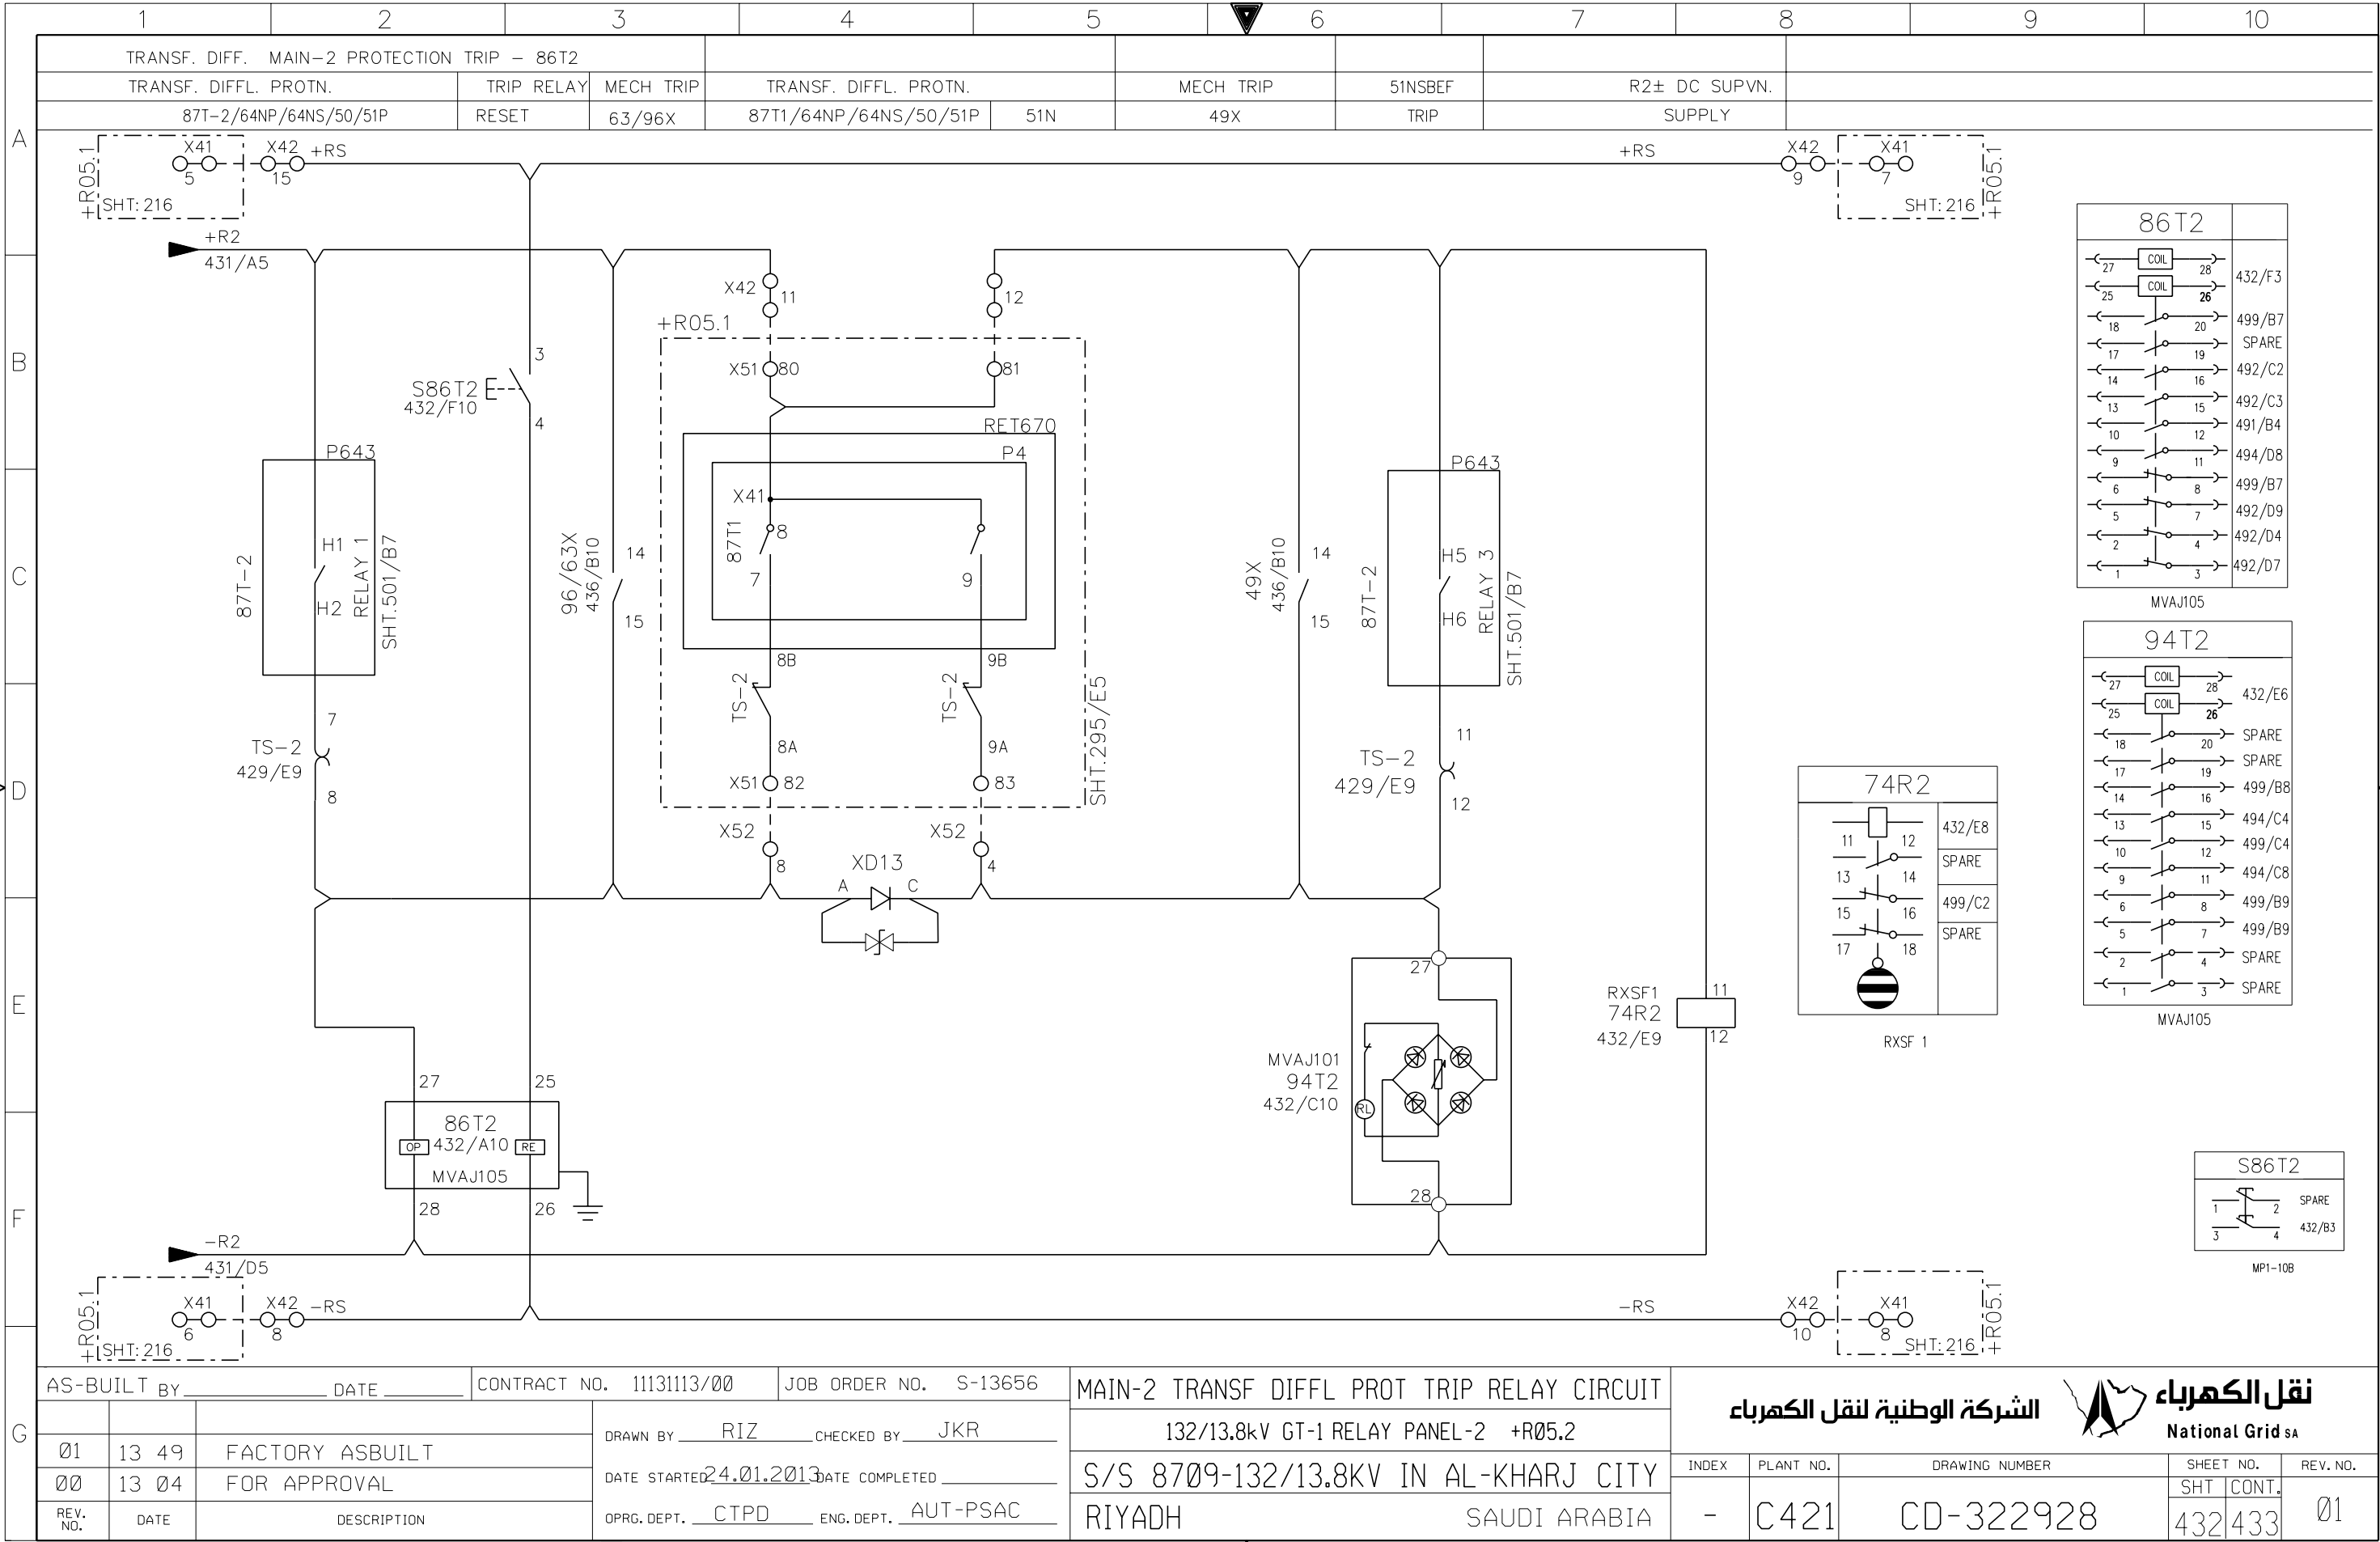

86T2		
27	COIL	28 432/F3
25	COIL	26 499/B7
18		20 SPARE
17		19 492/C2
14		16 492/C3
13		15 491/B4
10		12 494/D8
9		11 499/B7
6		8 492/D9
5		7 492/D4
2		4 492/D7
1		3

MVAJ105

94T2		
27	COIL	28 432/E6
25	COIL	26 SPARE
18		20 SPARE
17		19 499/B8
14		16 494/C4
13		15 499/C4
10		12 494/C8
9		11 499/B9
6		8 499/B9
5		7 SPARE
2		4 SPARE
1		3 SPARE

MVAJ105

74R2		
11		12 432/E8
13		14 SPARE
15		16 499/C2
17		18 SPARE

RXSF 1

S86T2		
1		2 SPARE
3		4 432/B3

MP1-10B

THIS DRAWING AND THE INFORMATION CONTAINED HEREIN ARE THE SOLE PROPERTY OF National Grid SA NO REPRODUCTION IN FULL OR IN PART SHALL BE OBTAINED FROM THIS DOCUMENT WITHOUT THE WRITTEN CONSENT OF ITS OWNER.



الشركة الوطنية لنقل الكهرباء

NG/D2-D (2012/01)

DMS

VECTOR

NGD200
















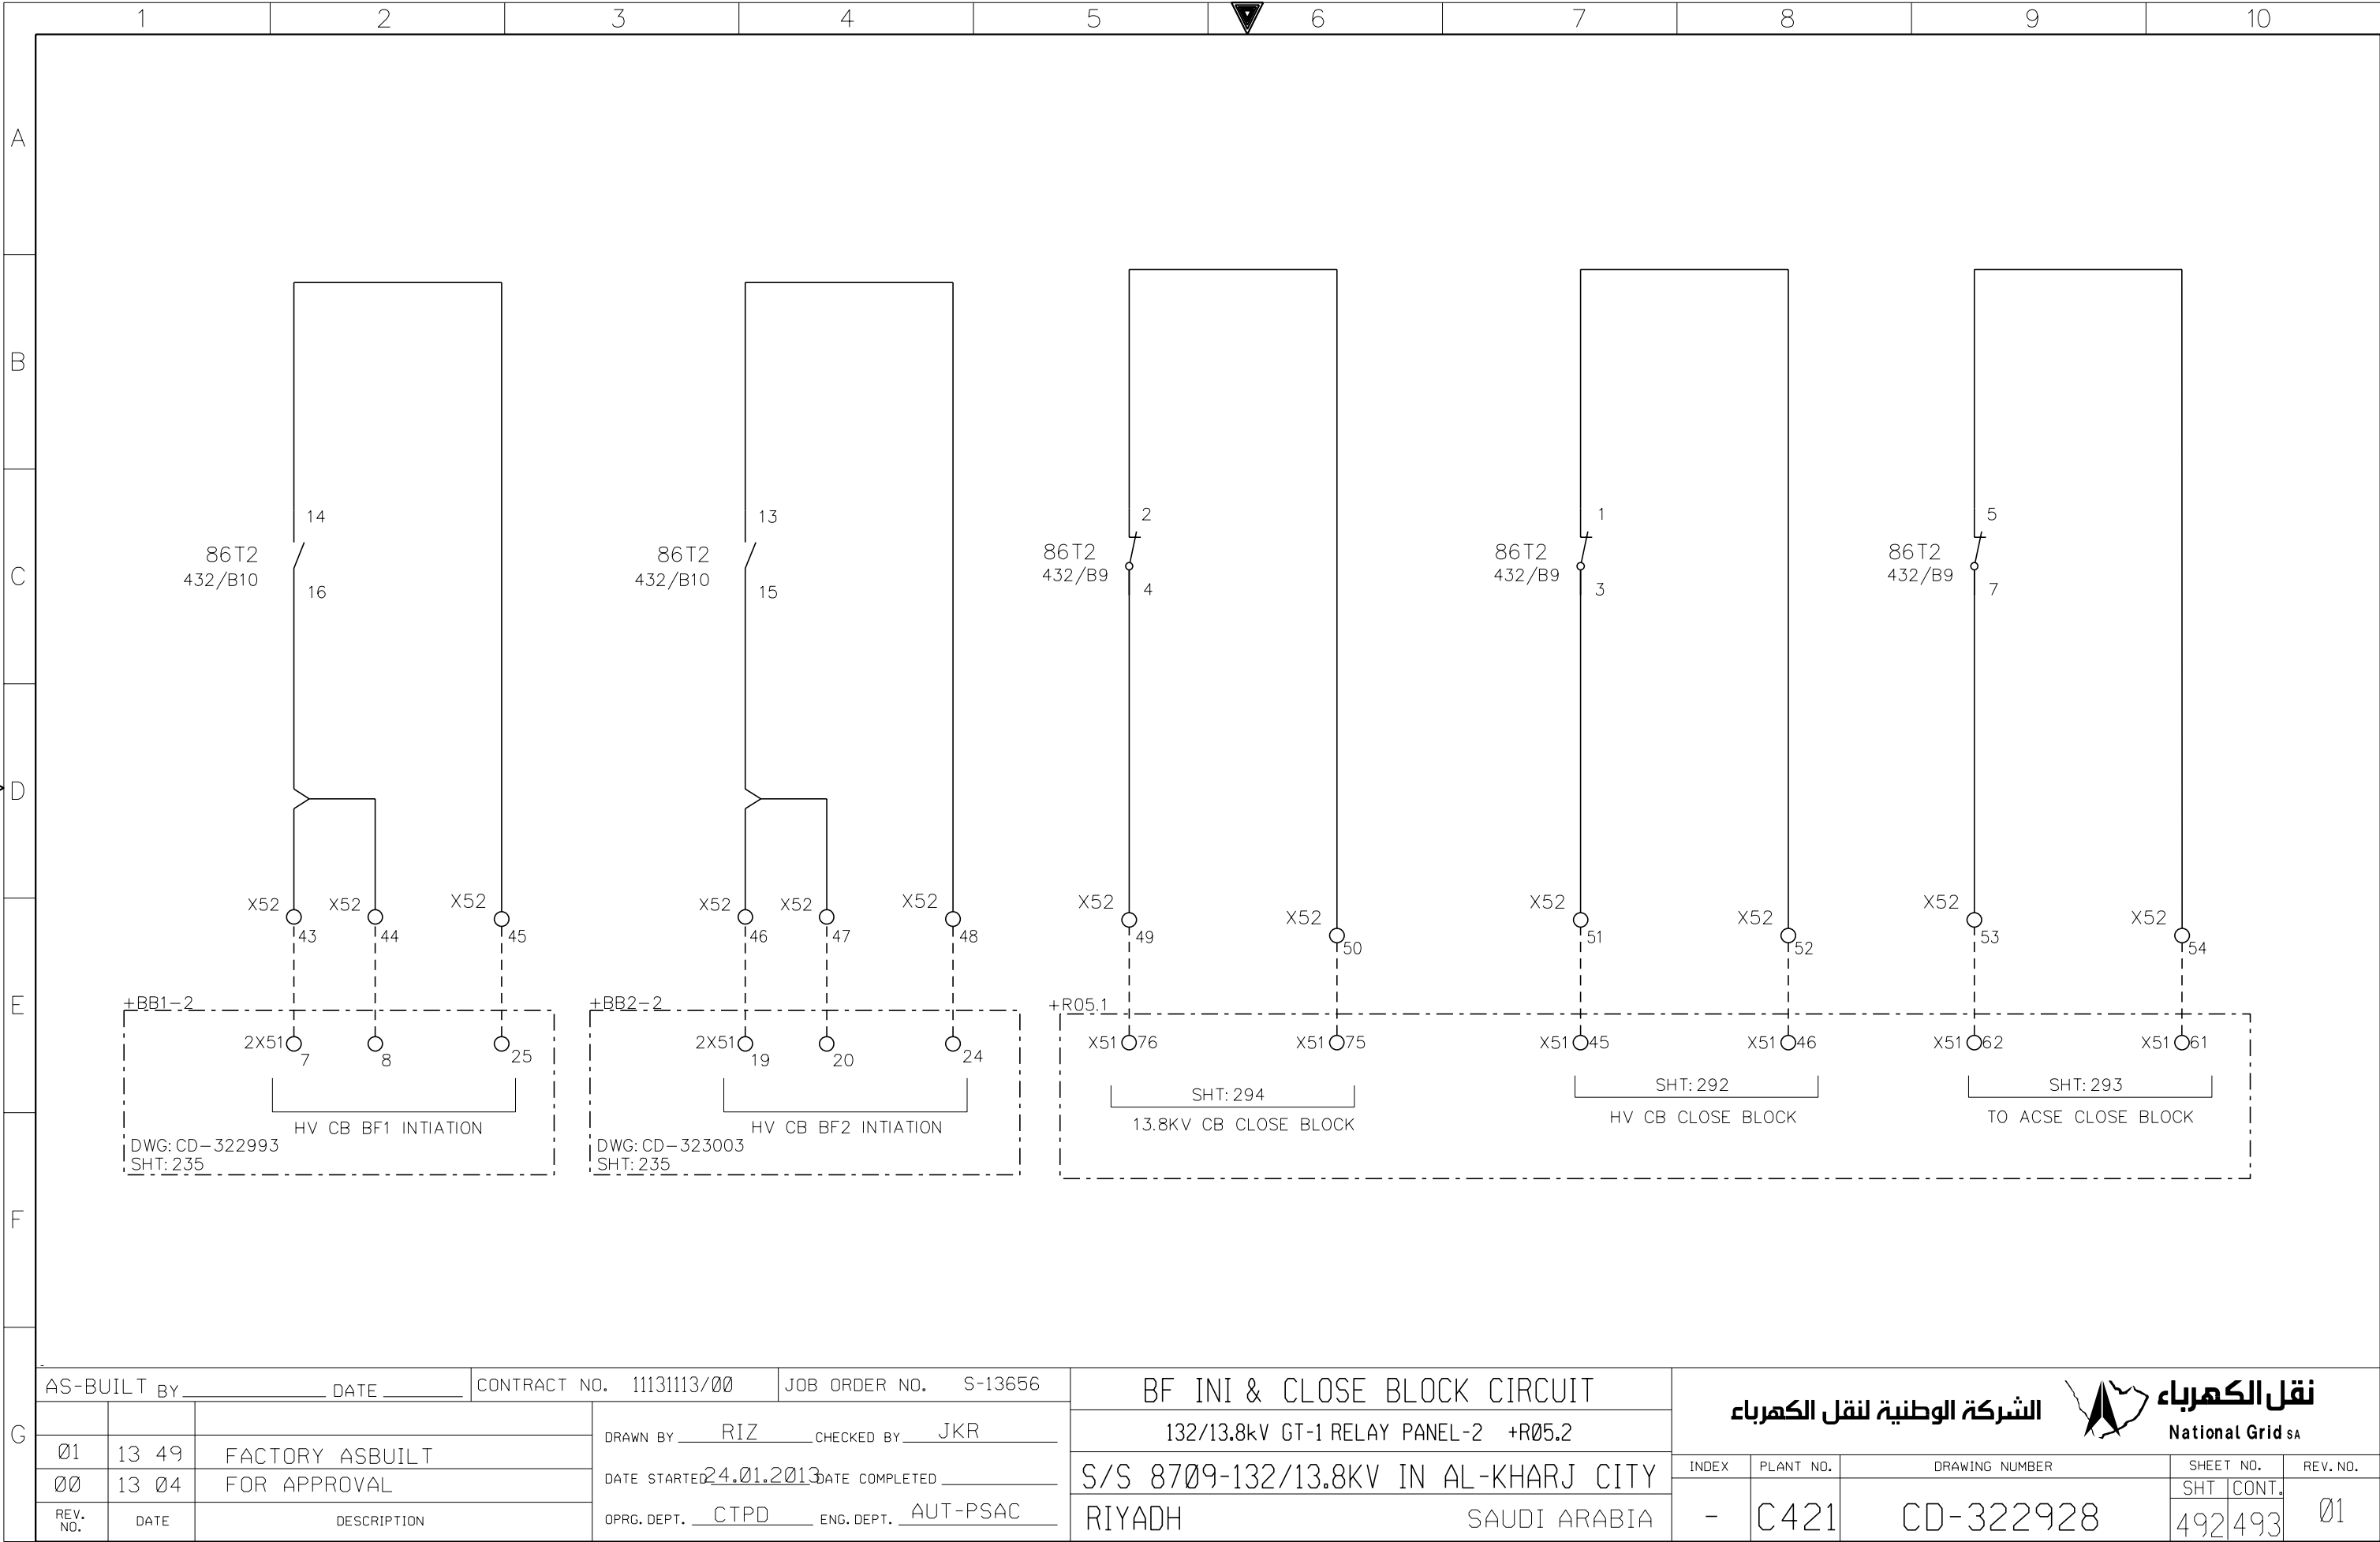


THIS DRAWING AND THE INFORMATION CONTAINED HEREIN ARE THE SOLE PROPERTY OF National Grid SA NO REPRODUCTION IN FULL OR IN PART SHALL BE OBTAINED FROM THIS DOCUMENT WITHOUT THE WRITTEN CONSENT OF ITS OWNER.

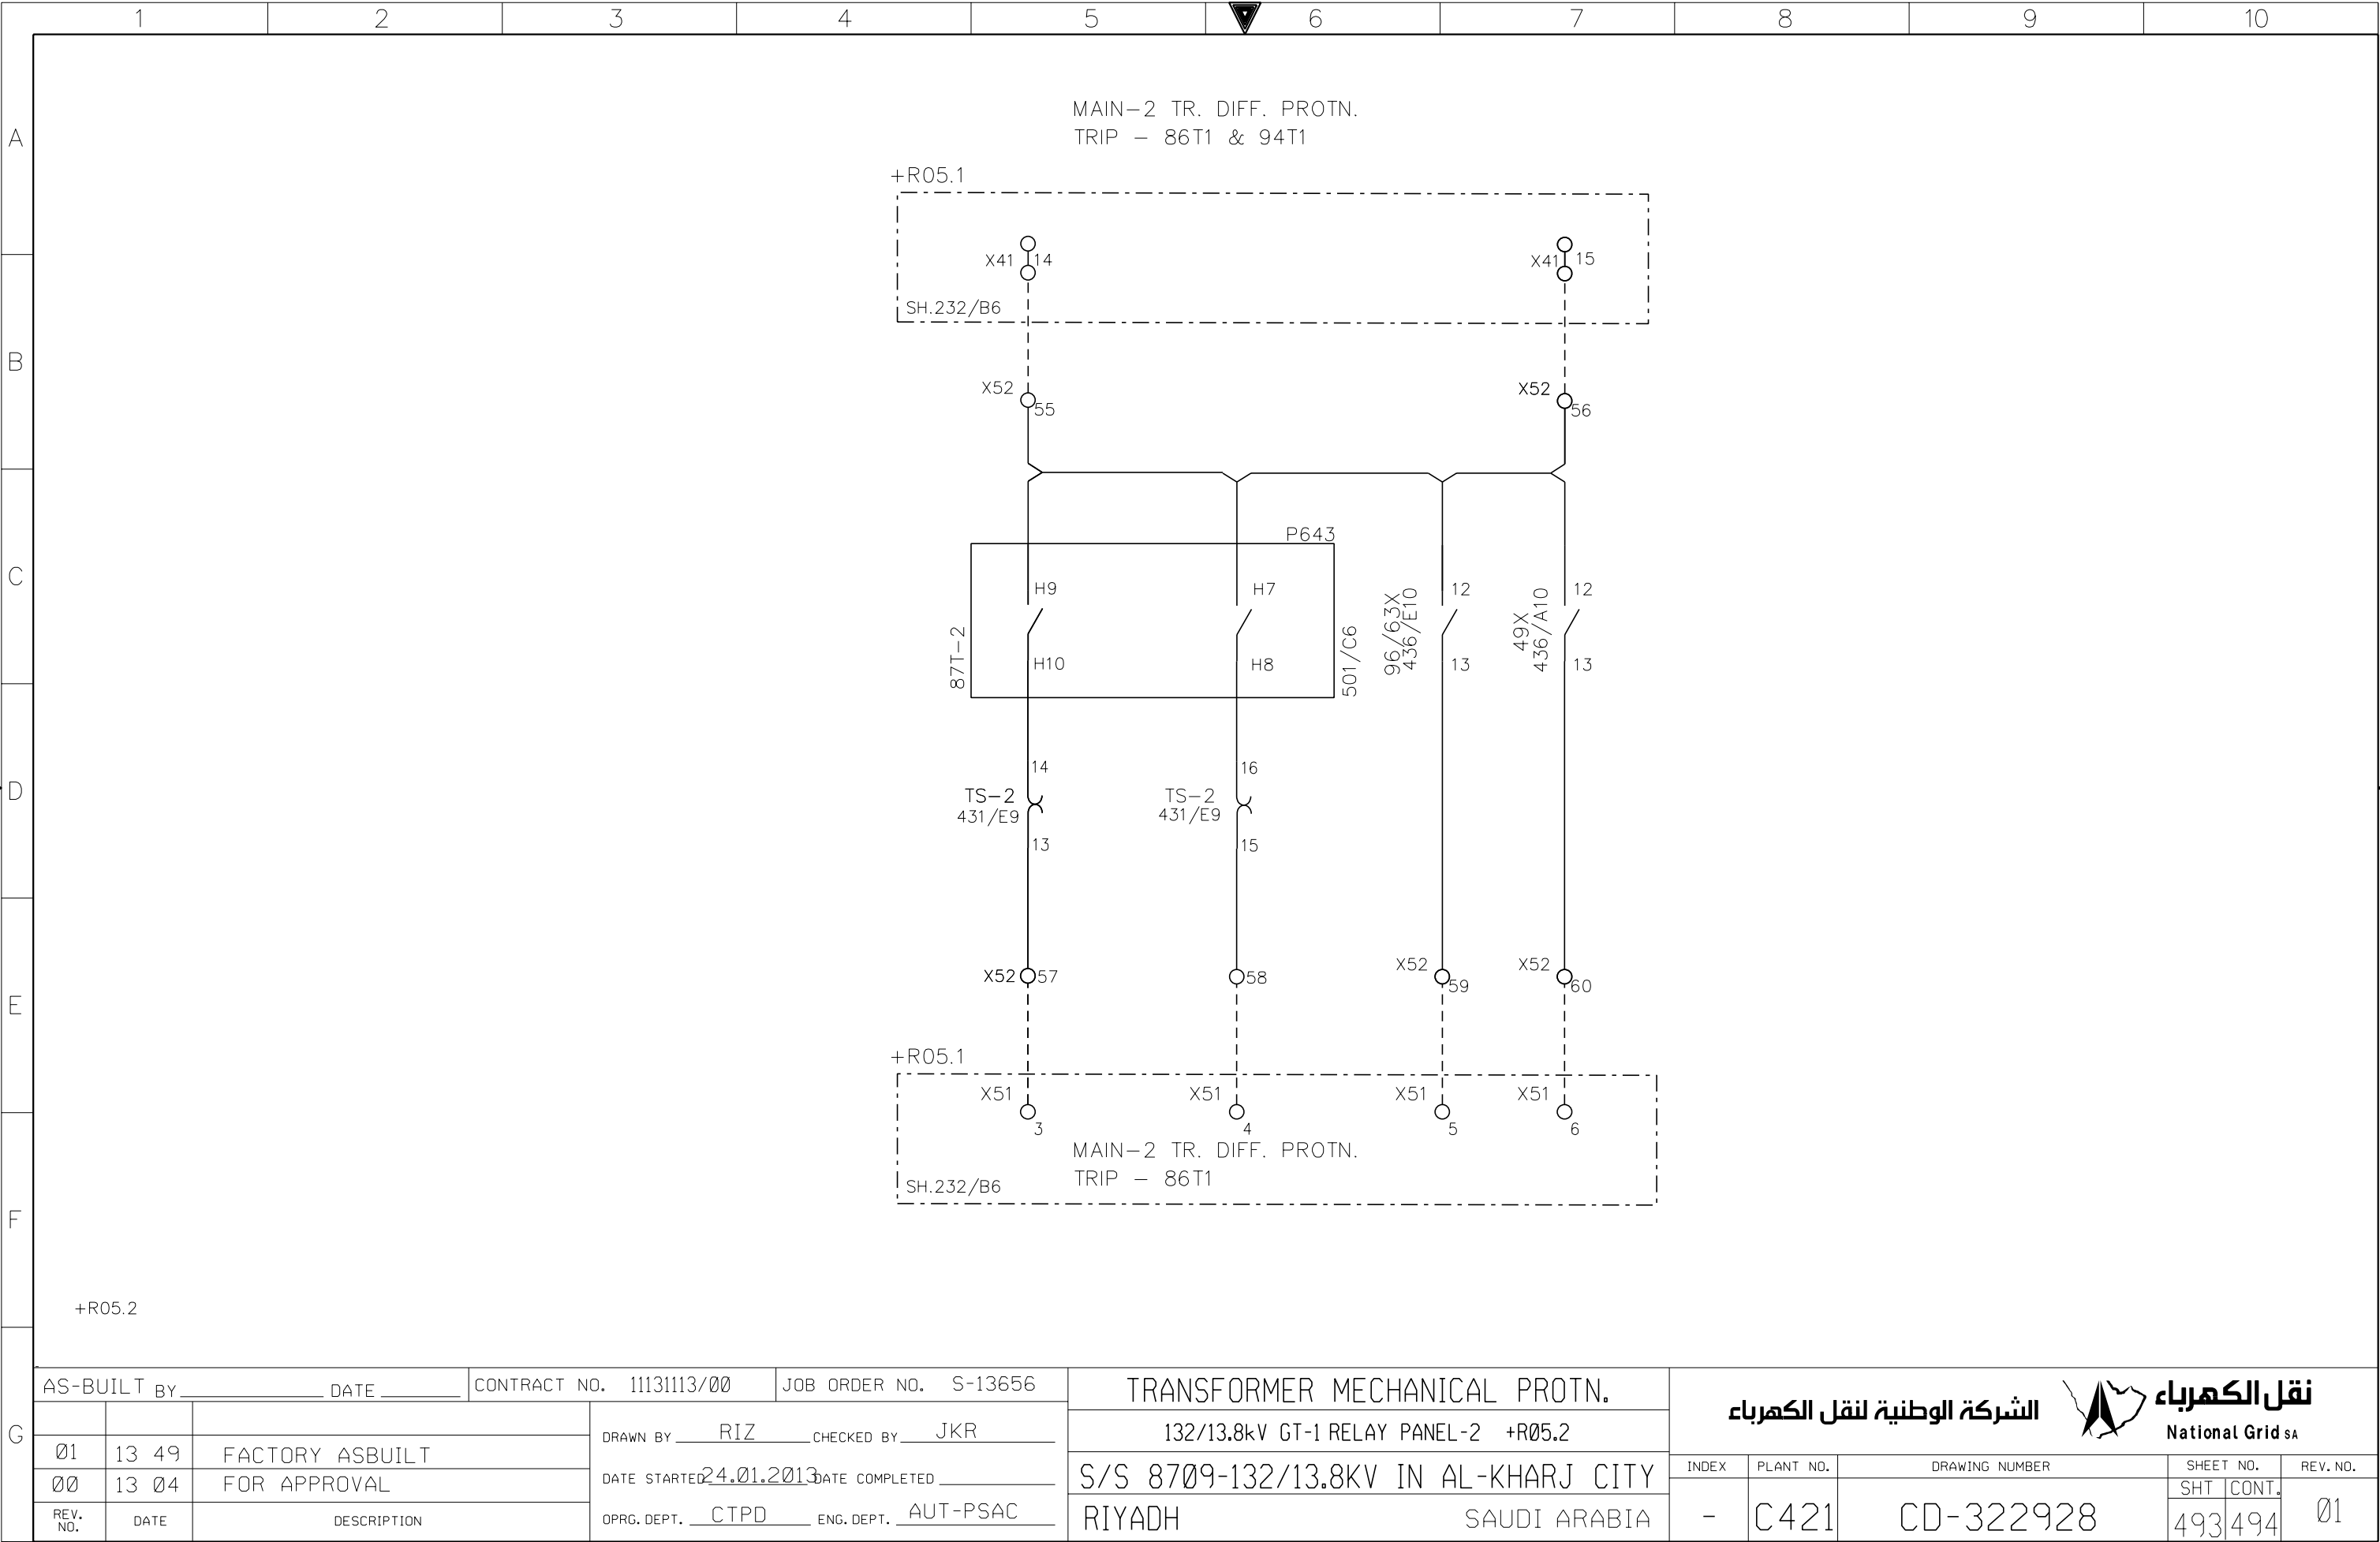


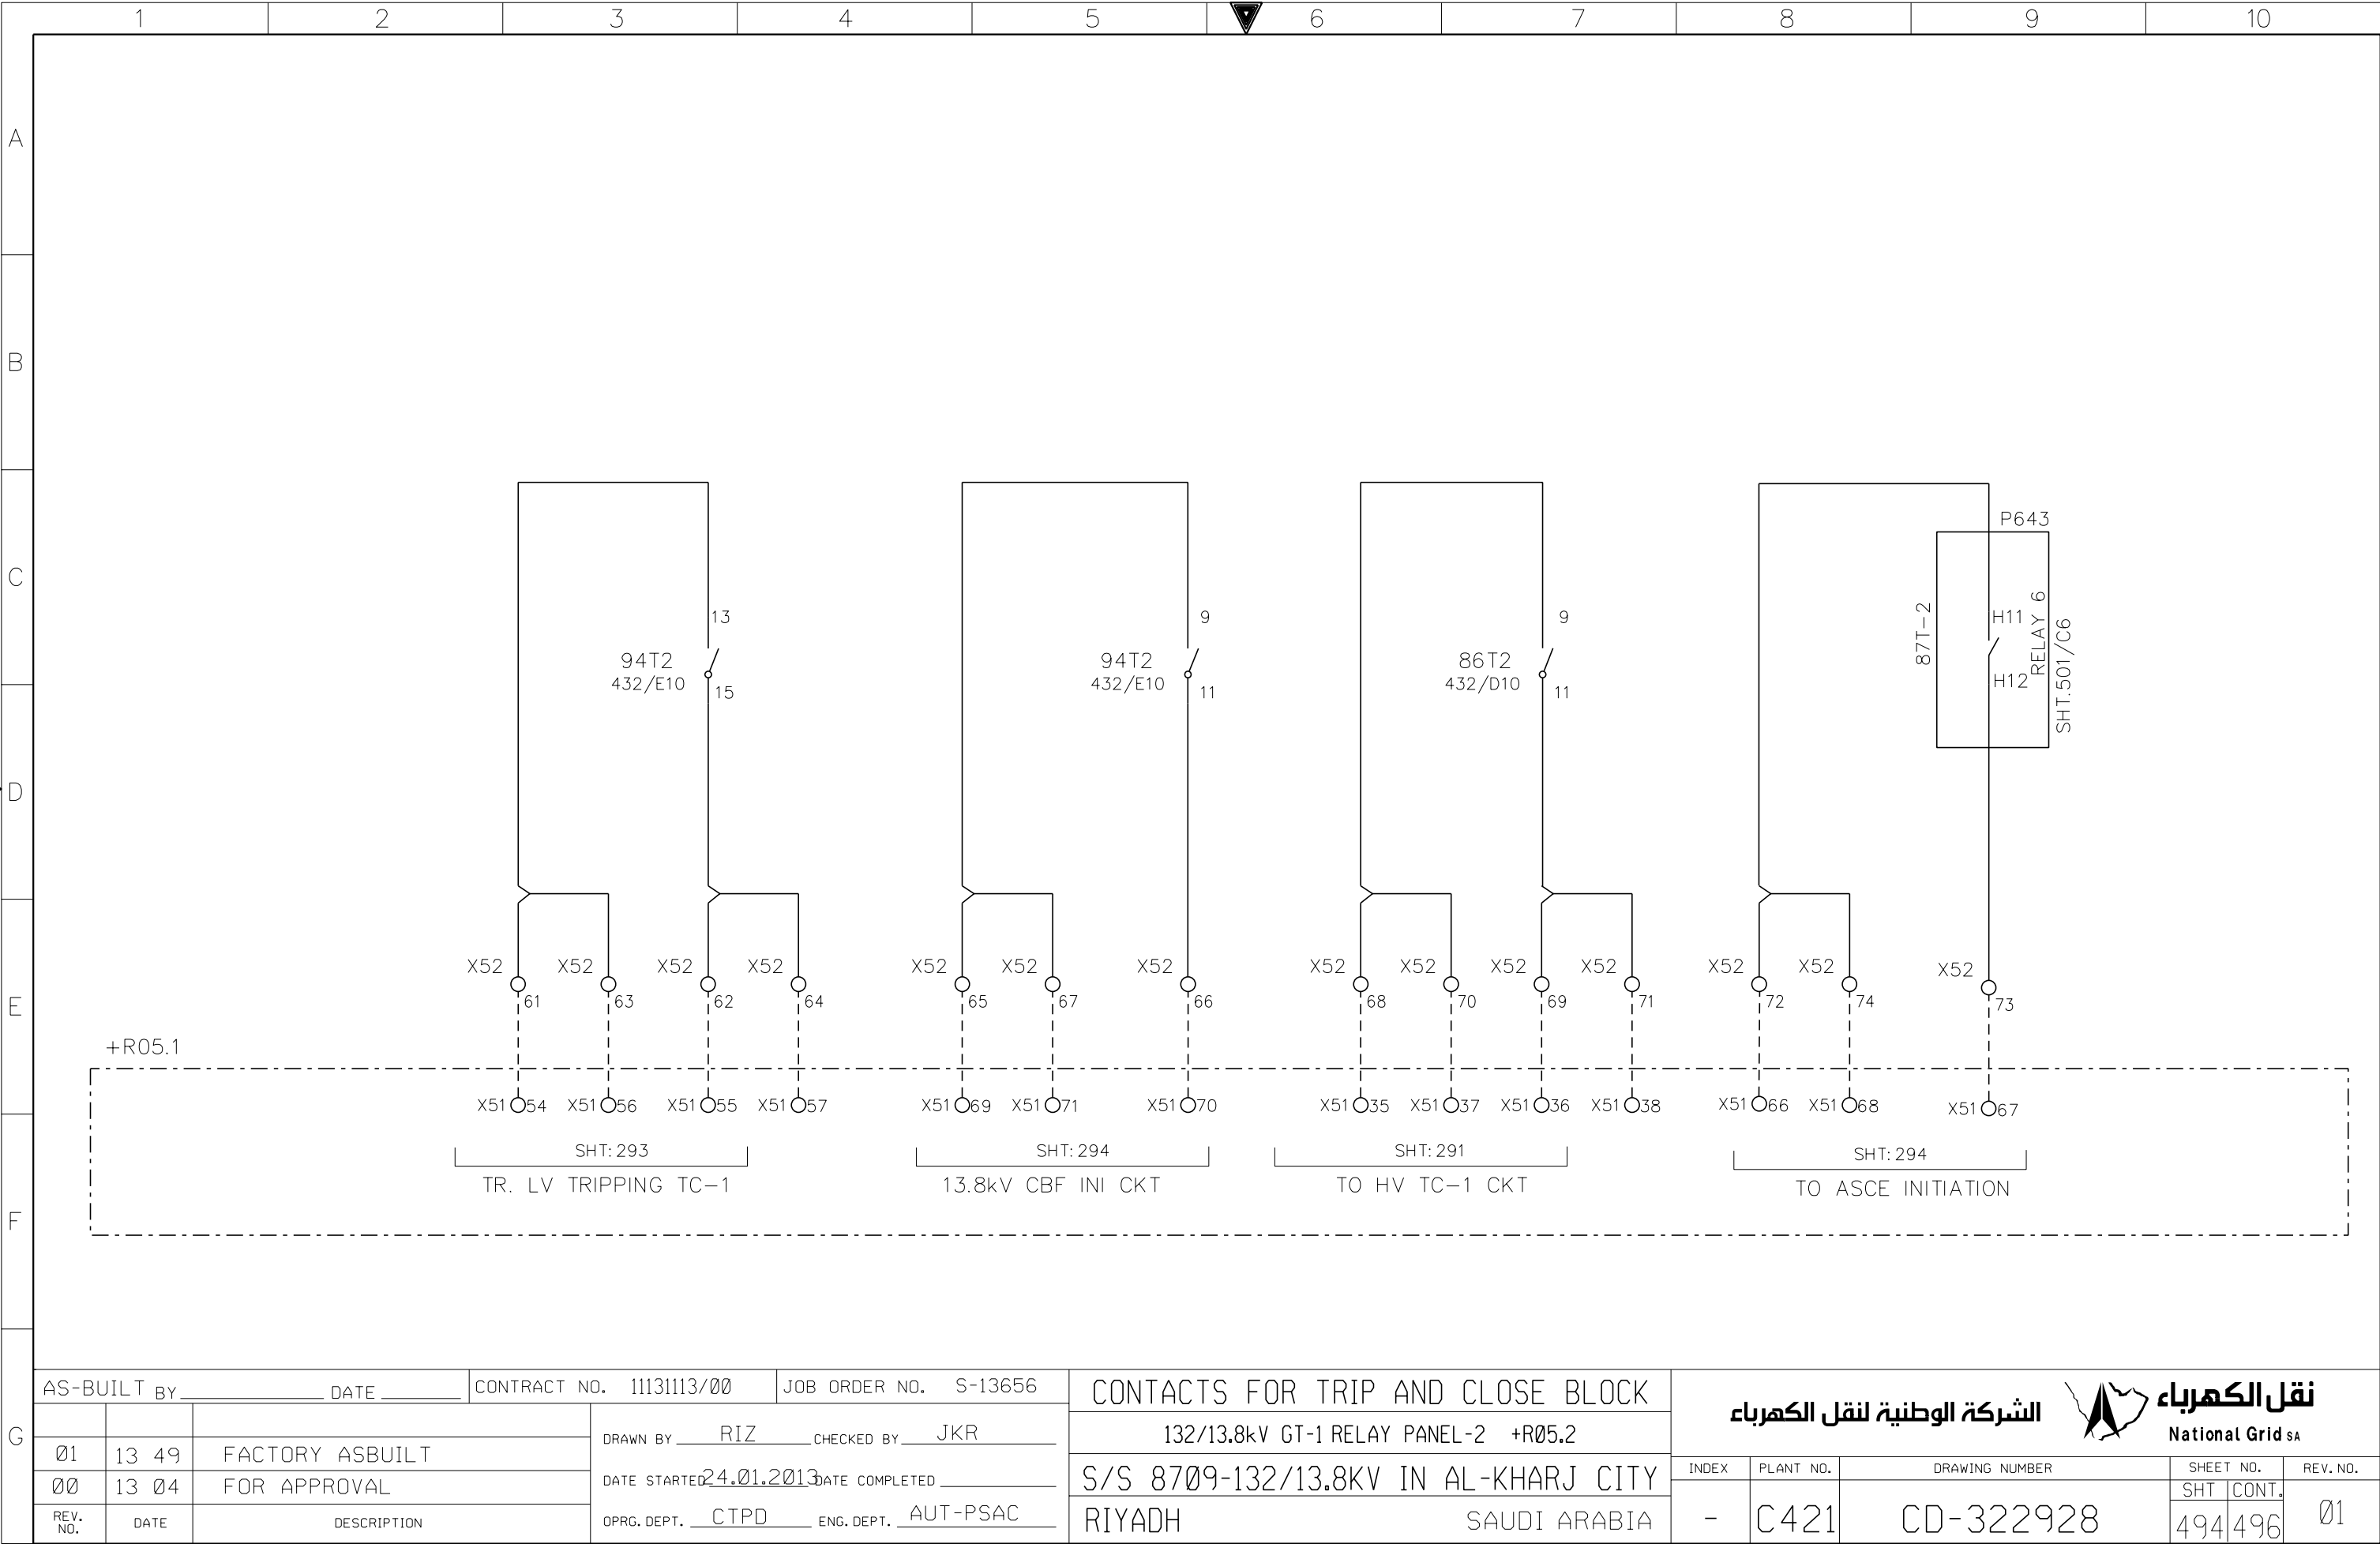



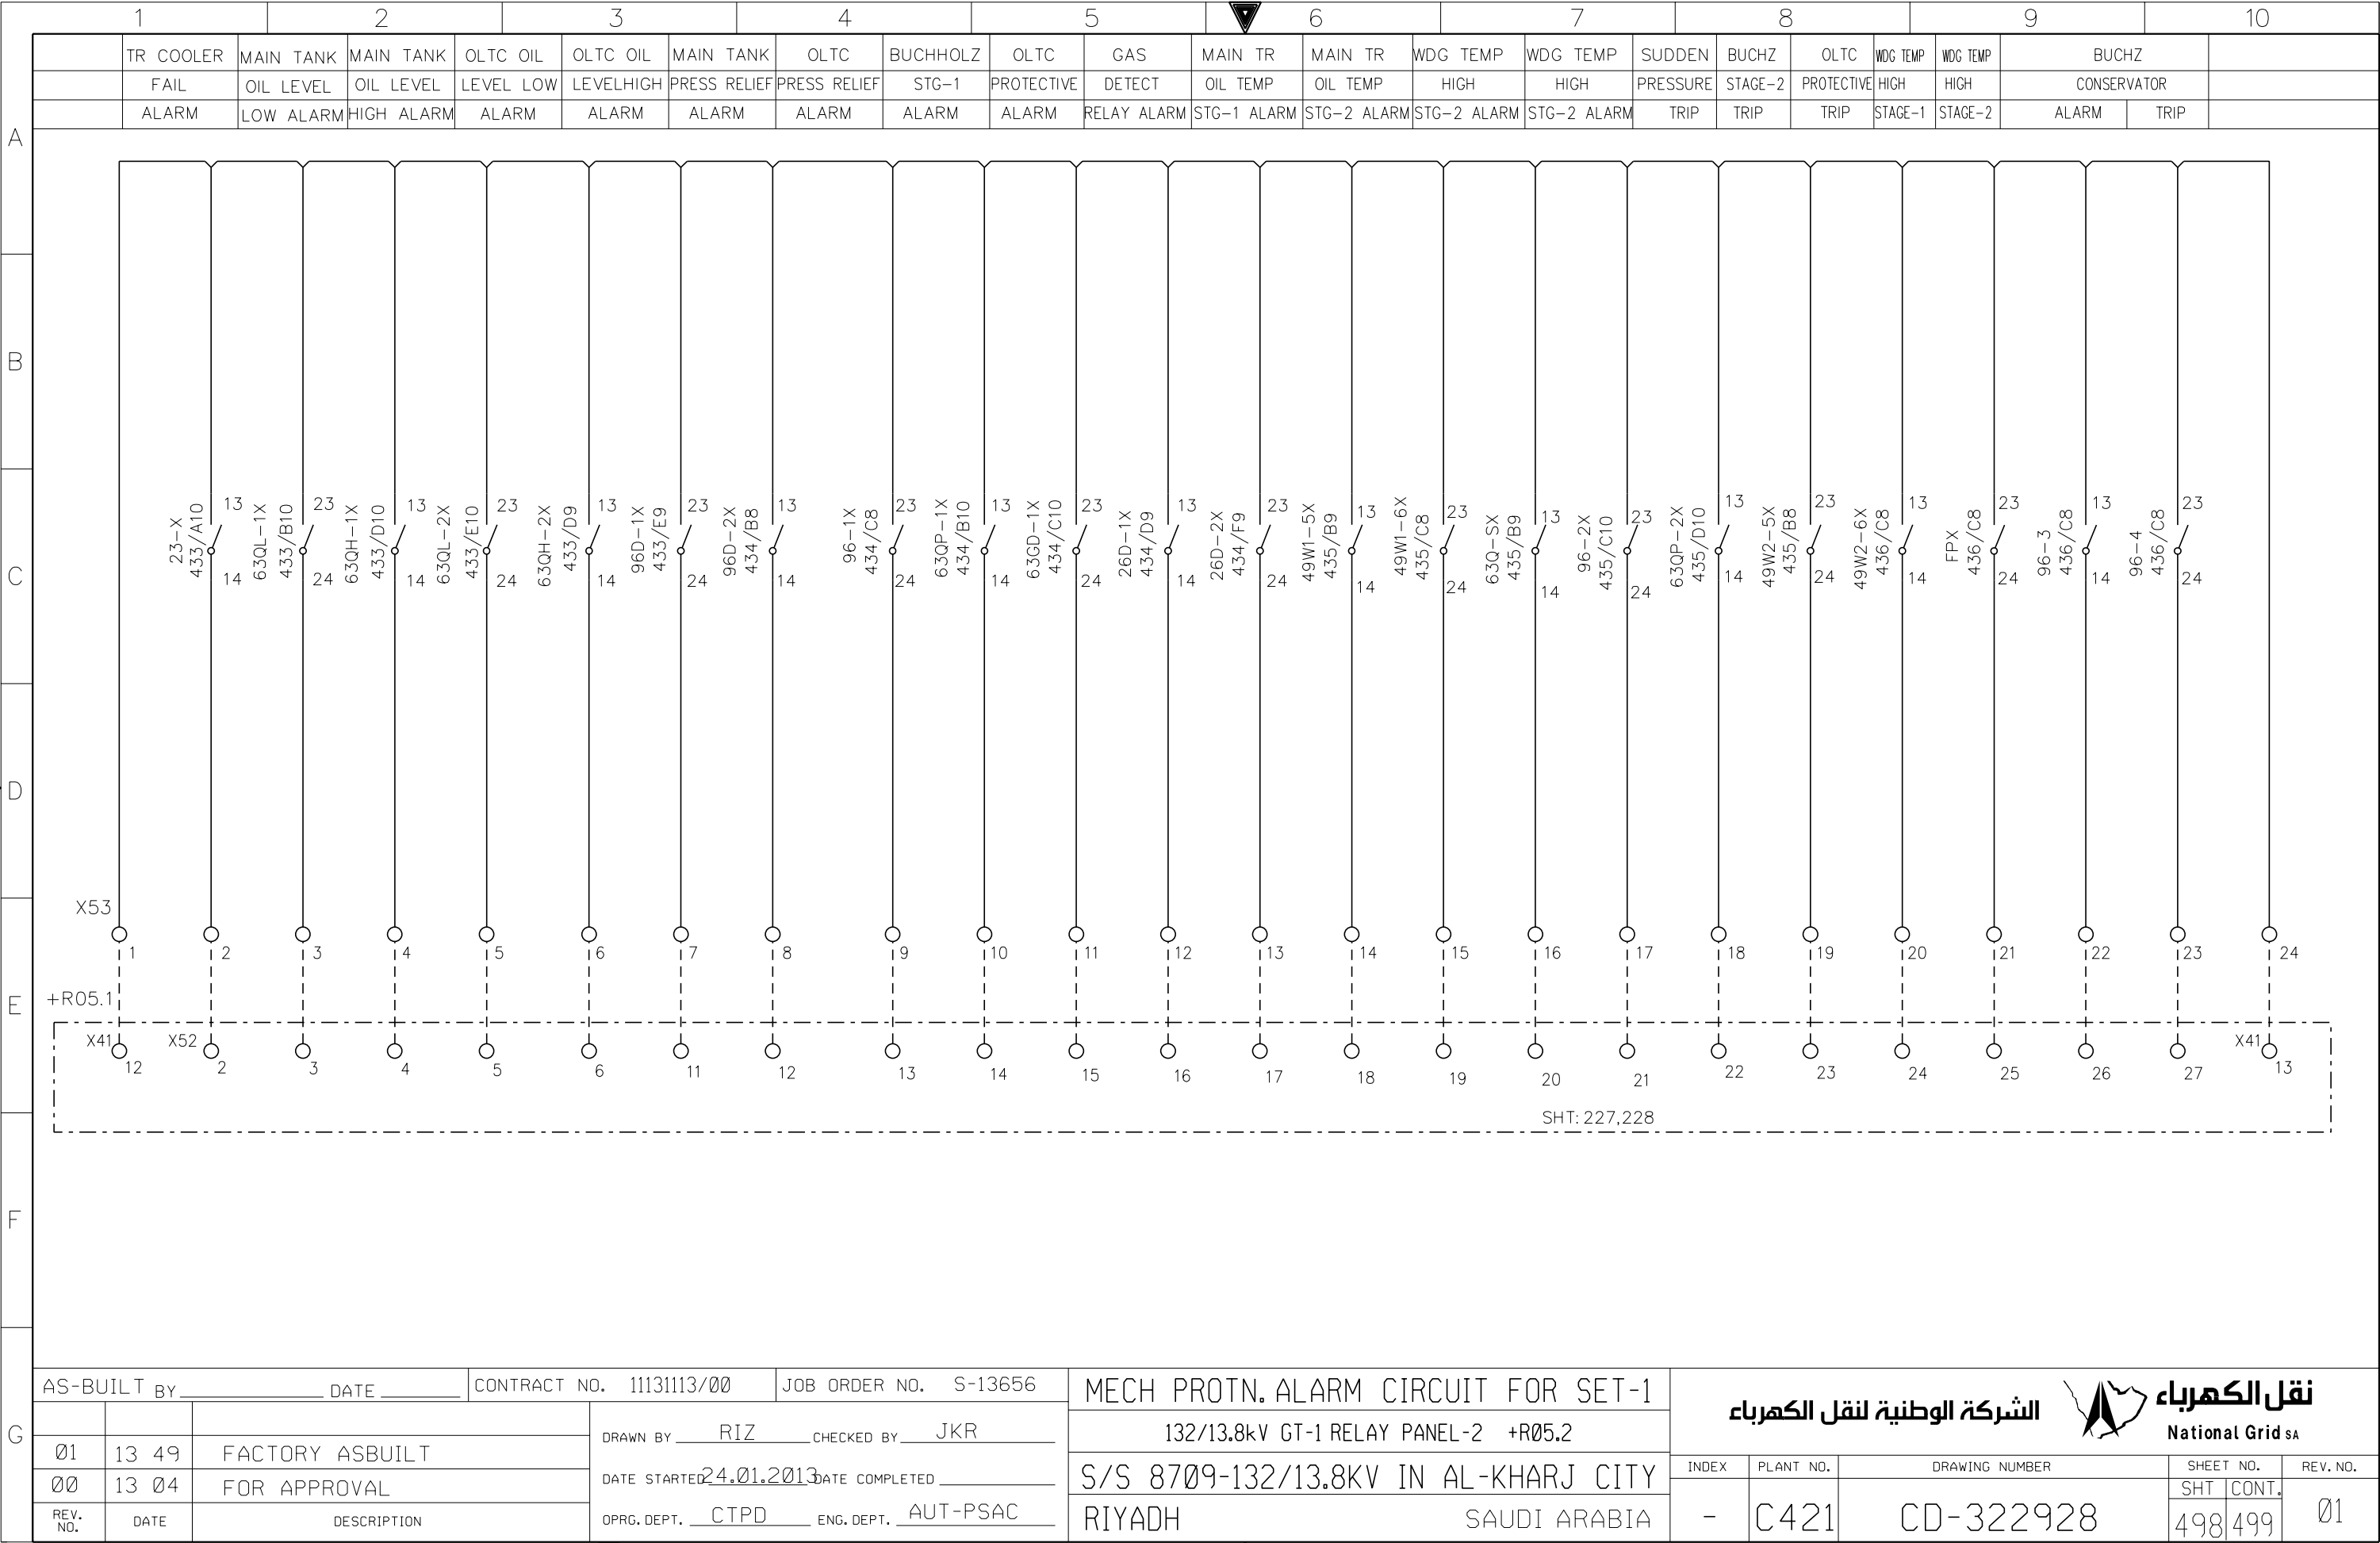

THIS DRAWING AND THE INFORMATION CONTAINED HEREIN ARE THE SOLE PROPERTY OF National Grid SA NO REPRODUCTION IN FULL OR IN PART SHALL BE OBTAINED FROM THIS DOCUMENT WITHOUT THE WRITTEN CONSENT OF ITS OWNER.

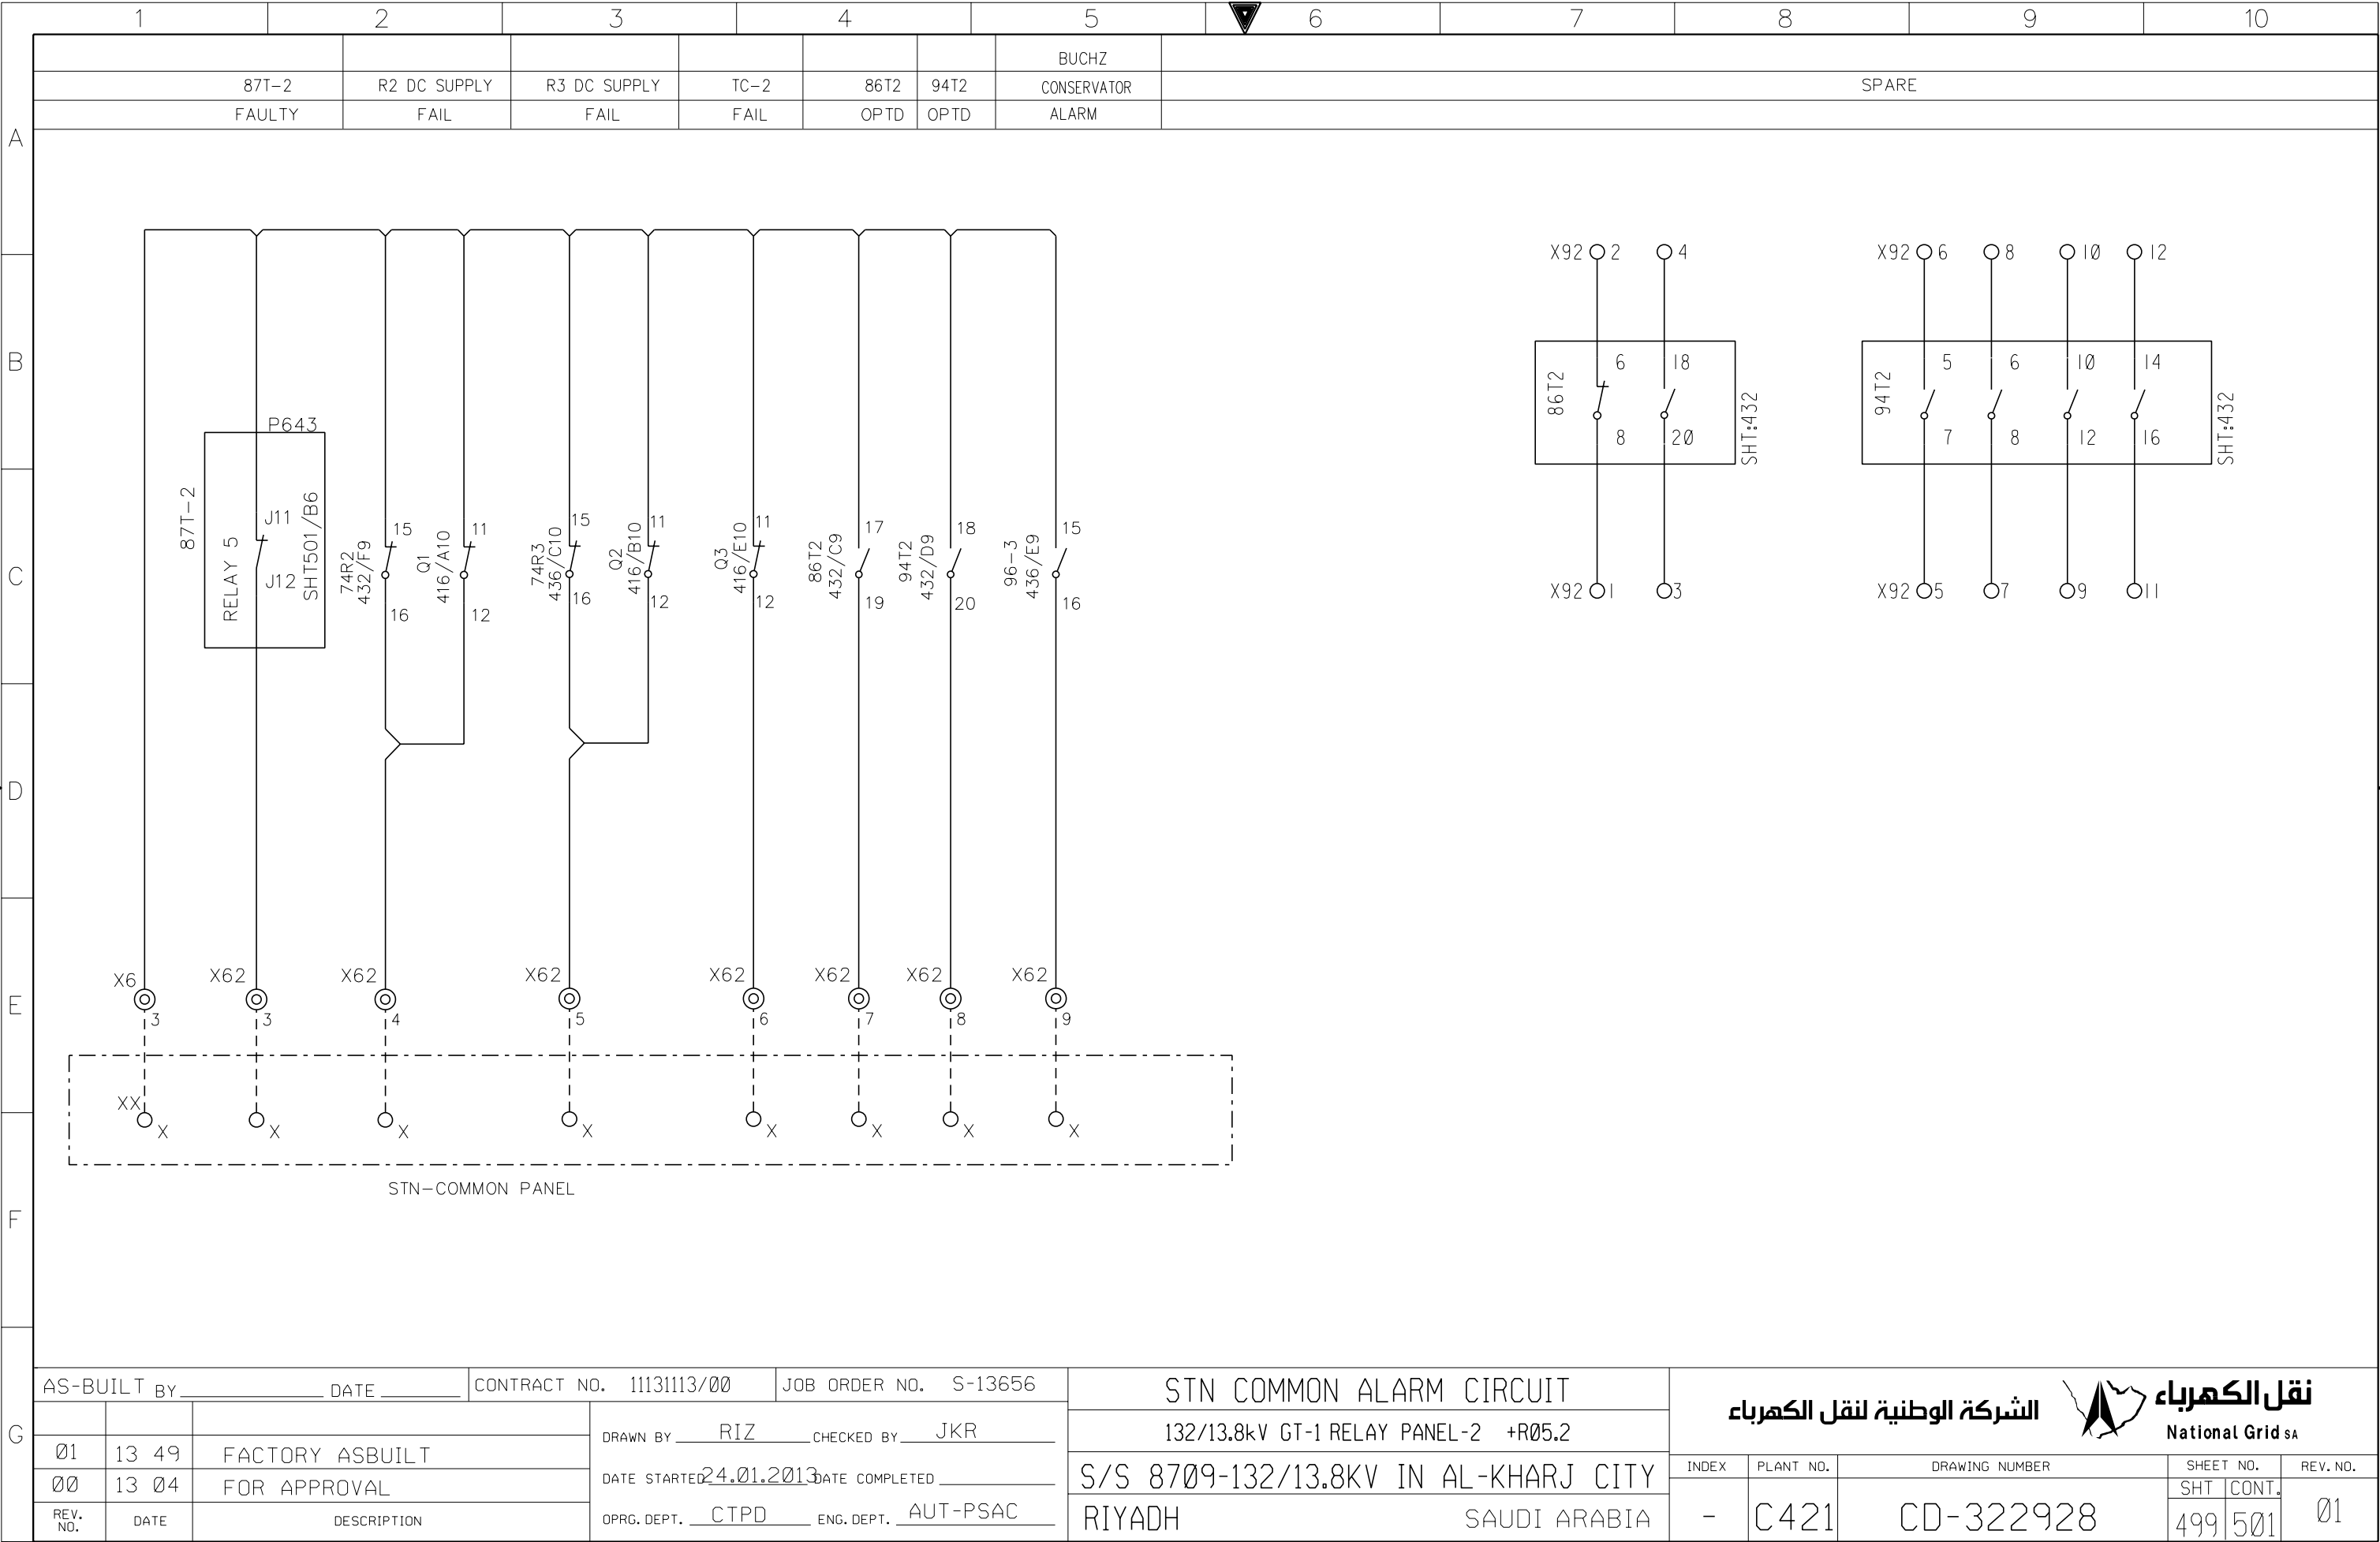







	1	2	3	4	5	6	7	8	9	10																																																																																																																																																																																																																																																																																																																																																																																																																																																																																																																																																																																																																																																																																																																																																																																																																																																																																																																																																																																																																																																																																																																																																																																																																																																								
A	<table><tr><td>REFERENCE</td><td>X3 AC CKT.</td></tr><tr><td>411/A3</td><td>1</td><td></td><td></td><td></td><td>1</td></tr><tr><td>411/A7</td><td>2</td><td></td><td></td><td></td><td>2</td></tr><tr><td>411/A3</td><td>3</td><td></td><td></td><td></td><td>3</td></tr><tr><td>411/A7</td><td>4</td><td></td><td></td><td></td><td>4</td></tr><tr><td>411/B3</td><td>5</td><td></td><td></td><td></td><td>5</td></tr><tr><td>411/B7</td><td>6</td><td></td><td></td><td></td><td>6</td></tr><tr><td>411/B3</td><td>7</td><td></td><td></td><td></td><td>7</td></tr><tr><td>411/B7</td><td>8</td><td></td><td></td><td></td><td>8</td></tr><tr><td>SPARE</td><td>9</td><td></td><td></td><td></td><td>9</td></tr><tr><td>SPARE</td><td>10</td><td></td><td></td><td></td><td>10</td></tr></table>	REFERENCE	X3 AC CKT.	411/A3	1				1	411/A7	2				2	411/A3	3				3	411/A7	4				4	411/B3	5				5	411/B7	6				6	411/B3	7				7	411/B7	8				8	SPARE	9				9	SPARE	10				10	<table><tr><td>REFERENCE</td><td>X1 CT CKTS.</td></tr><tr><td>421/B5</td><td>1</td><td></td><td></td><td></td><td>1</td></tr><tr><td>421/B5</td><td>2</td><td></td><td></td><td></td><td>2</td></tr><tr><td>421/B5</td><td>3</td><td></td><td></td><td></td><td>3</td></tr><tr><td>421/B5</td><td>4</td><td></td><td></td><td></td><td>4</td></tr><tr><td>421/B5</td><td>5</td><td></td><td></td><td></td><td>5</td></tr><tr><td>421/B5</td><td>6</td><td></td><td></td><td></td><td>6</td></tr><tr><td>421/C5</td><td>7</td><td></td><td></td><td></td><td>7</td></tr><tr><td>421/C5</td><td>8</td><td></td><td></td><td></td><td>8</td></tr><tr><td>421/C5</td><td>9</td><td></td><td></td><td></td><td>9</td></tr><tr><td>SPARE</td><td>10</td><td></td><td></td><td></td><td>10</td></tr><tr><td>421/E5</td><td>11</td><td></td><td></td><td></td><td>11</td></tr><tr><td>421/E5</td><td>12</td><td></td><td></td><td></td><td>12</td></tr><tr><td>421/E5</td><td>13</td><td></td><td></td><td></td><td>13</td></tr><tr><td>421/E5</td><td>14</td><td></td><td></td><td></td><td>14</td></tr><tr><td>421/E5</td><td>15</td><td></td><td></td><td></td><td>15</td></tr><tr><td>421/F5</td><td>16</td><td></td><td></td><td></td><td>16</td></tr><tr><td>421/F5</td><td>17</td><td></td><td></td><td></td><td>17</td></tr><tr><td>421/F5</td><td>18</td><td></td><td></td><td></td><td>18</td></tr><tr><td>421/F5</td><td>19</td><td></td><td></td><td></td><td>19</td></tr><tr><td>SPARE</td><td>20</td><td></td><td></td><td></td><td>20</td></tr><tr><td>422/D4</td><td>21</td><td></td><td></td><td><><td>33</td><td></td><td></td><td></td><td>33</td></tr><tr><td>423/D5</td><td>34</td><td></td><td></td><td></td><td>34</td></tr><tr><td>423/D5</td><td>35</td><td></td><td></td><td></td><td>35</td></tr><tr><td>SPARE</td><td>36</td><td></td><td></td><td></td><td>36</td></tr><tr><td>SPARE</td><td>37</td><td></td><td></td><td></td><td>37</td></tr><tr><td>SPARE</td><td>38</td><td></td><td></td><td></td><td>38</td></tr><tr><td>SPARE</td><td>39</td><td></td><td></td><td></td><td>39</td></tr><tr><td>SPARE</td><td>40</td><td></td><td></td><td></td><td>40</td></tr></table>	REFERENCE	X1 CT CKTS.	421/B5	1				1	421/B5	2				2	421/B5	3				3	421/B5	4				4	421/B5	5				5	421/B5	6				6	421/C5	7				7	421/C5	8				8	421/C5	9				9	SPARE	10				10	421/E5	11				11	421/E5	12				12	421/E5	13				13	421/E5	14				14	421/E5	15				15	421/F5	16				16	421/F5	17				17	421/F5	18				18	421/F5	19				19	SPARE	20				20	422/D4	21				21	422/D4	22				22	422/D4	23				23	422/D4	24				24	422/D4	25				25	422/E4	26				26	422/E4	27				27	422/E4	28				28	422/E4	29				29	SPARE	30				30	423/E5	31				31	423/E5	32				32	423/D5	33				33	423/D5	34				34	423/D5	35				35	SPARE	36				36	SPARE	37				37	SPARE	38				38	SPARE	39				39	SPARE	40				40	<table><tr><td>REFERENCE</td><td>X52 CON &amp; PROTN CKTS</td></tr><tr><td>416/B3</td><td>1</td><td></td><td></td><td></td><td>1</td></tr><tr><td>416/B3</td><td>2</td><td></td><td></td><td></td><td>2</td></tr><tr><td>429/D3</td><td>3</td><td></td><td></td><td></td><td>3</td></tr><tr><td>432/D4</td><td>4</td><td></td><td></td><td></td><td>4</td></tr><tr><td>432/D5</td><td>5</td><td></td><td></td><td></td><td>5</td></tr><tr><td>SPARE</td><td>6</td><td></td><td></td><td></td><td>6</td></tr><tr><td>SPARE</td><td>7</td><td></td><td></td><td></td><td>7</td></tr><tr><td>SPARE</td><td>8</td><td></td><td></td><td></td><td>8</td></tr><tr><td>436/D3</td><td>9</td><td></td><td></td><td></td><td>9</td></tr><tr><td>436/D3</td><td>10</td><td></td><td></td><td></td><td>10</td></tr><tr><td>433/D1</td><td>11</td><td></td><td></td><td></td><td>11</td></tr><tr><td>433/D2</td><td>12</td><td></td><td></td><td></td><td>12</td></tr><tr><td>433/D4</td><td>13</td><td></td><td></td><td></td><td>13</td></tr><tr><td>433/D5</td><td>14</td><td></td><td></td><td></td><td>14</td></tr><tr><td>433/D6</td><td>15</td><td></td><td></td><td></td><td>15</td></tr><tr><td>433/D7</td><td>16</td><td></td><td></td><td></td><td>16</td></tr><tr><td>434/D1</td><td>17</td><td></td><td></td><td></td><td>17<2	429/D3	3				3	432/D4	4				4	432/D5	5				5	SPARE	6				6	SPARE	7				7	SPARE	8				8	436/D3	9				9	436/D3	10				10	433/D1	11				11	433/D2	12				12	433/D4	13				13	433/D5	14				14	433/D6	15				15	433/D7	16				16	434/D1	17				17	434/D2	18				18	434/D4	19				19	434/D5	20				20	434/D6	21				21	434/D7	22				22	435/D1	23				23	435/D2	24				24	435/D4	25				25	435/D5	26				26	435/D6	27				27	435/D7	28				28	436/D2	29				29	436/D2	30				30	491/A4	31				31	491/C4	32				32	491/D4	33				33	491/E4	34				34	491/B5	35				35	491/A6	36				36	491/C5	37				37	491/C6	38				38	SPARE	39				39	SPARE	40				40	491/A9	41				41	491/B9	42				42	492/E2	43				33	492/E2	44				44	492/E3	45				45	492/E4	46				46	492/E4	47				47	492/E5	48				48	492/E5	49				49	492/E6	50				50	<table><tr><td>REFERENCE</td><td>X52 CON &amp; PROTN CKTS</td></tr><tr><td>492/E7</td><td>51</td><td></td><td></td><td></td><td>51</td></tr><tr><td>492/E8</td><td>52</td><td></td><td></td><td></td><td>52</td></tr><tr><td>492/E9</td><td>53</td><td></td><td></td><td></td><td>53</td></tr><tr><td>492/E10</td><td>54</td><td></td><td></td><td></td><td>54</td></tr><tr><td>SPARE</td><td>55</td><td></td><td></td><td></td><td>55</td></tr><tr><td>SPARE</td><td>56</td><td></td><td></td><td></td><td>556</td></tr><tr><td>493/E5</td><td>57</td><td></td><td></td><td></td><td>57</td></tr><tr><td>493/E5</td><td>58</td><td></td><td></td><td></td><td>58</td></tr><tr><td>493/E7</td><td>59</td><td></td><td></td><td></td><td>59</td></tr><tr><td>493/E7</td><td>60</td><td></td><td></td><td></td><td>60</td></tr><tr><td>494/E3</td><td>61</td><td></td><td></td><td></td><td>61</td></tr><tr><td>494/E4</td><td>/td><td></td><td></td><td></td><td>85</td></tr><tr><td>SPARE</td><td>86</td><td></td><td></td><td></td><td>86</td></tr><tr><td>SPARE</td><td>87</td><td></td><td></td><td></td><td>87</td></tr><tr><td>SPARE</td><td>88</td><td></td><td></td><td></td><td>88</td></tr><tr><td>SPARE</td><td>89</td><td></td><td></td><td></td><td>89</td></tr><tr><td>SPARE</td><td>90</td><td></td><td></td><td></td><td>90</td></tr></table>	REFERENCE	X52 CON & PROTN CKTS	492/E7	51				51	492/E8	52				52	492/E9	53				53	492/E10	54				54	SPARE	55				55	SPARE	56				556	493/E5	57				57	493/E5	58				58	493/E7	59				59	493/E7	60				60	494/E3	61				61	494/E4	62				62	494/E4	63				63	494/E5	64				64	494/E5	65				65	494/E6	66				66	494/E5	67				67	494/E7	68				68	494/E7	69				69	494/E7	70				70	494/E8	71				71	494/E9	72				72	494/E10	73				73	494/E9	74				74	495/B2	75				75	495/E2	76				76	495/B4	77				77	495/E4	78				78	495/B5	79				79	495/E5	80				80	495/B7	81				81	495/E7	82				88	SPARE	83				83	SPARE	84				84	SPARE	85				85	SPARE	86				86	SPARE	87				87	SPARE	88				88	SPARE	89				89	SPARE	90				90	<table><tr><td>REFERENCE</td><td>X42 DC CKTS.</td></tr><tr><td>416/B3</td><td>1</td><td></td><td></td><td></td><td>1</td></tr><tr><td>416/B3</td><td>2</td><td></td><td></td><td></td><td>2</td></tr><tr><td>416/C3</td><td>3</td><td></td><td></td><td></td><td>3</td></tr><tr><td>416/C3</td><td>4</td><td></td><td></td><td></td><td>4</td></tr><tr><td>416/D3</td><td>5</td><td></td><td></td><td></td><td>5</td></tr><tr><td>416/D3</td><td>6</td><td></td><td></td><td></td><td>6</td></tr><tr><td>429/B3</td><td>7</td><td></td><td></td><td></td><td>7</td></tr><tr><td>SPARE</td><td>8</td><td></td><td></td><td></td><td>8</td></tr><tr><td>SPARE</td><td>9</td><td></td><td></td><td></td><td>9</td></tr><tr><td>SPARE</td><td>10</td><td></td><td></td><td></td><td>10</td></tr><tr><td>432/A4</td><td>11</td><td></td><td></td><td></td><td>11</td></tr><tr><td>432/A5</td><td>12</td><td></td><td></td><td></td><td>12</td></tr><tr><td>433/B2</td><td>13</td><td></td><td></td><td></td><td>13</td></tr><tr><td>436/B2</td><td>14</td><td></td><td></td><td></td><td>14</td></tr><tr><td>432/A1</td><td>15</td><td></td><td></td><td></td><td>15</td></tr><tr><td>SPARE</td><td>16</td><td></td><td></td><td></td><td>16</td></tr><tr><td>SPARE</td><td>17</td><td></td><td></td><td></td><td>17</td></tr><tr><td>437/B4</td><td>18</td><td></td><td></td><td></td><td>18</td></tr><tr><td>437/B4</td><td>19</td><td></td><td></td><td></td><td>19</td></tr><tr><td>SPARE</td><td>20</td><td></td><td></td><td></td><td>20</td></tr></table>	REFERENCE	X42 DC CKTS.	416/B3	1				1	416/B3	2				2	416/C3	3				3	416/C3	4				4	416/D3	5				5	416/D3	6				6	429/B3	7				7	SPARE	8				8	SPARE	9				9	SPARE	10				10	432/A4	11				11	432/A5	12				12	433/B2	13				13	436/B2	14				14	432/A1	15				15	SPARE	16				16	SPARE	17				17	437/B4	18				18	437/B4	19				19	SPARE	20				20	<table><tr><td>REFERENCE</td><td>X53 CON &amp; PROTN CKTS</td></tr><tr><td>498/E1</td><td>1</td><td></td><td></td><td></td><td>1</td></tr><tr><td>498/E1</td><td>2</td><td></td><td></td><td></td><td>2</td></tr><tr><td>498/E2</td><td>3</td><td></td><td></td><td></td><td>3</td></tr><tr><td>498/E2</td><td>4</td><td></td><td></td><td></td><td>4</td></tr><tr><td>498/E2</td><td>5</td><td></td><td></td><td></td><td>5</td></tr><tr><td>498/E3</td><td>6</td><td></td><td></td><td></td><td>6</td></tr><tr><td>498/E3</td><td>7</td><td></td><td></td><td></td><td>7</td></tr><tr><td>498/E4</td><td>8</td><td></td><td></td><td></td><td>8</td></tr><tr><td>498/E4</td><td>9</td><td></td><td></td><td></td><td>9</td></tr><tr><td>498/E4</td><td>10</td><td></td><td></td><td></td><td>10</td></tr><tr><td>498/E5</td><td>11</td><td></td><td></td><td></td><td>11</td></tr><tr><td>498/E5</td><td>12</td><td></td><td></td><td></td><td>12</td></tr><tr><td>498/E6</td><td>13</td><td></td><td></td><td></td><td>13</td></tr><tr><td>498/E6</td><td>14</td><td></td><td></td><td></td><td>14</td></tr><tr><td>498/E6</td><td>15</td><td></td><td></td><td></td><td>15</td></tr><tr><td>498/E7</td><td>16</td><td></td><td></td><td></td><td>16</td></tr><tr><td>498/E7</td><td>17</td><td></td><td></td><tdd></tr></table>	REFERENCE	X53 CON & PROTN CKTS	498/E1	1				1	498/E1	2				2	498/E2	3				3	498/E2	4				4	498/E2	5				5	498/E3	6				6	498/E3	7				7	498/E4	8				8	498/E4	9				9	498/E4	10				10	498/E5	11				11	498/E5	12				12	498/E6	13				13	498/E6	14				14	498/E6	15				15	498/E7	16				16	498/E7	17				17	498/E8	18				18	498/E8	19				19	498/E8	20				20	498/E8	21				21	498/E9	22				22	498/E10	23				23	498/E10	24				24	SPARE	25				25	SPARE	26				26	SPARE	27				27	SPARE	28				28	SPARE	29				29	SPARE	30				30	SPARE	31				31	SPARE	32				32	SPARE	33				33	SPARE	34				34	SPARE	35				35	SPARE	36				36	SPARE	37				37	SPARE	38				38	SPARE	39				39	SPARE	40				40
REFERENCE	X3 AC CKT.																																																																																																																																																																																																																																																																																																																																																																																																																																																																																																																																																																																																																																																																																																																																																																																																																																																																																																																																																																																																																																																																																																																																																																																																																																																																	
411/A3	1				1																																																																																																																																																																																																																																																																																																																																																																																																																																																																																																																																																																																																																																																																																																																																																																																																																																																																																																																																																																																																																																																																																																																																																																																																																																																													
411/A7	2				2																																																																																																																																																																																																																																																																																																																																																																																																																																																																																																																																																																																																																																																																																																																																																																																																																																																																																																																																																																																																																																																																																																																																																																																																																																																													
411/A3	3				3																																																																																																																																																																																																																																																																																																																																																																																																																																																																																																																																																																																																																																																																																																																																																																																																																																																																																																																																																																																																																																																																																																																																																																																																																																																													
411/A7	4				4																																																																																																																																																																																																																																																																																																																																																																																																																																																																																																																																																																																																																																																																																																																																																																																																																																																																																																																																																																																																																																																																																																																																																																																																																																																													
411/B3	5				5																																																																																																																																																																																																																																																																																																																																																																																																																																																																																																																																																																																																																																																																																																																																																																																																																																																																																																																																																																																																																																																																																																																																																																																																																																																													
411/B7	6				6																																																																																																																																																																																																																																																																																																																																																																																																																																																																																																																																																																																																																																																																																																																																																																																																																																																																																																																																																																																																																																																																																																																																																																																																																																																													
411/B3	7				7																																																																																																																																																																																																																																																																																																																																																																																																																																																																																																																																																																																																																																																																																																																																																																																																																																																																																																																																																																																																																																																																																																																																																																																																																																																													
411/B7	8				8																																																																																																																																																																																																																																																																																																																																																																																																																																																																																																																																																																																																																																																																																																																																																																																																																																																																																																																																																																																																																																																																																																																																																																																																																																																													
SPARE	9				9																																																																																																																																																																																																																																																																																																																																																																																																																																																																																																																																																																																																																																																																																																																																																																																																																																																																																																																																																																																																																																																																																																																																																																																																																																																													
SPARE	10				10																																																																																																																																																																																																																																																																																																																																																																																																																																																																																																																																																																																																																																																																																																																																																																																																																																																																																																																																																																																																																																																																																																																																																																																																																																																													
REFERENCE	X1 CT CKTS.																																																																																																																																																																																																																																																																																																																																																																																																																																																																																																																																																																																																																																																																																																																																																																																																																																																																																																																																																																																																																																																																																																																																																																																																																																																																	
421/B5	1				1																																																																																																																																																																																																																																																																																																																																																																																																																																																																																																																																																																																																																																																																																																																																																																																																																																																																																																																																																																																																																																																																																																																																																																																																																																																													
421/B5	2				2																																																																																																																																																																																																																																																																																																																																																																																																																																																																																																																																																																																																																																																																																																																																																																																																																																																																																																																																																																																																																																																																																																																																																																																																																																																													
421/B5	3				3																																																																																																																																																																																																																																																																																																																																																																																																																																																																																																																																																																																																																																																																																																																																																																																																																																																																																																																																																																																																																																																																																																																																																																																																																																																													
421/B5	4				4																																																																																																																																																																																																																																																																																																																																																																																																																																																																																																																																																																																																																																																																																																																																																																																																																																																																																																																																																																																																																																																																																																																																																																																																																																																													
421/B5	5				5																																																																																																																																																																																																																																																																																																																																																																																																																																																																																																																																																																																																																																																																																																																																																																																																																																																																																																																																																																																																																																																																																																																																																																																																																																																													
421/B5	6				6																																																																																																																																																																																																																																																																																																																																																																																																																																																																																																																																																																																																																																																																																																																																																																																																																																																																																																																																																																																																																																																																																																																																																																																																																																																													
421/C5	7				7																																																																																																																																																																																																																																																																																																																																																																																																																																																																																																																																																																																																																																																																																																																																																																																																																																																																																																																																																																																																																																																																																																																																																																																																																																																													
421/C5	8				8																																																																																																																																																																																																																																																																																																																																																																																																																																																																																																																																																																																																																																																																																																																																																																																																																																																																																																																																																																																																																																																																																																																																																																																																																																																													
421/C5	9				9																																																																																																																																																																																																																																																																																																																																																																																																																																																																																																																																																																																																																																																																																																																																																																																																																																																																																																																																																																																																																																																																																																																																																																																																																																																													
SPARE	10				10																																																																																																																																																																																																																																																																																																																																																																																																																																																																																																																																																																																																																																																																																																																																																																																																																																																																																																																																																																																																																																																																																																																																																																																																																																																													
421/E5	11				11																																																																																																																																																																																																																																																																																																																																																																																																																																																																																																																																																																																																																																																																																																																																																																																																																																																																																																																																																																																																																																																																																																																																																																																																																																																													
421/E5	12				12																																																																																																																																																																																																																																																																																																																																																																																																																																																																																																																																																																																																																																																																																																																																																																																																																																																																																																																																																																																																																																																																																																																																																																																																																																																													
421/E5	13				13																																																																																																																																																																																																																																																																																																																																																																																																																																																																																																																																																																																																																																																																																																																																																																																																																																																																																																																																																																																																																																																																																																																																																																																																																																																													
421/E5	14				14																																																																																																																																																																																																																																																																																																																																																																																																																																																																																																																																																																																																																																																																																																																																																																																																																																																																																																																																																																																																																																																																																																																																																																																																																																																													
421/E5	15				15																																																																																																																																																																																																																																																																																																																																																																																																																																																																																																																																																																																																																																																																																																																																																																																																																																																																																																																																																																																																																																																																																																																																																																																																																																																													
421/F5	16				16																																																																																																																																																																																																																																																																																																																																																																																																																																																																																																																																																																																																																																																																																																																																																																																																																																																																																																																																																																																																																																																																																																																																																																																																																																																													
421/F5	17				17																																																																																																																																																																																																																																																																																																																																																																																																																																																																																																																																																																																																																																																																																																																																																																																																																																																																																																																																																																																																																																																																																																																																																																																																																																																													
421/F5	18				18																																																																																																																																																																																																																																																																																																																																																																																																																																																																																																																																																																																																																																																																																																																																																																																																																																																																																																																																																																																																																																																																																																																																																																																																																																																													
421/F5	19				19																																																																																																																																																																																																																																																																																																																																																																																																																																																																																																																																																																																																																																																																																																																																																																																																																																																																																																																																																																																																																																																																																																																																																																																																																																																													
SPARE	20				20																																																																																																																																																																																																																																																																																																																																																																																																																																																																																																																																																																																																																																																																																																																																																																																																																																																																																																																																																																																																																																																																																																																																																																																																																																																													
422/D4	21				21																																																																																																																																																																																																																																																																																																																																																																																																																																																																																																																																																																																																																																																																																																																																																																																																																																																																																																																																																																																																																																																																																																																																																																																																																																																													
422/D4	22				22																																																																																																																																																																																																																																																																																																																																																																																																																																																																																																																																																																																																																																																																																																																																																																																																																																																																																																																																																																																																																																																																																																																																																																																																																																																													
422/D4	23				23																																																																																																																																																																																																																																																																																																																																																																																																																																																																																																																																																																																																																																																																																																																																																																																																																																																																																																																																																																																																																																																																																																																																																																																																																																																													
422/D4	24				24																																																																																																																																																																																																																																																																																																																																																																																																																																																																																																																																																																																																																																																																																																																																																																																																																																																																																																																																																																																																																																																																																																																																																																																																																																																													
422/D4	25				25																																																																																																																																																																																																																																																																																																																																																																																																																																																																																																																																																																																																																																																																																																																																																																																																																																																																																																																																																																																																																																																																																																																																																																																																																																																													
422/E4	26				26																																																																																																																																																																																																																																																																																																																																																																																																																																																																																																																																																																																																																																																																																																																																																																																																																																																																																																																																																																																																																																																																																																																																																																																																																																																													
422/E4	27				27																																																																																																																																																																																																																																																																																																																																																																																																																																																																																																																																																																																																																																																																																																																																																																																																																																																																																																																																																																																																																																																																																																																																																																																																																																																													
422/E4	28				28																																																																																																																																																																																																																																																																																																																																																																																																																																																																																																																																																																																																																																																																																																																																																																																																																																																																																																																																																																																																																																																																																																																																																																																																																																																													
422/E4	29				29																																																																																																																																																																																																																																																																																																																																																																																																																																																																																																																																																																																																																																																																																																																																																																																																																																																																																																																																																																																																																																																																																																																																																																																																																																																													
SPARE	30				30																																																																																																																																																																																																																																																																																																																																																																																																																																																																																																																																																																																																																																																																																																																																																																																																																																																																																																																																																																																																																																																																																																																																																																																																																																																													
423/E5	31				31																																																																																																																																																																																																																																																																																																																																																																																																																																																																																																																																																																																																																																																																																																																																																																																																																																																																																																																																																																																																																																																																																																																																																																																																																																																													
423/E5	32				32																																																																																																																																																																																																																																																																																																																																																																																																																																																																																																																																																																																																																																																																																																																																																																																																																																																																																																																																																																																																																																																																																																																																																																																																																																																													
423/D5	33				33																																																																																																																																																																																																																																																																																																																																																																																																																																																																																																																																																																																																																																																																																																																																																																																																																																																																																																																																																																																																																																																																																																																																																																																																																																																													
423/D5	34				34																																																																																																																																																																																																																																																																																																																																																																																																																																																																																																																																																																																																																																																																																																																																																																																																																																																																																																																																																																																																																																																																																																																																																																																																																																																													
423/D5	35				35																																																																																																																																																																																																																																																																																																																																																																																																																																																																																																																																																																																																																																																																																																																																																																																																																																																																																																																																																																																																																																																																																																																																																																																																																																																													
SPARE	36				36																																																																																																																																																																																																																																																																																																																																																																																																																																																																																																																																																																																																																																																																																																																																																																																																																																																																																																																																																																																																																																																																																																																																																																																																																																																													
SPARE	37				37																																																																																																																																																																																																																																																																																																																																																																																																																																																																																																																																																																																																																																																																																																																																																																																																																																																																																																																																																																																																																																																																																																																																																																																																																																																													
SPARE	38				38																																																																																																																																																																																																																																																																																																																																																																																																																																																																																																																																																																																																																																																																																																																																																																																																																																																																																																																																																																																																																																																																																																																																																																																																																																																													
SPARE	39				39																																																																																																																																																																																																																																																																																																																																																																																																																																																																																																																																																																																																																																																																																																																																																																																																																																																																																																																																																																																																																																																																																																																																																																																																																																																													
SPARE	40				40																																																																																																																																																																																																																																																																																																																																																																																																																																																																																																																																																																																																																																																																																																																																																																																																																																																																																																																																																																																																																																																																																																																																																																																																																																																													
REFERENCE	X52 CON & PROTN CKTS																																																																																																																																																																																																																																																																																																																																																																																																																																																																																																																																																																																																																																																																																																																																																																																																																																																																																																																																																																																																																																																																																																																																																																																																																																																																	
416/B3	1				1																																																																																																																																																																																																																																																																																																																																																																																																																																																																																																																																																																																																																																																																																																																																																																																																																																																																																																																																																																																																																																																																																																																																																																																																																																																													
416/B3	2				2																																																																																																																																																																																																																																																																																																																																																																																																																																																																																																																																																																																																																																																																																																																																																																																																																																																																																																																																																																																																																																																																																																																																																																																																																																																													
429/D3	3				3																																																																																																																																																																																																																																																																																																																																																																																																																																																																																																																																																																																																																																																																																																																																																																																																																																																																																																																																																																																																																																																																																																																																																																																																																																																													
432/D4	4				4																																																																																																																																																																																																																																																																																																																																																																																																																																																																																																																																																																																																																																																																																																																																																																																																																																																																																																																																																																																																																																																																																																																																																																																																																																																													
432/D5	5				5																																																																																																																																																																																																																																																																																																																																																																																																																																																																																																																																																																																																																																																																																																																																																																																																																																																																																																																																																																																																																																																																																																																																																																																																																																																													
SPARE	6				6																																																																																																																																																																																																																																																																																																																																																																																																																																																																																																																																																																																																																																																																																																																																																																																																																																																																																																																																																																																																																																																																																																																																																																																																																																																													
SPARE	7				7																																																																																																																																																																																																																																																																																																																																																																																																																																																																																																																																																																																																																																																																																																																																																																																																																																																																																																																																																																																																																																																																																																																																																																																																																																																													
SPARE	8				8																																																																																																																																																																																																																																																																																																																																																																																																																																																																																																																																																																																																																																																																																																																																																																																																																																																																																																																																																																																																																																																																																																																																																																																																																																																													
436/D3	9				9																																																																																																																																																																																																																																																																																																																																																																																																																																																																																																																																																																																																																																																																																																																																																																																																																																																																																																																																																																																																																																																																																																																																																																																																																																																													
436/D3	10				10																																																																																																																																																																																																																																																																																																																																																																																																																																																																																																																																																																																																																																																																																																																																																																																																																																																																																																																																																																																																																																																																																																																																																																																																																																																													
433/D1	11				11																																																																																																																																																																																																																																																																																																																																																																																																																																																																																																																																																																																																																																																																																																																																																																																																																																																																																																																																																																																																																																																																																																																																																																																																																																																													
433/D2	12				12																																																																																																																																																																																																																																																																																																																																																																																																																																																																																																																																																																																																																																																																																																																																																																																																																																																																																																																																																																																																																																																																																																																																																																																																																																																													
433/D4	13				13																																																																																																																																																																																																																																																																																																																																																																																																																																																																																																																																																																																																																																																																																																																																																																																																																																																																																																																																																																																																																																																																																																																																																																																																																																																													
433/D5	14				14																																																																																																																																																																																																																																																																																																																																																																																																																																																																																																																																																																																																																																																																																																																																																																																																																																																																																																																																																																																																																																																																																																																																																																																																																																																													
433/D6	15				15																																																																																																																																																																																																																																																																																																																																																																																																																																																																																																																																																																																																																																																																																																																																																																																																																																																																																																																																																																																																																																																																																																																																																																																																																																																													
433/D7	16				16																																																																																																																																																																																																																																																																																																																																																																																																																																																																																																																																																																																																																																																																																																																																																																																																																																																																																																																																																																																																																																																																																																																																																																																																																																																													
434/D1	17				17																																																																																																																																																																																																																																																																																																																																																																																																																																																																																																																																																																																																																																																																																																																																																																																																																																																																																																																																																																																																																																																																																																																																																																																																																																																													
434/D2	18				18																																																																																																																																																																																																																																																																																																																																																																																																																																																																																																																																																																																																																																																																																																																																																																																																																																																																																																																																																																																																																																																																																																																																																																																																																																																													
434/D4	19				19																																																																																																																																																																																																																																																																																																																																																																																																																																																																																																																																																																																																																																																																																																																																																																																																																																																																																																																																																																																																																																																																																																																																																																																																																																																													
434/D5	20				20																																																																																																																																																																																																																																																																																																																																																																																																																																																																																																																																																																																																																																																																																																																																																																																																																																																																																																																																																																																																																																																																																																																																																																																																																																																													
434/D6	21				21																																																																																																																																																																																																																																																																																																																																																																																																																																																																																																																																																																																																																																																																																																																																																																																																																																																																																																																																																																																																																																																																																																																																																																																																																																																													
434/D7	22				22																																																																																																																																																																																																																																																																																																																																																																																																																																																																																																																																																																																																																																																																																																																																																																																																																																																																																																																																																																																																																																																																																																																																																																																																																																																													
435/D1	23				23																																																																																																																																																																																																																																																																																																																																																																																																																																																																																																																																																																																																																																																																																																																																																																																																																																																																																																																																																																																																																																																																																																																																																																																																																																																													
435/D2	24				24																																																																																																																																																																																																																																																																																																																																																																																																																																																																																																																																																																																																																																																																																																																																																																																																																																																																																																																																																																																																																																																																																																																																																																																																																																																													
435/D4	25				25																																																																																																																																																																																																																																																																																																																																																																																																																																																																																																																																																																																																																																																																																																																																																																																																																																																																																																																																																																																																																																																																																																																																																																																																																																																													
435/D5	26				26																																																																																																																																																																																																																																																																																																																																																																																																																																																																																																																																																																																																																																																																																																																																																																																																																																																																																																																																																																																																																																																																																																																																																																																																																																																													
435/D6	27				27																																																																																																																																																																																																																																																																																																																																																																																																																																																																																																																																																																																																																																																																																																																																																																																																																																																																																																																																																																																																																																																																																																																																																																																																																																																													
435/D7	28				28																																																																																																																																																																																																																																																																																																																																																																																																																																																																																																																																																																																																																																																																																																																																																																																																																																																																																																																																																																																																																																																																																																																																																																																																																																																													
436/D2	29				29																																																																																																																																																																																																																																																																																																																																																																																																																																																																																																																																																																																																																																																																																																																																																																																																																																																																																																																																																																																																																																																																																																																																																																																																																																																													
436/D2	30				30																																																																																																																																																																																																																																																																																																																																																																																																																																																																																																																																																																																																																																																																																																																																																																																																																																																																																																																																																																																																																																																																																																																																																																																																																																																													
491/A4	31				31																																																																																																																																																																																																																																																																																																																																																																																																																																																																																																																																																																																																																																																																																																																																																																																																																																																																																																																																																																																																																																																																																																																																																																																																																																																													
491/C4	32				32																																																																																																																																																																																																																																																																																																																																																																																																																																																																																																																																																																																																																																																																																																																																																																																																																																																																																																																																																																																																																																																																																																																																																																																																																																																													
491/D4	33				33																																																																																																																																																																																																																																																																																																																																																																																																																																																																																																																																																																																																																																																																																																																																																																																																																																																																																																																																																																																																																																																																																																																																																																																																																																																													
491/E4	34				34																																																																																																																																																																																																																																																																																																																																																																																																																																																																																																																																																																																																																																																																																																																																																																																																																																																																																																																																																																																																																																																																																																																																																																																																																																																													
491/B5	35				35																																																																																																																																																																																																																																																																																																																																																																																																																																																																																																																																																																																																																																																																																																																																																																																																																																																																																																																																																																																																																																																																																																																																																																																																																																																													
491/A6	36				36																																																																																																																																																																																																																																																																																																																																																																																																																																																																																																																																																																																																																																																																																																																																																																																																																																																																																																																																																																																																																																																																																																																																																																																																																																																													
491/C5	37				37																																																																																																																																																																																																																																																																																																																																																																																																																																																																																																																																																																																																																																																																																																																																																																																																																																																																																																																																																																																																																																																																																																																																																																																																																																																													
491/C6	38				38																																																																																																																																																																																																																																																																																																																																																																																																																																																																																																																																																																																																																																																																																																																																																																																																																																																																																																																																																																																																																																																																																																																																																																																																																																																													
SPARE	39				39																																																																																																																																																																																																																																																																																																																																																																																																																																																																																																																																																																																																																																																																																																																																																																																																																																																																																																																																																																																																																																																																																																																																																																																																																																																													
SPARE	40				40																																																																																																																																																																																																																																																																																																																																																																																																																																																																																																																																																																																																																																																																																																																																																																																																																																																																																																																																																																																																																																																																																																																																																																																																																																																													
491/A9	41				41																																																																																																																																																																																																																																																																																																																																																																																																																																																																																																																																																																																																																																																																																																																																																																																																																																																																																																																																																																																																																																																																																																																																																																																																																																																													
491/B9	42				42																																																																																																																																																																																																																																																																																																																																																																																																																																																																																																																																																																																																																																																																																																																																																																																																																																																																																																																																																																																																																																																																																																																																																																																																																																																													
492/E2	43				33																																																																																																																																																																																																																																																																																																																																																																																																																																																																																																																																																																																																																																																																																																																																																																																																																																																																																																																																																																																																																																																																																																																																																																																																																																																													
492/E2	44				44																																																																																																																																																																																																																																																																																																																																																																																																																																																																																																																																																																																																																																																																																																																																																																																																																																																																																																																																																																																																																																																																																																																																																																																																																																																													
492/E3	45				45																																																																																																																																																																																																																																																																																																																																																																																																																																																																																																																																																																																																																																																																																																																																																																																																																																																																																																																																																																																																																																																																																																																																																																																																																																																													
492/E4	46				46																																																																																																																																																																																																																																																																																																																																																																																																																																																																																																																																																																																																																																																																																																																																																																																																																																																																																																																																																																																																																																																																																																																																																																																																																																																													
492/E4	47				47																																																																																																																																																																																																																																																																																																																																																																																																																																																																																																																																																																																																																																																																																																																																																																																																																																																																																																																																																																																																																																																																																																																																																																																																																																																													
492/E5	48				48																																																																																																																																																																																																																																																																																																																																																																																																																																																																																																																																																																																																																																																																																																																																																																																																																																																																																																																																																																																																																																																																																																																																																																																																																																																													
492/E5	49				49																																																																																																																																																																																																																																																																																																																																																																																																																																																																																																																																																																																																																																																																																																																																																																																																																																																																																																																																																																																																																																																																																																																																																																																																																																																													
492/E6	50				50																																																																																																																																																																																																																																																																																																																																																																																																																																																																																																																																																																																																																																																																																																																																																																																																																																																																																																																																																																																																																																																																																																																																																																																																																																																													
REFERENCE	X52 CON & PROTN CKTS																																																																																																																																																																																																																																																																																																																																																																																																																																																																																																																																																																																																																																																																																																																																																																																																																																																																																																																																																																																																																																																																																																																																																																																																																																																																	
492/E7	51				51																																																																																																																																																																																																																																																																																																																																																																																																																																																																																																																																																																																																																																																																																																																																																																																																																																																																																																																																																																																																																																																																																																																																																																																																																																																													
492/E8	52				52																																																																																																																																																																																																																																																																																																																																																																																																																																																																																																																																																																																																																																																																																																																																																																																																																																																																																																																																																																																																																																																																																																																																																																																																																																																													
492/E9	53				53																																																																																																																																																																																																																																																																																																																																																																																																																																																																																																																																																																																																																																																																																																																																																																																																																																																																																																																																																																																																																																																																																																																																																																																																																																																													
492/E10	54				54																																																																																																																																																																																																																																																																																																																																																																																																																																																																																																																																																																																																																																																																																																																																																																																																																																																																																																																																																																																																																																																																																																																																																																																																																																																													
SPARE	55				55																																																																																																																																																																																																																																																																																																																																																																																																																																																																																																																																																																																																																																																																																																																																																																																																																																																																																																																																																																																																																																																																																																																																																																																																																																																													
SPARE	56				556																																																																																																																																																																																																																																																																																																																																																																																																																																																																																																																																																																																																																																																																																																																																																																																																																																																																																																																																																																																																																																																																																																																																																																																																																																																													
493/E5	57				57																																																																																																																																																																																																																																																																																																																																																																																																																																																																																																																																																																																																																																																																																																																																																																																																																																																																																																																																																																																																																																																																																																																																																																																																																																																													
493/E5	58				58																																																																																																																																																																																																																																																																																																																																																																																																																																																																																																																																																																																																																																																																																																																																																																																																																																																																																																																																																																																																																																																																																																																																																																																																																																																													
493/E7	59				59																																																																																																																																																																																																																																																																																																																																																																																																																																																																																																																																																																																																																																																																																																																																																																																																																																																																																																																																																																																																																																																																																																																																																																																																																																																													
493/E7	60				60																																																																																																																																																																																																																																																																																																																																																																																																																																																																																																																																																																																																																																																																																																																																																																																																																																																																																																																																																																																																																																																																																																																																																																																																																																																													
494/E3	61				61																																																																																																																																																																																																																																																																																																																																																																																																																																																																																																																																																																																																																																																																																																																																																																																																																																																																																																																																																																																																																																																																																																																																																																																																																																																													
494/E4	62				62																																																																																																																																																																																																																																																																																																																																																																																																																																																																																																																																																																																																																																																																																																																																																																																																																																																																																																																																																																																																																																																																																																																																																																																																																																																													
494/E4	63				63																																																																																																																																																																																																																																																																																																																																																																																																																																																																																																																																																																																																																																																																																																																																																																																																																																																																																																																																																																																																																																																																																																																																																																																																																																																													
494/E5	64				64																																																																																																																																																																																																																																																																																																																																																																																																																																																																																																																																																																																																																																																																																																																																																																																																																																																																																																																																																																																																																																																																																																																																																																																																																																																													
494/E5	65				65																																																																																																																																																																																																																																																																																																																																																																																																																																																																																																																																																																																																																																																																																																																																																																																																																																																																																																																																																																																																																																																																																																																																																																																																																																																													
494/E6	66				66																																																																																																																																																																																																																																																																																																																																																																																																																																																																																																																																																																																																																																																																																																																																																																																																																																																																																																																																																																																																																																																																																																																																																																																																																																																													
494/E5	67				67																																																																																																																																																																																																																																																																																																																																																																																																																																																																																																																																																																																																																																																																																																																																																																																																																																																																																																																																																																																																																																																																																																																																																																																																																																																													
494/E7	68				68																																																																																																																																																																																																																																																																																																																																																																																																																																																																																																																																																																																																																																																																																																																																																																																																																																																																																																																																																																																																																																																																																																																																																																																																																																																													
494/E7	69				69																																																																																																																																																																																																																																																																																																																																																																																																																																																																																																																																																																																																																																																																																																																																																																																																																																																																																																																																																																																																																																																																																																																																																																																																																																																													
494/E7	70				70																																																																																																																																																																																																																																																																																																																																																																																																																																																																																																																																																																																																																																																																																																																																																																																																																																																																																																																																																																																																																																																																																																																																																																																																																																																													
494/E8	71				71																																																																																																																																																																																																																																																																																																																																																																																																																																																																																																																																																																																																																																																																																																																																																																																																																																																																																																																																																																																																																																																																																																																																																																																																																																																													
494/E9	72				72																																																																																																																																																																																																																																																																																																																																																																																																																																																																																																																																																																																																																																																																																																																																																																																																																																																																																																																																																																																																																																																																																																																																																																																																																																																													
494/E10	73				73																																																																																																																																																																																																																																																																																																																																																																																																																																																																																																																																																																																																																																																																																																																																																																																																																																																																																																																																																																																																																																																																																																																																																																																																																																																													
494/E9	74				74																																																																																																																																																																																																																																																																																																																																																																																																																																																																																																																																																																																																																																																																																																																																																																																																																																																																																																																																																																																																																																																																																																																																																																																																																																																													
495/B2	75				75																																																																																																																																																																																																																																																																																																																																																																																																																																																																																																																																																																																																																																																																																																																																																																																																																																																																																																																																																																																																																																																																																																																																																																																																																																																													
495/E2	76				76																																																																																																																																																																																																																																																																																																																																																																																																																																																																																																																																																																																																																																																																																																																																																																																																																																																																																																																																																																																																																																																																																																																																																																																																																																																													
495/B4	77				77																																																																																																																																																																																																																																																																																																																																																																																																																																																																																																																																																																																																																																																																																																																																																																																																																																																																																																																																																																																																																																																																																																																																																																																																																																																													
495/E4	78				78																																																																																																																																																																																																																																																																																																																																																																																																																																																																																																																																																																																																																																																																																																																																																																																																																																																																																																																																																																																																																																																																																																																																																																																																																																																													
495/B5	79				79																																																																																																																																																																																																																																																																																																																																																																																																																																																																																																																																																																																																																																																																																																																																																																																																																																																																																																																																																																																																																																																																																																																																																																																																																																																													
495/E5	80				80																																																																																																																																																																																																																																																																																																																																																																																																																																																																																																																																																																																																																																																																																																																																																																																																																																																																																																																																																																																																																																																																																																																																																																																																																																																													
495/B7	81				81																																																																																																																																																																																																																																																																																																																																																																																																																																																																																																																																																																																																																																																																																																																																																																																																																																																																																																																																																																																																																																																																																																																																																																																																																																																													
495/E7	82				88																																																																																																																																																																																																																																																																																																																																																																																																																																																																																																																																																																																																																																																																																																																																																																																																																																																																																																																																																																																																																																																																																																																																																																																																																																																													
SPARE	83				83																																																																																																																																																																																																																																																																																																																																																																																																																																																																																																																																																																																																																																																																																																																																																																																																																																																																																																																																																																																																																																																																																																																																																																																																																																																													
SPARE	84				84																																																																																																																																																																																																																																																																																																																																																																																																																																																																																																																																																																																																																																																																																																																																																																																																																																																																																																																																																																																																																																																																																																																																																																																																																																																													
SPARE	85				85																																																																																																																																																																																																																																																																																																																																																																																																																																																																																																																																																																																																																																																																																																																																																																																																																																																																																																																																																																																																																																																																																																																																																																																																																																																													
SPARE	86				86																																																																																																																																																																																																																																																																																																																																																																																																																																																																																																																																																																																																																																																																																																																																																																																																																																																																																																																																																																																																																																																																																																																																																																																																																																																													
SPARE	87				87																																																																																																																																																																																																																																																																																																																																																																																																																																																																																																																																																																																																																																																																																																																																																																																																																																																																																																																																																																																																																																																																																																																																																																																																																																																													
SPARE	88				88																																																																																																																																																																																																																																																																																																																																																																																																																																																																																																																																																																																																																																																																																																																																																																																																																																																																																																																																																																																																																																																																																																																																																																																																																																																													
SPARE	89				89																																																																																																																																																																																																																																																																																																																																																																																																																																																																																																																																																																																																																																																																																																																																																																																																																																																																																																																																																																																																																																																																																																																																																																																																																																																													
SPARE	90				90																																																																																																																																																																																																																																																																																																																																																																																																																																																																																																																																																																																																																																																																																																																																																																																																																																																																																																																																																																																																																																																																																																																																																																																																																																																													
REFERENCE	X42 DC CKTS.																																																																																																																																																																																																																																																																																																																																																																																																																																																																																																																																																																																																																																																																																																																																																																																																																																																																																																																																																																																																																																																																																																																																																																																																																																																																	
416/B3	1				1																																																																																																																																																																																																																																																																																																																																																																																																																																																																																																																																																																																																																																																																																																																																																																																																																																																																																																																																																																																																																																																																																																																																																																																																																																																													
416/B3	2				2																																																																																																																																																																																																																																																																																																																																																																																																																																																																																																																																																																																																																																																																																																																																																																																																																																																																																																																																																																																																																																																																																																																																																																																																																																																													
416/C3	3				3																																																																																																																																																																																																																																																																																																																																																																																																																																																																																																																																																																																																																																																																																																																																																																																																																																																																																																																																																																																																																																																																																																																																																																																																																																																													
416/C3	4				4																																																																																																																																																																																																																																																																																																																																																																																																																																																																																																																																																																																																																																																																																																																																																																																																																																																																																																																																																																																																																																																																																																																																																																																																																																																													
416/D3	5				5																																																																																																																																																																																																																																																																																																																																																																																																																																																																																																																																																																																																																																																																																																																																																																																																																																																																																																																																																																																																																																																																																																																																																																																																																																																													
416/D3	6				6																																																																																																																																																																																																																																																																																																																																																																																																																																																																																																																																																																																																																																																																																																																																																																																																																																																																																																																																																																																																																																																																																																																																																																																																																																																													
429/B3	7				7																																																																																																																																																																																																																																																																																																																																																																																																																																																																																																																																																																																																																																																																																																																																																																																																																																																																																																																																																																																																																																																																																																																																																																																																																																																													
SPARE	8				8																																																																																																																																																																																																																																																																																																																																																																																																																																																																																																																																																																																																																																																																																																																																																																																																																																																																																																																																																																																																																																																																																																																																																																																																																																																													
SPARE	9				9																																																																																																																																																																																																																																																																																																																																																																																																																																																																																																																																																																																																																																																																																																																																																																																																																																																																																																																																																																																																																																																																																																																																																																																																																																																													
SPARE	10				10																																																																																																																																																																																																																																																																																																																																																																																																																																																																																																																																																																																																																																																																																																																																																																																																																																																																																																																																																																																																																																																																																																																																																																																																																																																													
432/A4	11				11																																																																																																																																																																																																																																																																																																																																																																																																																																																																																																																																																																																																																																																																																																																																																																																																																																																																																																																																																																																																																																																																																																																																																																																																																																																													
432/A5	12				12																																																																																																																																																																																																																																																																																																																																																																																																																																																																																																																																																																																																																																																																																																																																																																																																																																																																																																																																																																																																																																																																																																																																																																																																																																																													
433/B2	13				13																																																																																																																																																																																																																																																																																																																																																																																																																																																																																																																																																																																																																																																																																																																																																																																																																																																																																																																																																																																																																																																																																																																																																																																																																																																													
436/B2	14				14																																																																																																																																																																																																																																																																																																																																																																																																																																																																																																																																																																																																																																																																																																																																																																																																																																																																																																																																																																																																																																																																																																																																																																																																																																																													
432/A1	15				15																																																																																																																																																																																																																																																																																																																																																																																																																																																																																																																																																																																																																																																																																																																																																																																																																																																																																																																																																																																																																																																																																																																																																																																																																																																													
SPARE	16				16																																																																																																																																																																																																																																																																																																																																																																																																																																																																																																																																																																																																																																																																																																																																																																																																																																																																																																																																																																																																																																																																																																																																																																																																																																																													
SPARE	17				17																																																																																																																																																																																																																																																																																																																																																																																																																																																																																																																																																																																																																																																																																																																																																																																																																																																																																																																																																																																																																																																																																																																																																																																																																																																													
437/B4	18				18																																																																																																																																																																																																																																																																																																																																																																																																																																																																																																																																																																																																																																																																																																																																																																																																																																																																																																																																																																																																																																																																																																																																																																																																																																																													
437/B4	19				19																																																																																																																																																																																																																																																																																																																																																																																																																																																																																																																																																																																																																																																																																																																																																																																																																																																																																																																																																																																																																																																																																																																																																																																																																																																													
SPARE	20				20																																																																																																																																																																																																																																																																																																																																																																																																																																																																																																																																																																																																																																																																																																																																																																																																																																																																																																																																																																																																																																																																																																																																																																																																																																																													
REFERENCE	X53 CON & PROTN CKTS																																																																																																																																																																																																																																																																																																																																																																																																																																																																																																																																																																																																																																																																																																																																																																																																																																																																																																																																																																																																																																																																																																																																																																																																																																																																	
498/E1	1				1																																																																																																																																																																																																																																																																																																																																																																																																																																																																																																																																																																																																																																																																																																																																																																																																																																																																																																																																																																																																																																																																																																																																																																																																																																																													
498/E1	2				2																																																																																																																																																																																																																																																																																																																																																																																																																																																																																																																																																																																																																																																																																																																																																																																																																																																																																																																																																																																																																																																																																																																																																																																																																																																													
498/E2	3				3																																																																																																																																																																																																																																																																																																																																																																																																																																																																																																																																																																																																																																																																																																																																																																																																																																																																																																																																																																																																																																																																																																																																																																																																																																																													
498/E2	4				4																																																																																																																																																																																																																																																																																																																																																																																																																																																																																																																																																																																																																																																																																																																																																																																																																																																																																																																																																																																																																																																																																																																																																																																																																																																													
498/E2	5				5																																																																																																																																																																																																																																																																																																																																																																																																																																																																																																																																																																																																																																																																																																																																																																																																																																																																																																																																																																																																																																																																																																																																																																																																																																																													
498/E3	6				6																																																																																																																																																																																																																																																																																																																																																																																																																																																																																																																																																																																																																																																																																																																																																																																																																																																																																																																																																																																																																																																																																																																																																																																																																																																													
498/E3	7				7																																																																																																																																																																																																																																																																																																																																																																																																																																																																																																																																																																																																																																																																																																																																																																																																																																																																																																																																																																																																																																																																																																																																																																																																																																																													
498/E4	8				8																																																																																																																																																																																																																																																																																																																																																																																																																																																																																																																																																																																																																																																																																																																																																																																																																																																																																																																																																																																																																																																																																																																																																																																																																																																													
498/E4	9				9																																																																																																																																																																																																																																																																																																																																																																																																																																																																																																																																																																																																																																																																																																																																																																																																																																																																																																																																																																																																																																																																																																																																																																																																																																																													
498/E4	10				10																																																																																																																																																																																																																																																																																																																																																																																																																																																																																																																																																																																																																																																																																																																																																																																																																																																																																																																																																																																																																																																																																																																																																																																																																																																													
498/E5	11				11																																																																																																																																																																																																																																																																																																																																																																																																																																																																																																																																																																																																																																																																																																																																																																																																																																																																																																																																																																																																																																																																																																																																																																																																																																																													
498/E5	12				12																																																																																																																																																																																																																																																																																																																																																																																																																																																																																																																																																																																																																																																																																																																																																																																																																																																																																																																																																																																																																																																																																																																																																																																																																																																													
498/E6	13				13																																																																																																																																																																																																																																																																																																																																																																																																																																																																																																																																																																																																																																																																																																																																																																																																																																																																																																																																																																																																																																																																																																																																																																																																																																																													
498/E6	14				14																																																																																																																																																																																																																																																																																																																																																																																																																																																																																																																																																																																																																																																																																																																																																																																																																																																																																																																																																																																																																																																																																																																																																																																																																																																													
498/E6	15				15																																																																																																																																																																																																																																																																																																																																																																																																																																																																																																																																																																																																																																																																																																																																																																																																																																																																																																																																																																																																																																																																																																																																																																																																																																																													
498/E7	16				16																																																																																																																																																																																																																																																																																																																																																																																																																																																																																																																																																																																																																																																																																																																																																																																																																																																																																																																																																																																																																																																																																																																																																																																																																																																													
498/E7	17				17																																																																																																																																																																																																																																																																																																																																																																																																																																																																																																																																																																																																																																																																																																																																																																																																																																																																																																																																																																																																																																																																																																																																																																																																																																																													
498/E8	18				18																																																																																																																																																																																																																																																																																																																																																																																																																																																																																																																																																																																																																																																																																																																																																																																																																																																																																																																																																																																																																																																																																																																																																																																																																																																													
498/E8	19				19																																																																																																																																																																																																																																																																																																																																																																																																																																																																																																																																																																																																																																																																																																																																																																																																																																																																																																																																																																																																																																																																																																																																																																																																																																																													
498/E8	20				20																																																																																																																																																																																																																																																																																																																																																																																																																																																																																																																																																																																																																																																																																																																																																																																																																																																																																																																																																																																																																																																																																																																																																																																																																																																													
498/E8	21				21																																																																																																																																																																																																																																																																																																																																																																																																																																																																																																																																																																																																																																																																																																																																																																																																																																																																																																																																																																																																																																																																																																																																																																																																																																																													
498/E9	22				22																																																																																																																																																																																																																																																																																																																																																																																																																																																																																																																																																																																																																																																																																																																																																																																																																																																																																																																																																																																																																																																																																																																																																																																																																																																													
498/E10	23				23																																																																																																																																																																																																																																																																																																																																																																																																																																																																																																																																																																																																																																																																																																																																																																																																																																																																																																																																																																																																																																																																																																																																																																																																																																																													
498/E10	24				24																																																																																																																																																																																																																																																																																																																																																																																																																																																																																																																																																																																																																																																																																																																																																																																																																																																																																																																																																																																																																																																																																																																																																																																																																																																													
SPARE	25				25																																																																																																																																																																																																																																																																																																																																																																																																																																																																																																																																																																																																																																																																																																																																																																																																																																																																																																																																																																																																																																																																																																																																																																																																																																																													
SPARE	26				26																																																																																																																																																																																																																																																																																																																																																																																																																																																																																																																																																																																																																																																																																																																																																																																																																																																																																																																																																																																																																																																																																																																																																																																																																																																													
SPARE	27				27																																																																																																																																																																																																																																																																																																																																																																																																																																																																																																																																																																																																																																																																																																																																																																																																																																																																																																																																																																																																																																																																																																																																																																																																																																																													
SPARE	28				28																																																																																																																																																																																																																																																																																																																																																																																																																																																																																																																																																																																																																																																																																																																																																																																																																																																																																																																																																																																																																																																																																																																																																																																																																																																													
SPARE	29				29																																																																																																																																																																																																																																																																																																																																																																																																																																																																																																																																																																																																																																																																																																																																																																																																																																																																																																																																																																																																																																																																																																																																																																																																																																																													
SPARE	30				30																																																																																																																																																																																																																																																																																																																																																																																																																																																																																																																																																																																																																																																																																																																																																																																																																																																																																																																																																																																																																																																																																																																																																																																																																																																													
SPARE	31				31																																																																																																																																																																																																																																																																																																																																																																																																																																																																																																																																																																																																																																																																																																																																																																																																																																																																																																																																																																																																																																																																																																																																																																																																																																																													
SPARE	32				32																																																																																																																																																																																																																																																																																																																																																																																																																																																																																																																																																																																																																																																																																																																																																																																																																																																																																																																																																																																																																																																																																																																																																																																																																																																													
SPARE	33				33																																																																																																																																																																																																																																																																																																																																																																																																																																																																																																																																																																																																																																																																																																																																																																																																																																																																																																																																																																																																																																																																																																																																																																																																																																																													
SPARE	34				34																																																																																																																																																																																																																																																																																																																																																																																																																																																																																																																																																																																																																																																																																																																																																																																																																																																																																																																																																																																																																																																																																																																																																																																																																																																													
SPARE	35				35																																																																																																																																																																																																																																																																																																																																																																																																																																																																																																																																																																																																																																																																																																																																																																																																																																																																																																																																																																																																																																																																																																																																																																																																																																																													
SPARE	36				36																																																																																																																																																																																																																																																																																																																																																																																																																																																																																																																																																																																																																																																																																																																																																																																																																																																																																																																																																																																																																																																																																																																																																																																																																																																													
SPARE	37				37																																																																																																																																																																																																																																																																																																																																																																																																																																																																																																																																																																																																																																																																																																																																																																																																																																																																																																																																																																																																																																																																																																																																																																																																																																																													
SPARE	38				38																																																																																																																																																																																																																																																																																																																																																																																																																																																																																																																																																																																																																																																																																																																																																																																																																																																																																																																																																																																																																																																																																																																																																																																																																																																													
SPARE	39				39																																																																																																																																																																																																																																																																																																																																																																																																																																																																																																																																																																																																																																																																																																																																																																																																																																																																																																																																																																																																																																																																																																																																																																																																																																																													
SPARE	40				40																																																																																																																																																																																																																																																																																																																																																																																																																																																																																																																																																																																																																																																																																																																																																																																																																																																																																																																																																																																																																																																																																																																																																																																																																																																													
G	AS-BUILT BY _____ DATE _____		CONTRACT NO. 11131113/00		JOB ORDER NO. S-13656		TERMINAL BLOCK REFERENCE		<div>نقل الكهرباء</div> <div>National Grid sa</div> <div>الشركة الوطنية لنقل الكهرباء</div>																																																																																																																																																																																																																																																																																																																																																																																																																																																																																																																																																																																																																																																																																																																																																																																																																																																																																																																																																																																																																																																																																																																																																																																																																																																									
			DRAWN BY <u>  RIZ  </u> CHECKED BY <u>  JKR  </u>		132/13.8kV GT-1 RELAY PANEL-2 +R05.2																																																																																																																																																																																																																																																																																																																																																																																																																																																																																																																																																																																																																																																																																																																																																																																																																																																																																																																																																																																																																																																																																																																																																																																																																																																													
		01	13 49	FACTORY ASBUILT		DATE STARTED <u>24.01.2013</u> DATE COMPLETED _____		S/S 8709-132/13.8KV IN AL-KHARJ CITY		INDEX	PLANT NO.	DRAWING NUMBER		SHEET NO.		REV. NO.																																																																																																																																																																																																																																																																																																																																																																																																																																																																																																																																																																																																																																																																																																																																																																																																																																																																																																																																																																																																																																																																																																																																																																																																																																																		
		00	13 04	FOR APPROVAL		OPRG. DEPT. <u>  CTPD  </u> ENG. DEPT. <u>  AUT-PSAC  </u>		RIYADH SAUDI ARABIA		-	C421	CD-322928		SHT 506		CONT. 507		01																																																																																																																																																																																																																																																																																																																																																																																																																																																																																																																																																																																																																																																																																																																																																																																																																																																																																																																																																																																																																																																																																																																																																																																																																																																
	REV. NO.	DATE	DESCRIPTION																																																																																																																																																																																																																																																																																																																																																																																																																																																																																																																																																																																																																																																																																																																																																																																																																																																																																																																																																																																																																																																																																																																																																																																																																																																															

	1	2	3	4	5	6	7	8	9	10			
A													
B	REFERENCE	X62 ALARM CKT	REFERENCE	X92 SPARE									
	414/B3	1	499/C6	1									
	414/B4	2	499/B6	2									
	498/E1	3	499/C7	3									
	498/E2	4	499/B7	4									
	498/E2	5	499/C8	5									
	498/E3	6	499/B8	6									
	498/E3	7	499/C8	7									
	498/E4	8	499/B8	8									
	498/E4	9	499/C8	9									
	SPARE	10	499/B8	10									
	SPARE	11	499/C9	11									
	SPARE	12	499/B9	12									
	SPARE	13	SPARE	13									
	SPARE	14	SPARE	14									
	SPARE	15	SPARE	15									
	SPARE	16	SPARE	16									
	SPARE	17	SPARE	17									
	SPARE	18	SPARE	18									
	SPARE	19	SPARE	19									
SPARE	20	SPARE	20										
C													
	D												
E													
	F												
G		AS-BUILT BY _____ DATE _____		CONTRACT NO. 11131113/00		JOB ORDER NO. S-13656		TERMINAL BLOCK REFERENCE		<div>الشركة الوطنية لنقل الكهرباء</div> <div>National Grid sa</div>			
								132/13.8kV GT-1 RELAY PANEL-2 +R05.2					
	01	13 49	FACTORY ASBUILT		DRAWN BY RIZ CHECKED BY JKR		S/S 8709-132/13.8KV IN AL-KHARJ CITY		INDEX	PLANT NO.	DRAWING NUMBER	SHEET NO.	REV. NO.
	00	13 04	FOR APPROVAL		DATE STARTED 24.01.2013 DATE COMPLETED		RIYADH SAUDI ARABIA		-	C421	CD-322928	SHT	CONT.
	REV. NO.	DATE	DESCRIPTION		OPRG. DEPT. CTPD ENG. DEPT. AUT-PSAC							507	NIL